


676

4556

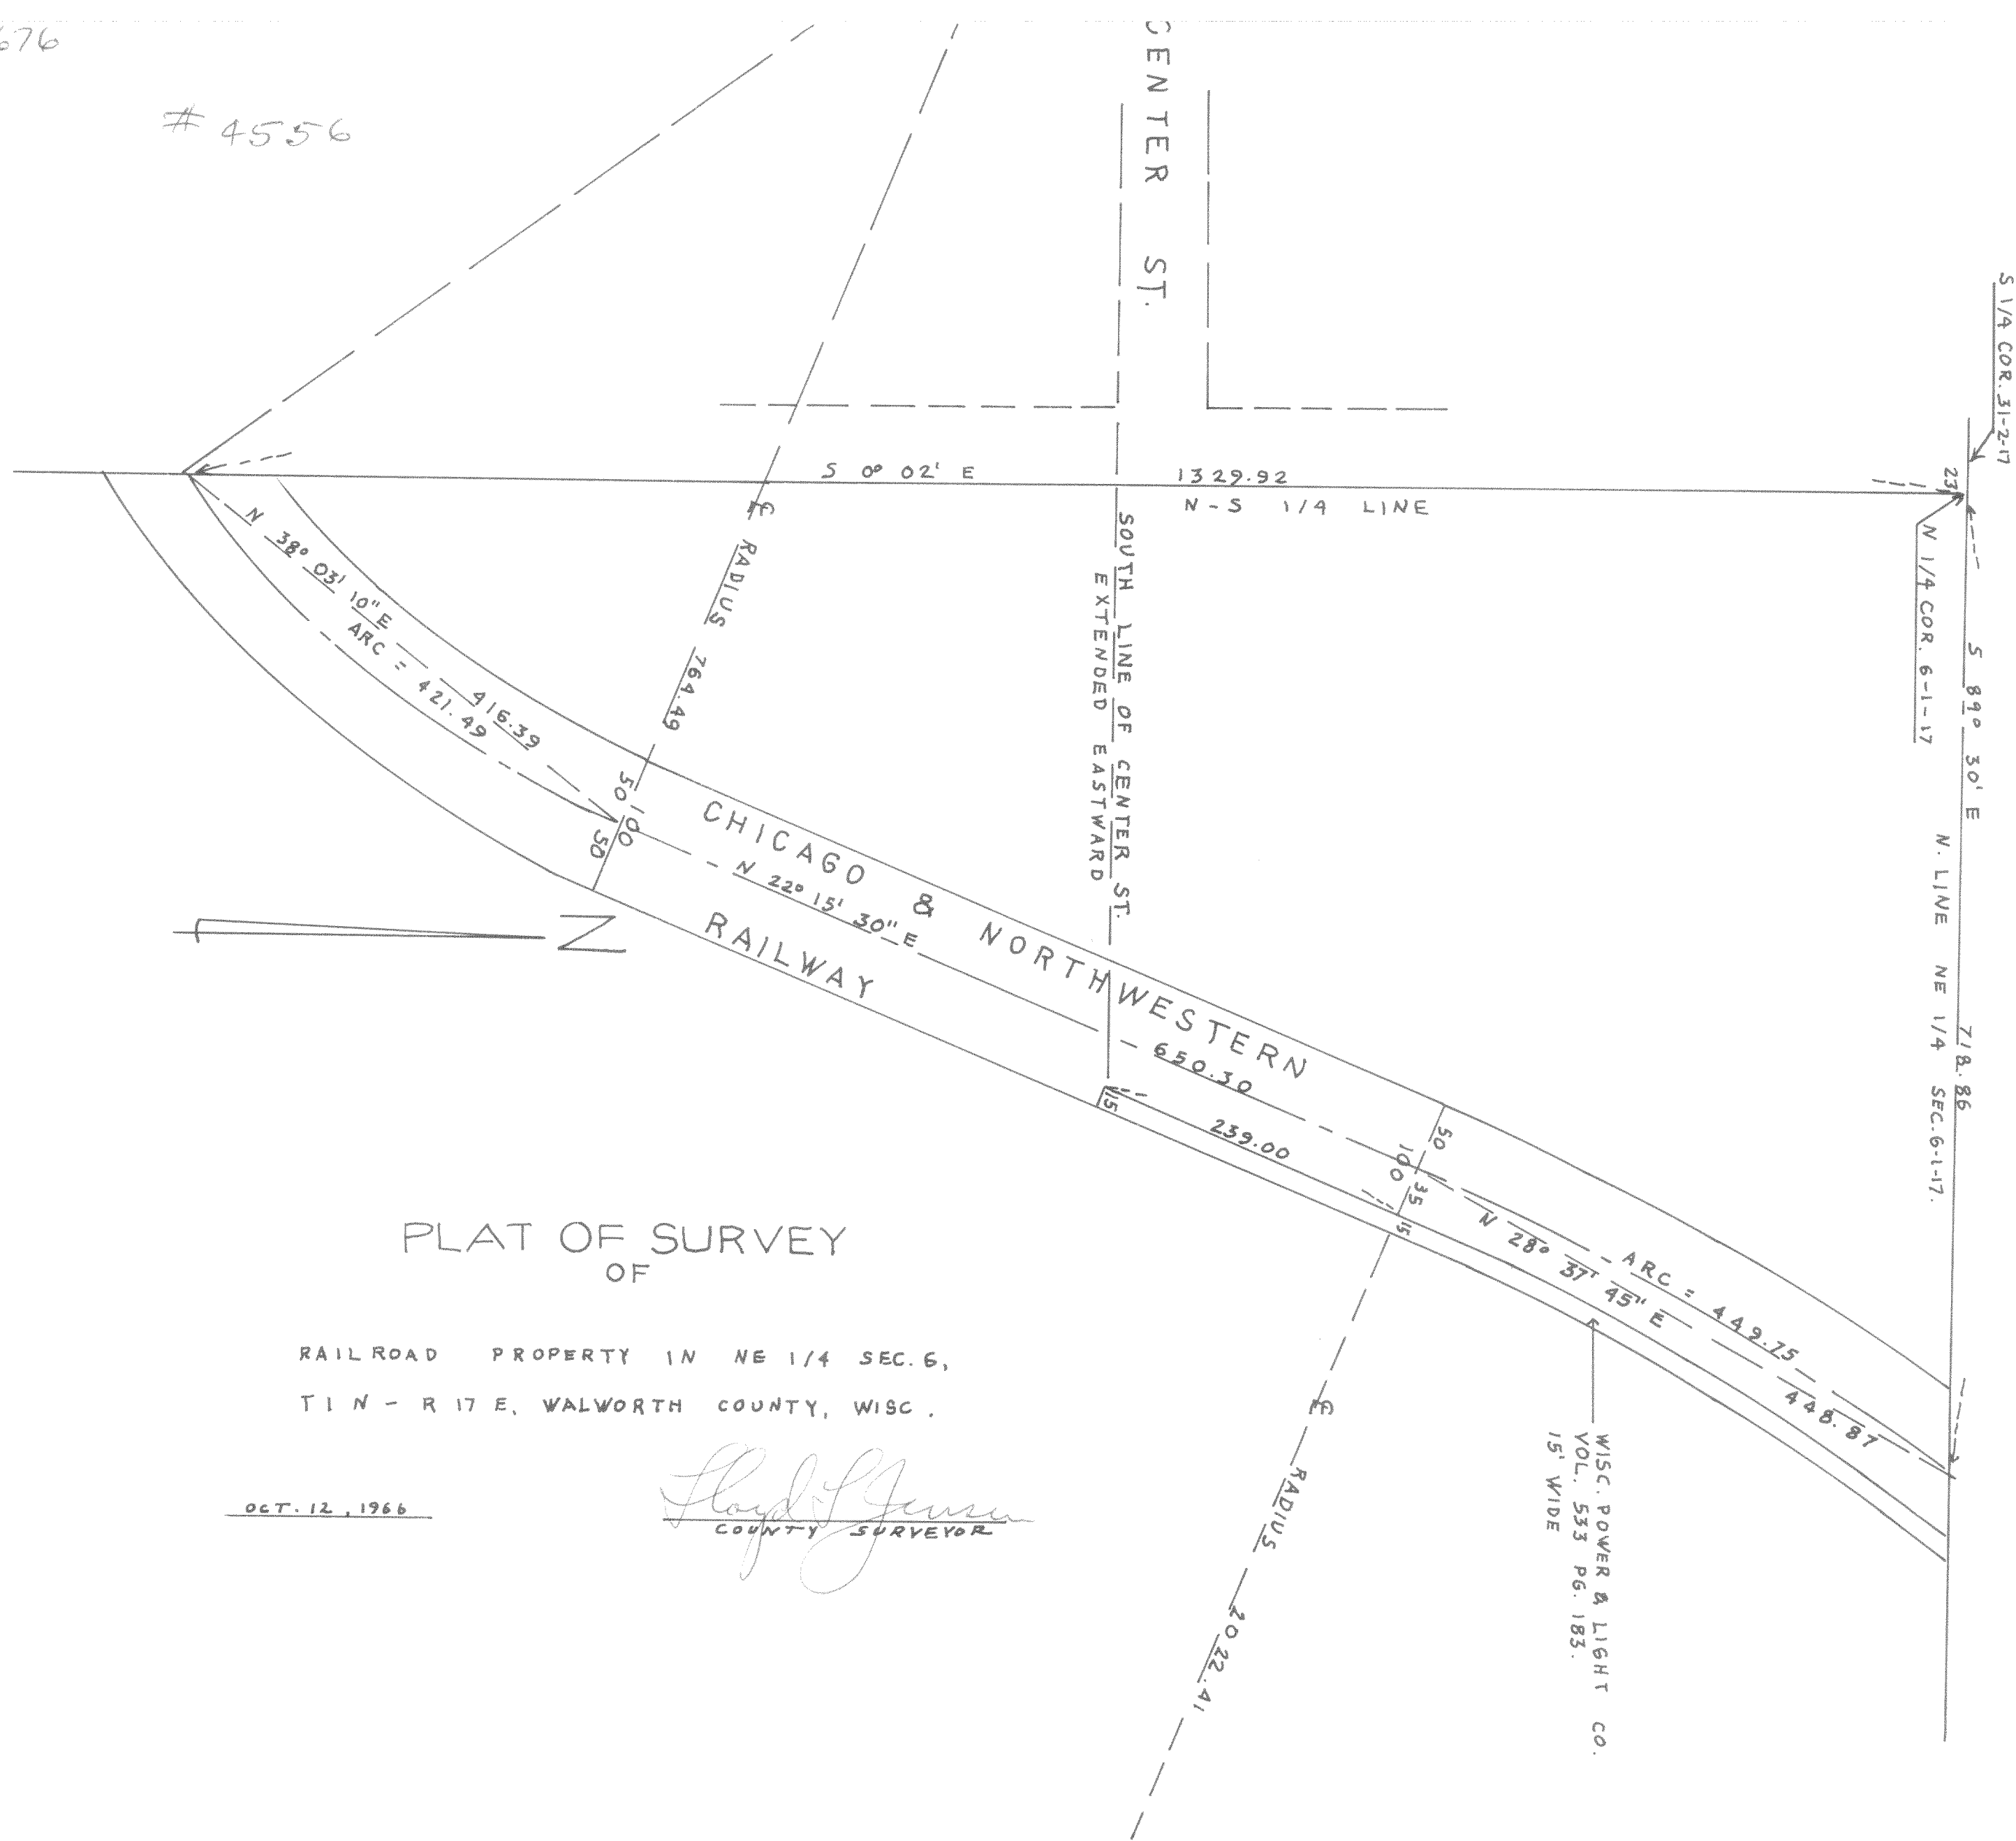

PLAT OF SURVEY OF

RAILROAD PROPERTY IN NE 1/4 SEC. 6, T1N - R17E, WALWORTH COUNTY, WISC.

OCT. 12, 1966

Floyd Jensen
COUNTY SURVEYOR