


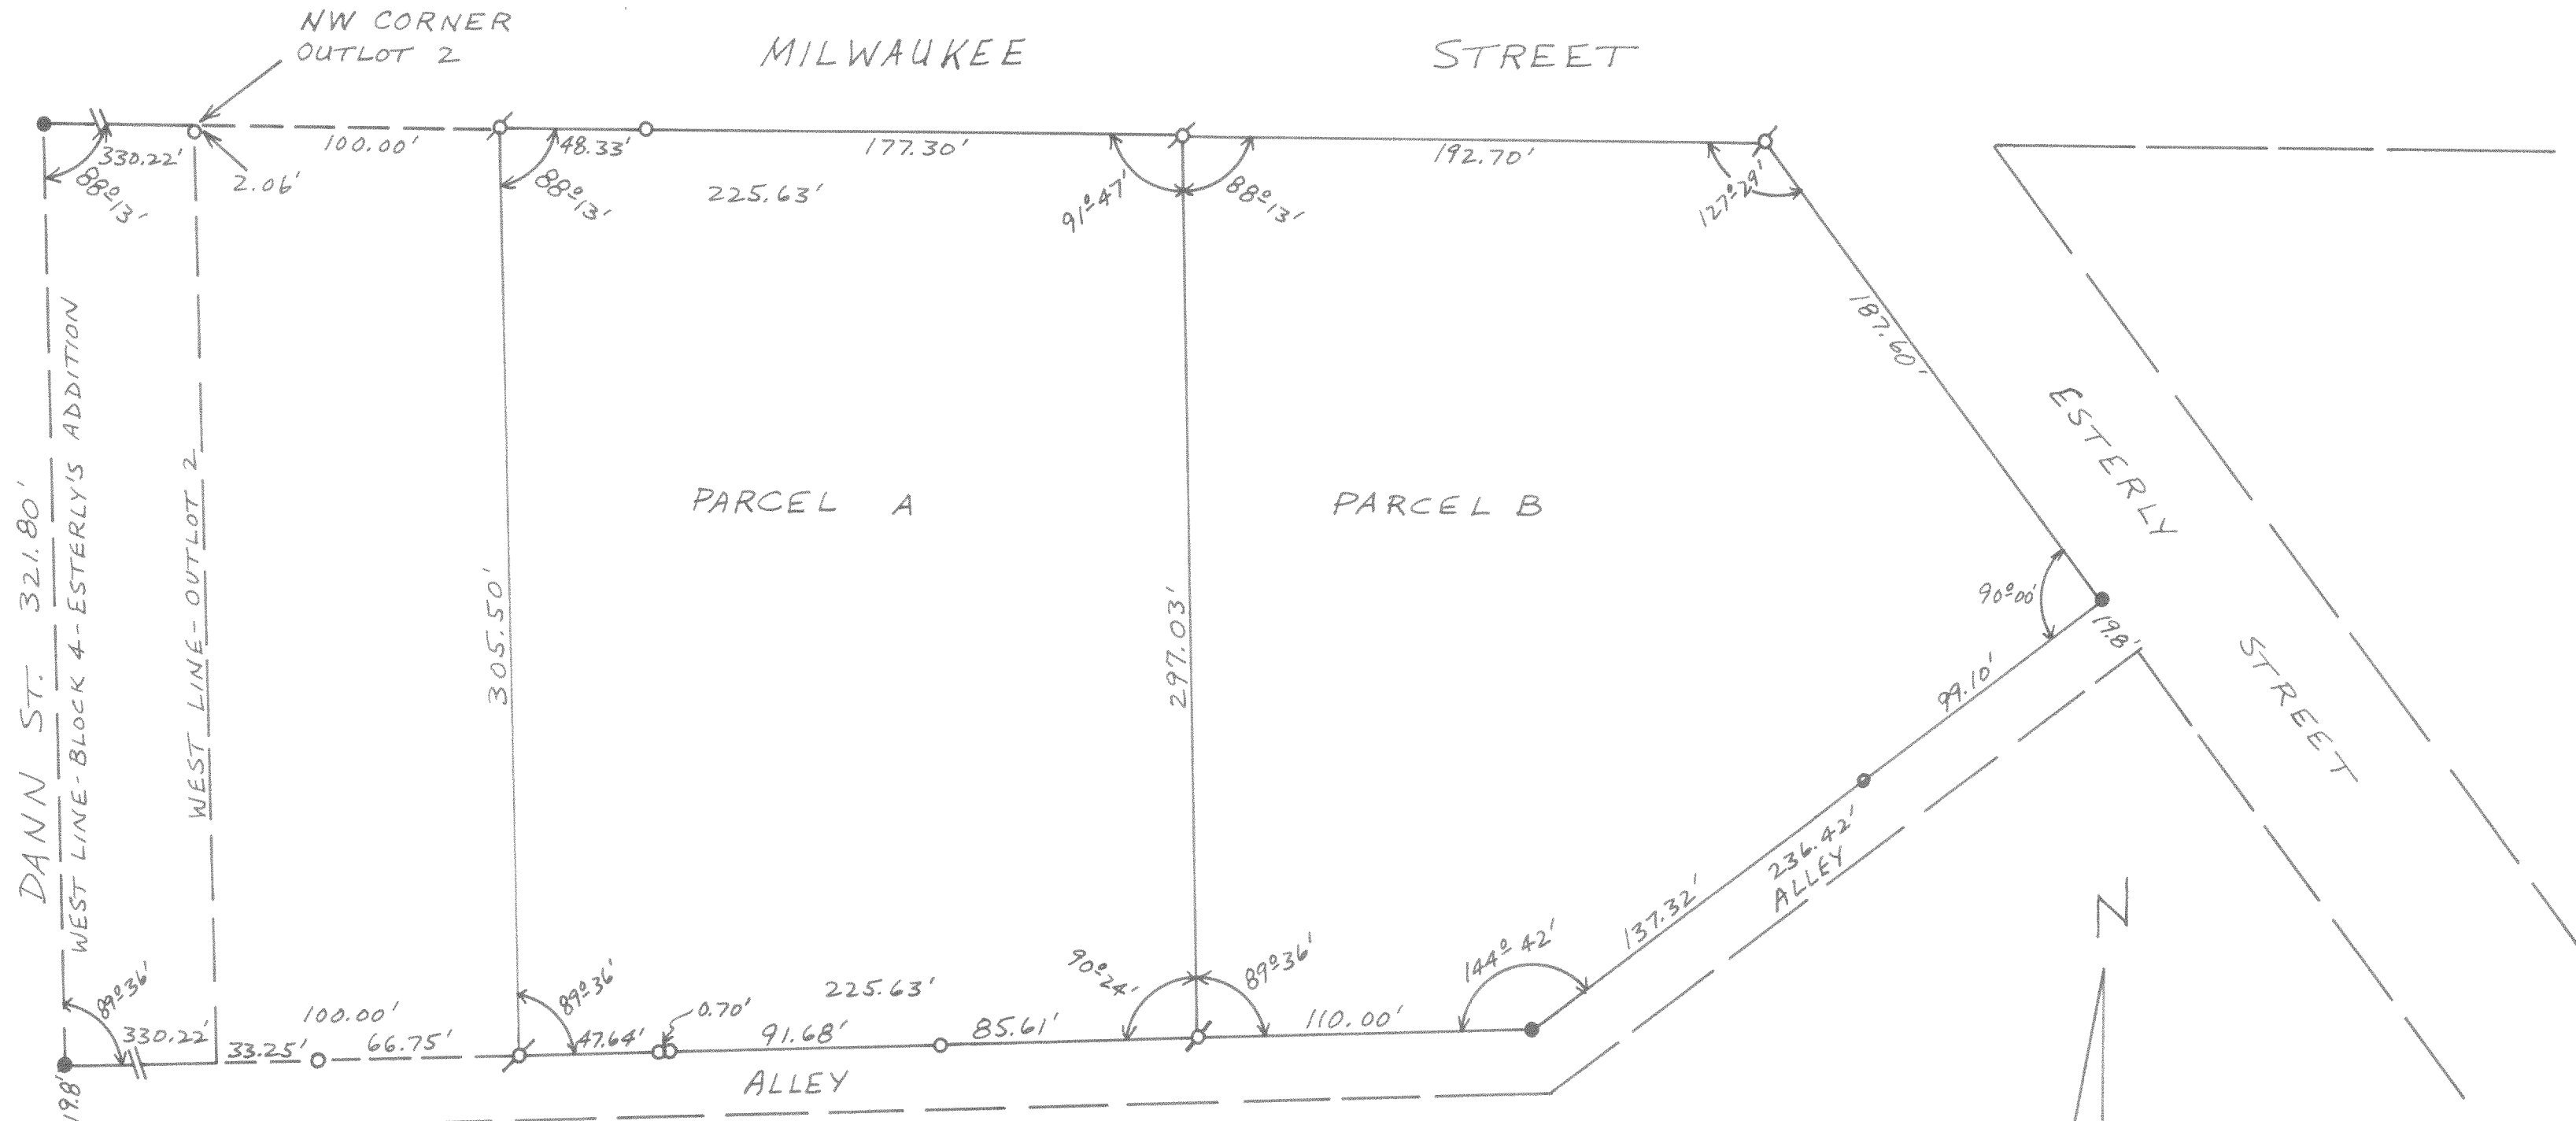

- - ROUND CONCRETE FOUND
- ⊕ - IRON PIPE FOUND
- - IRON PIPE SET

PLAT OF SURVEY OF

OUTLOT 2 ESTERLY'S
ADDITION TO CITY OF
WHITEWATER, SE 1/4 SEC.
4, T4N R15E, WALWORTH
COUNTY, WISCONSIN

4567

JAN. 9, 1969

Floyd Jensen
COUNTY SURVEYOR