



#2929

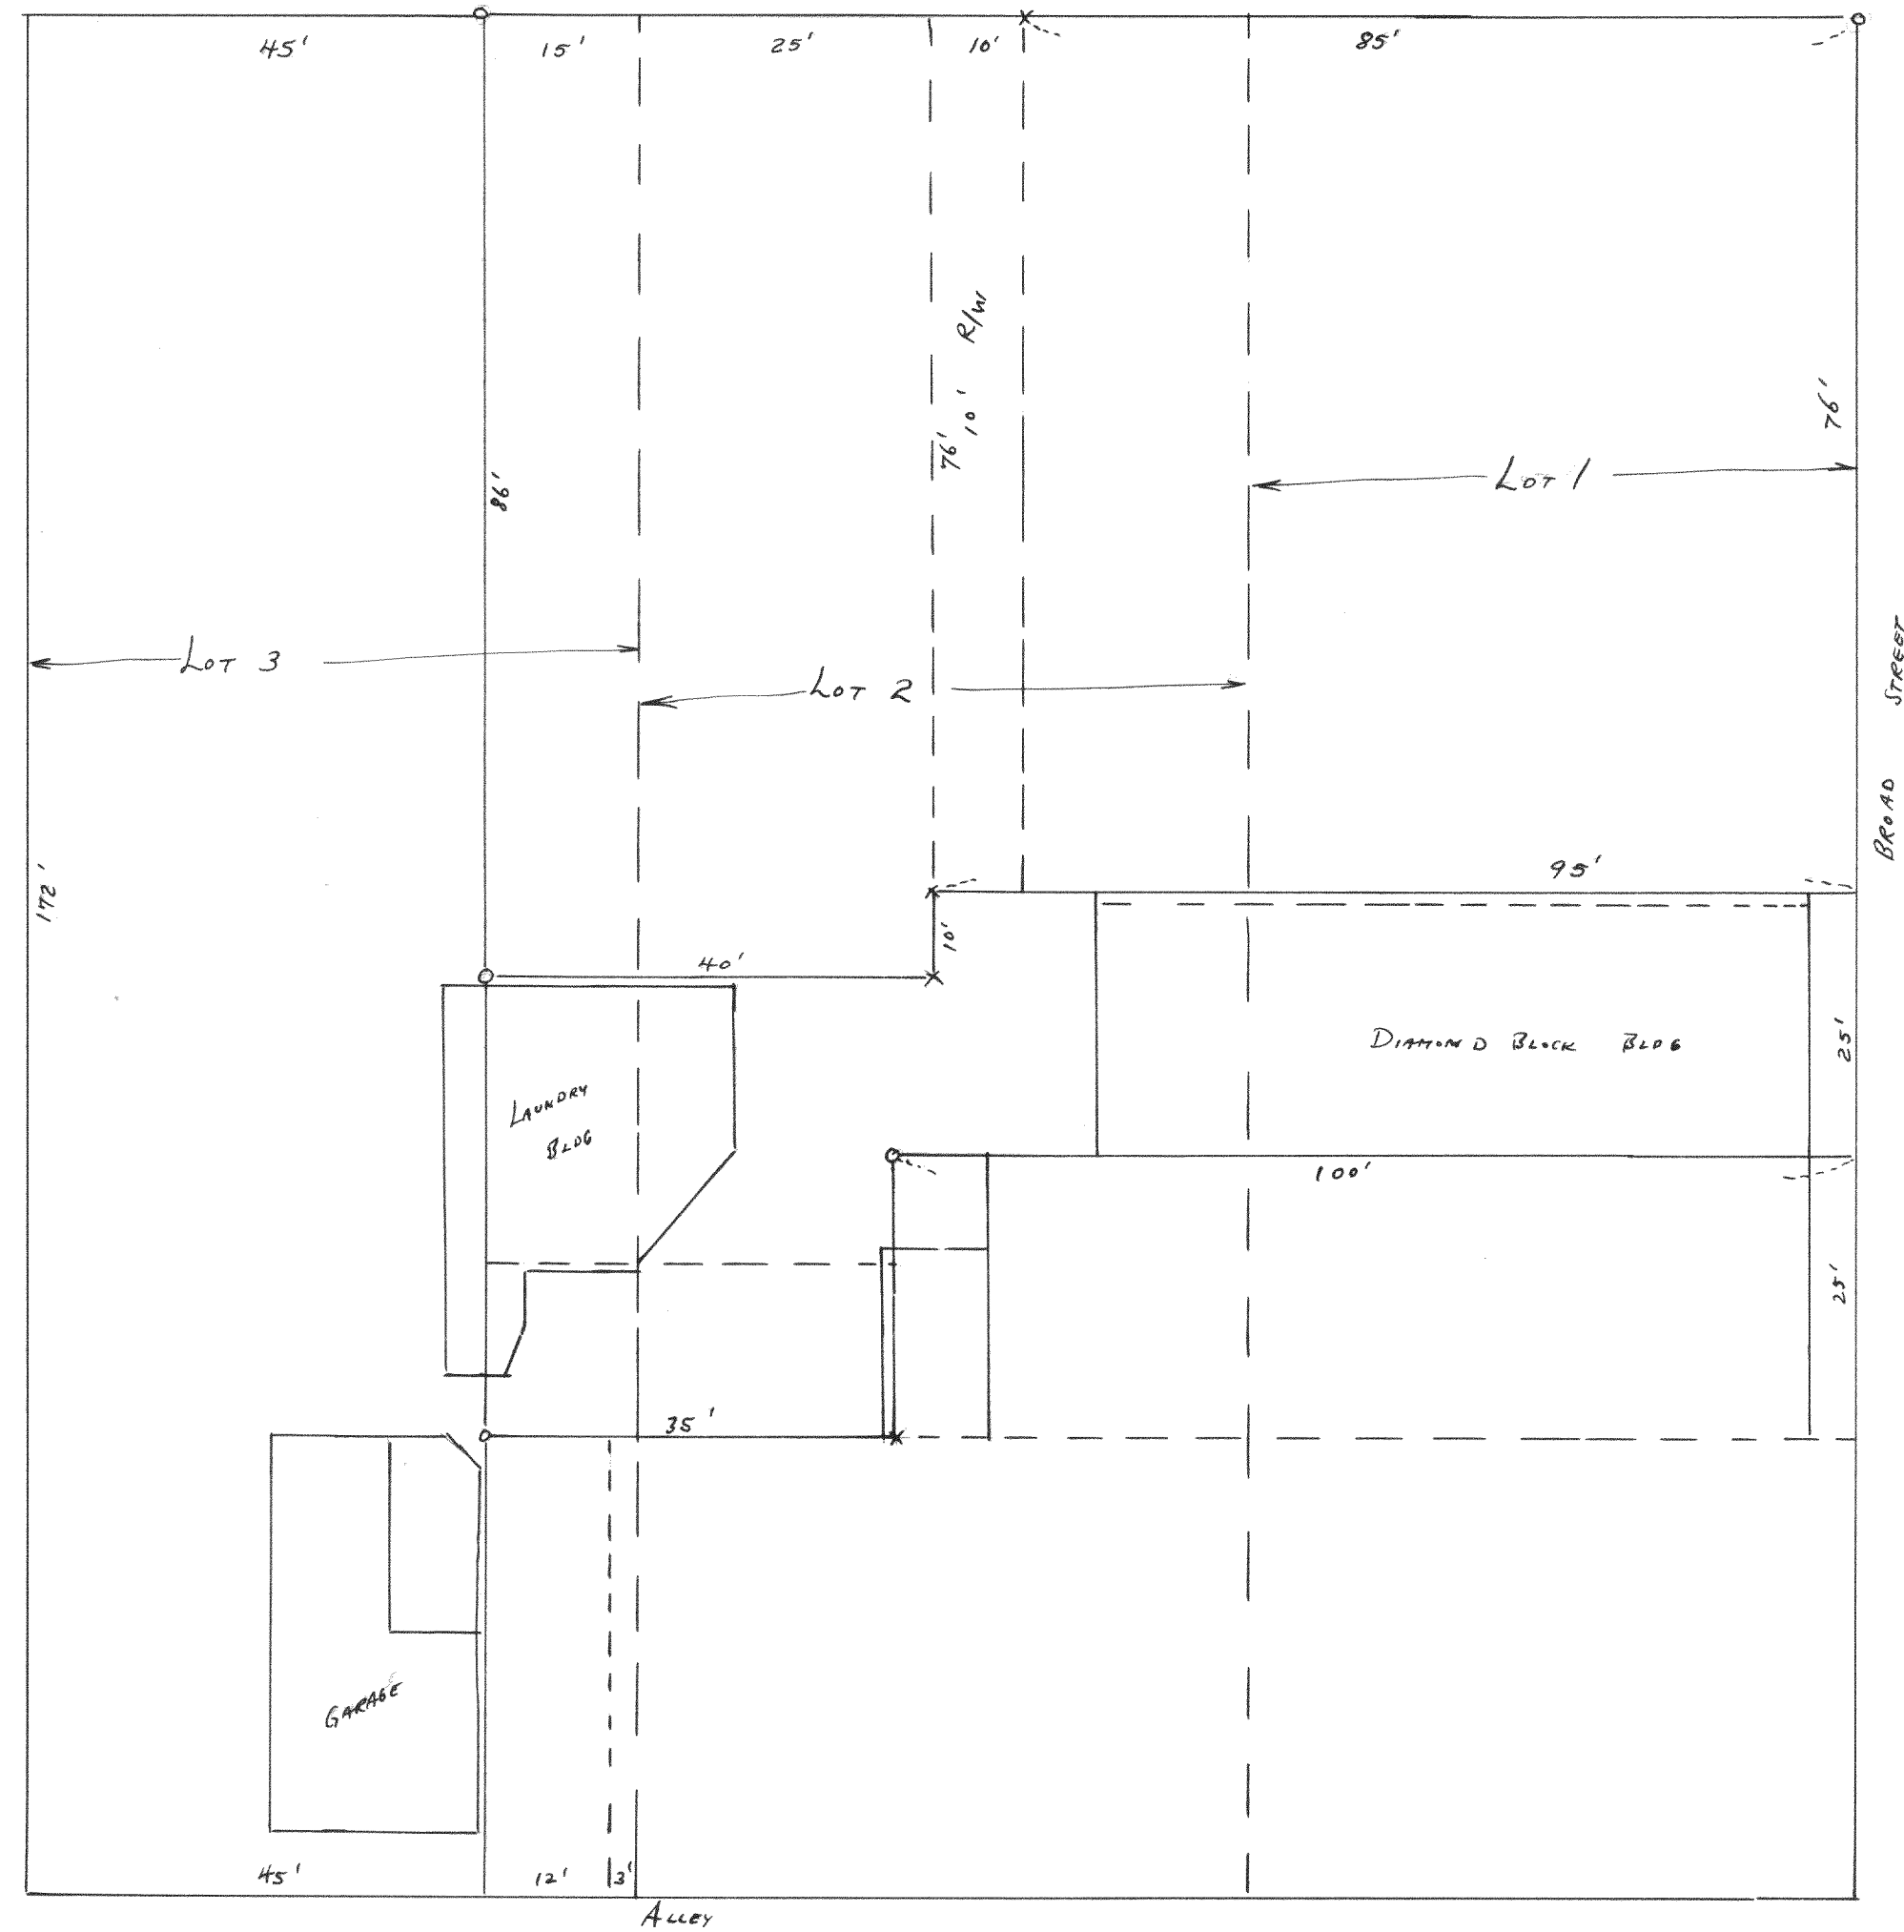

PLAT OF SURVEY OF LOTS 1, 2, 3 BLOCK 26 ORIGINAL PLAT OF
CITY OF LAKE GENEVA WALWORTH COUNTY, WIS.
MARCH 1954

Lloyd L. Jensen
County Surveyor

#2930

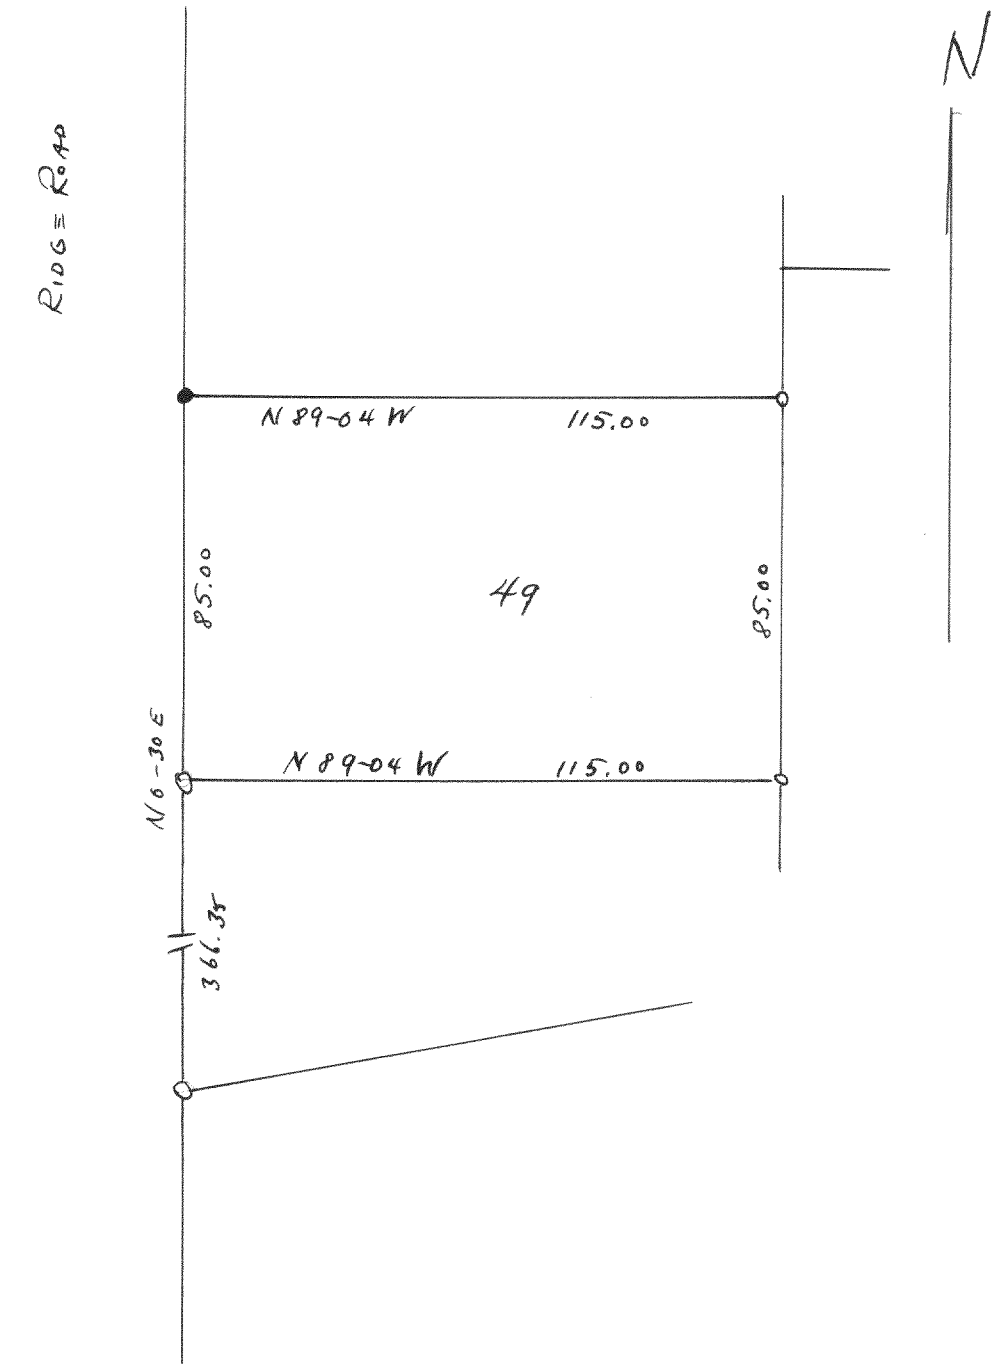

PLAT OF SURVEY OF
LOT 49 STURWOOD ADDN #2 TO CITY OF
LAKE GENEVA, WALWORTH COUNTY, WIS.
MARCH 1954

Lloyd L. Jensen
County Surveyor