



2638

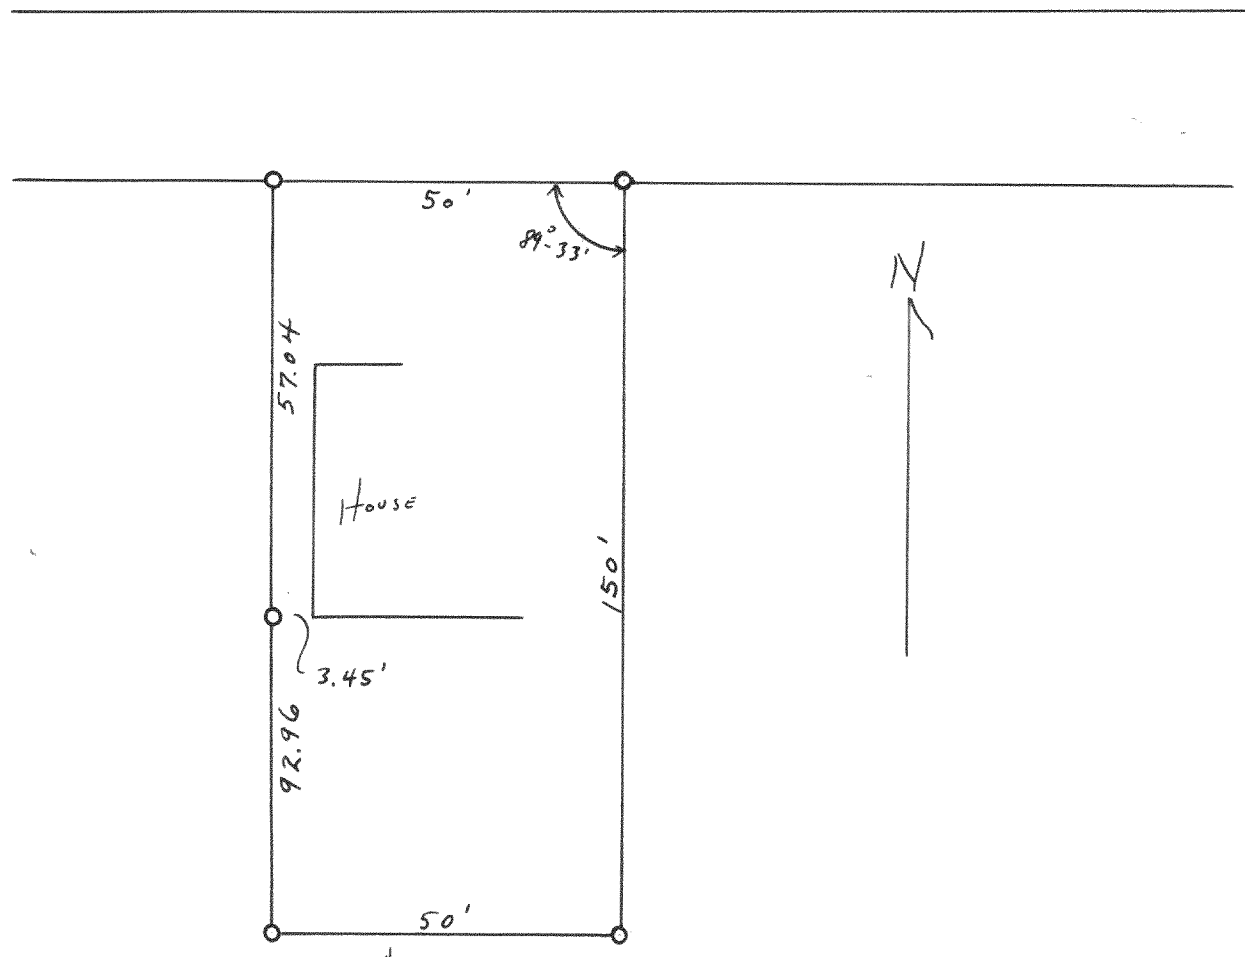

ALLEY


PLAT OF SURVEY OF LOT 38 OF COLUMBIAN
SUBDIVISION IN THE CITY OF LAKE GENEVA
July 8, 1952
Lloyd L. Jensen
County Surveyor

2639

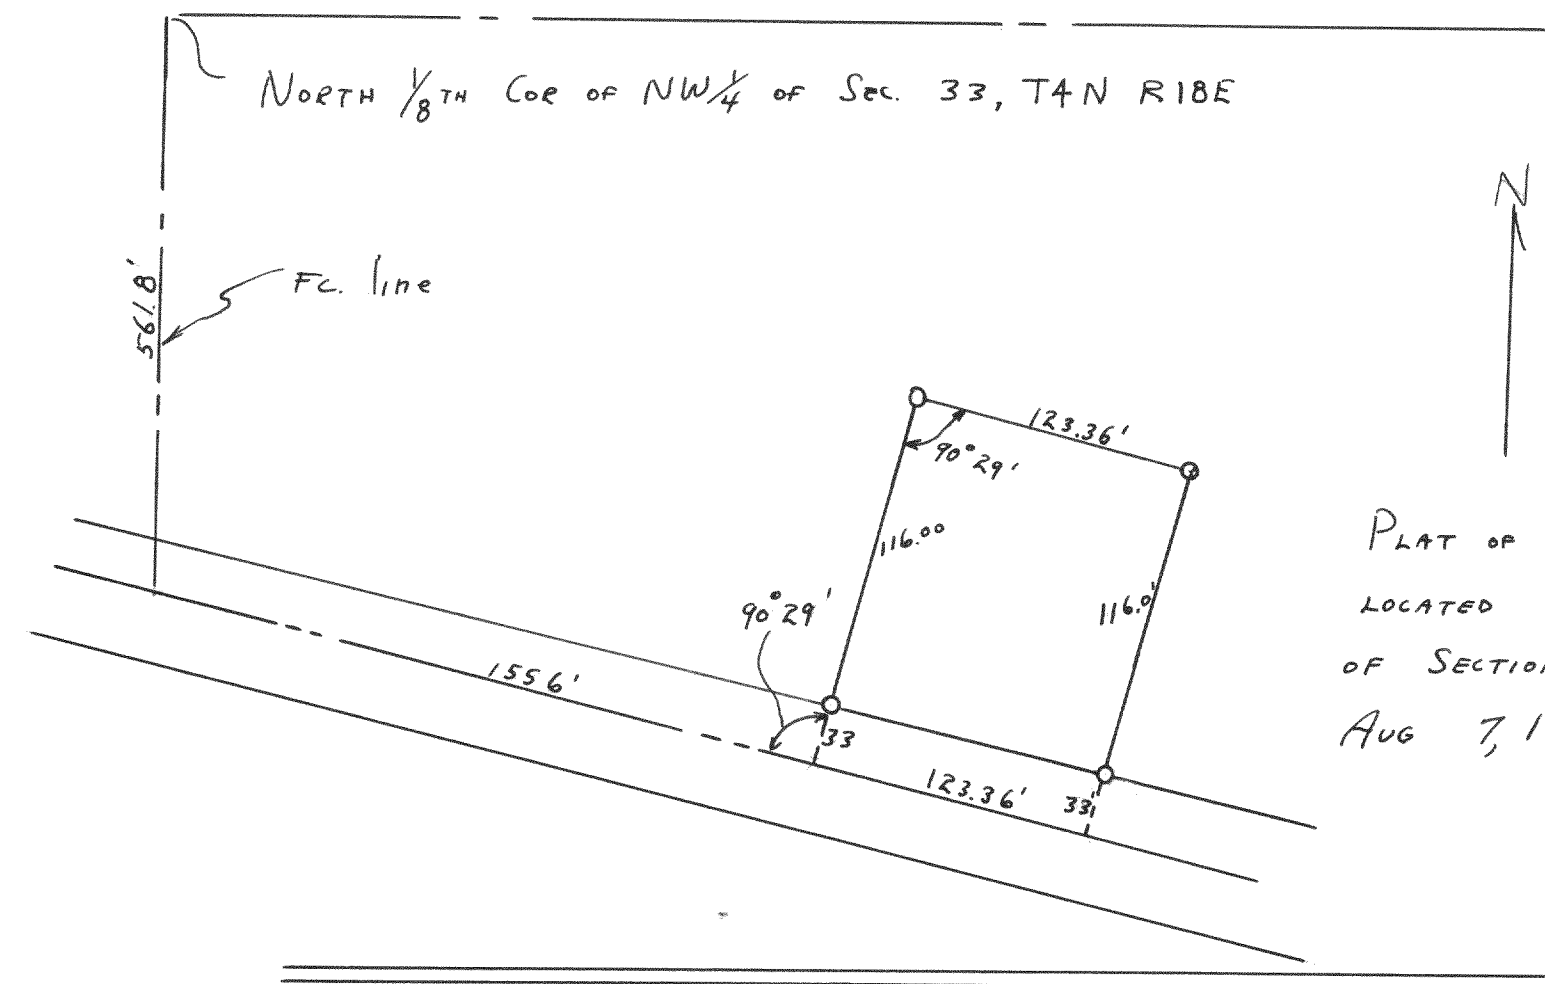


PLAT OF SURVEY OF LAND
LOCATED IN THE NORTHWEST 1/4
OF SECTION 33, T4N R18 E.
Aug 7, 1952
Lloyd L. Jensen
County Surveyor

2641

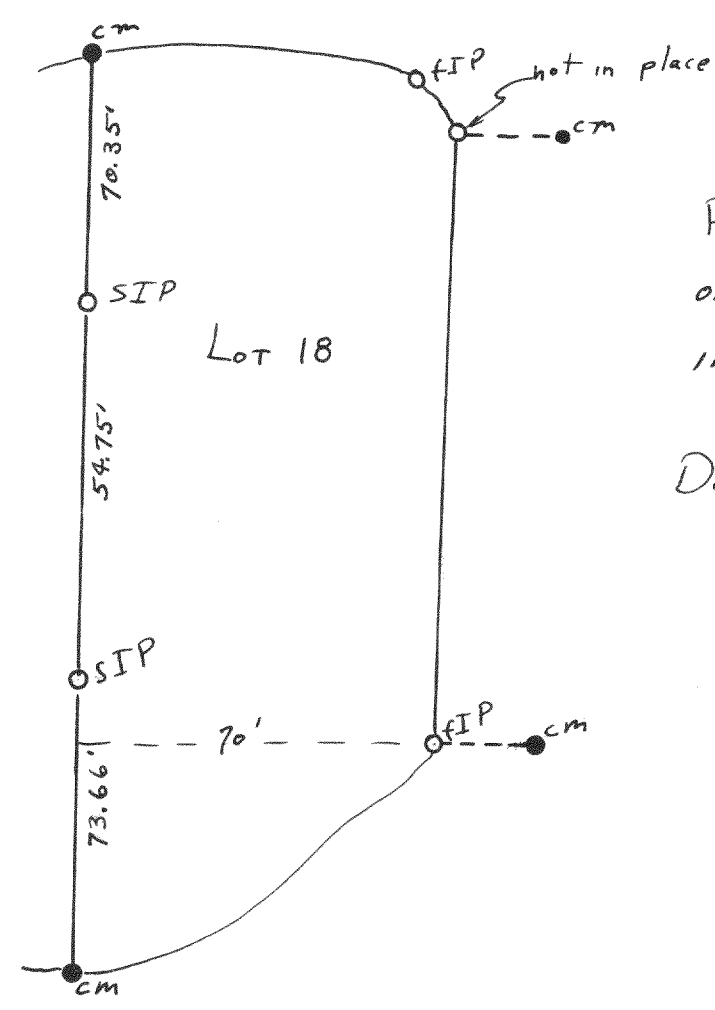

PLAT OF SURVEY OF PART
OF LOT 18 OF CLUB UNIQUE
IN THE VILLAGE OF FONTANA.
Dec. 1952
Lloyd L. Jensen
County Surveyor

2640

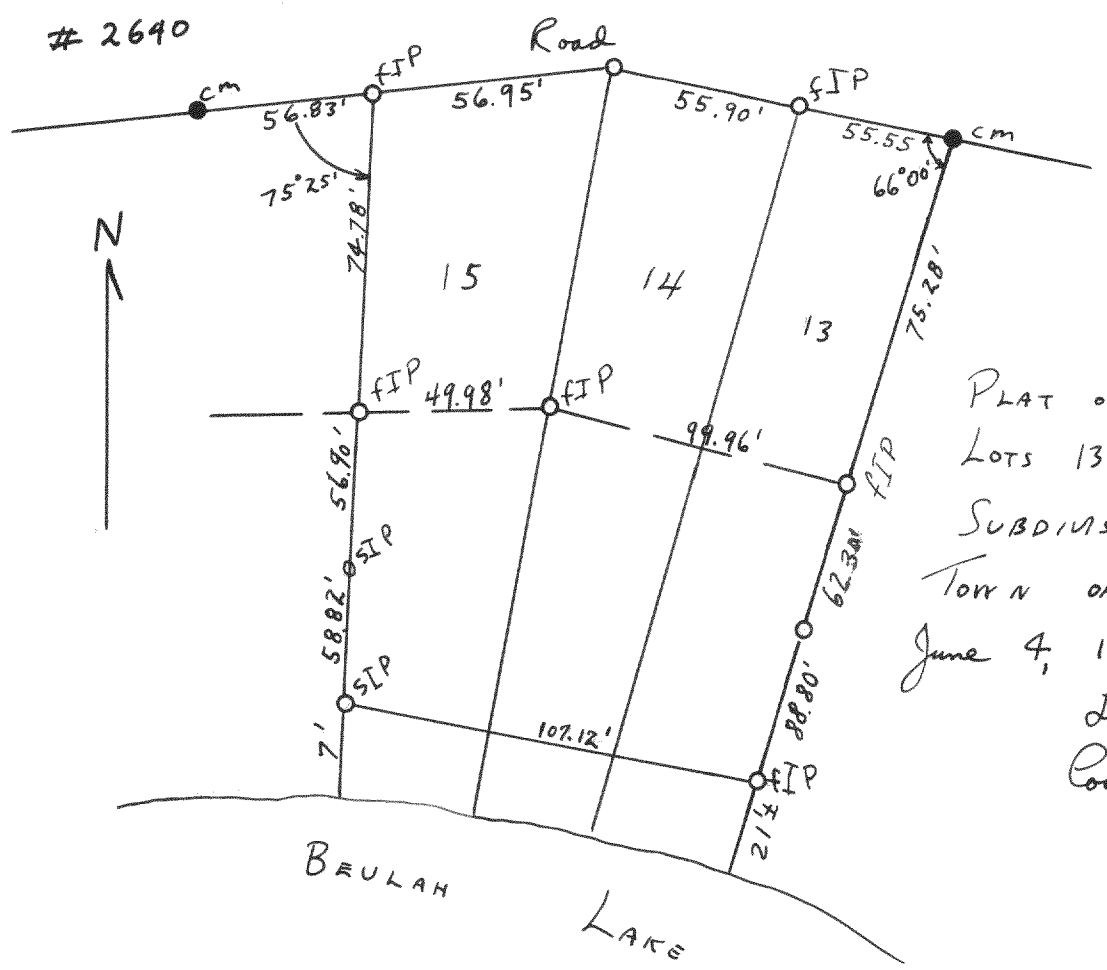

PLAT OF SURVEY OF
LOTS 13 & 15 OF FREUCK'S
SUBDIVISION IN THE
TOWN OF EAST TROY.
June 4, 1952
Lloyd L. Jensen
County Surveyor