

PLAT OF SURVEY
OF


LOTS 1 AND 2 EXCEPT NORTH
65.00'; LOTS 16 AND 17 EXCEPT
SOUTH 10.00', BLOCK 9 - PLAT OF
FONTANA, WALWORTH CO., WIS.

NOV. 22, 1968

Shirley L. Jensen
COUNTY SURVEYOR

SCALE 1" = 30'
○ - IRON PIPE
● - CONCRETE MONUMENT

3350 #

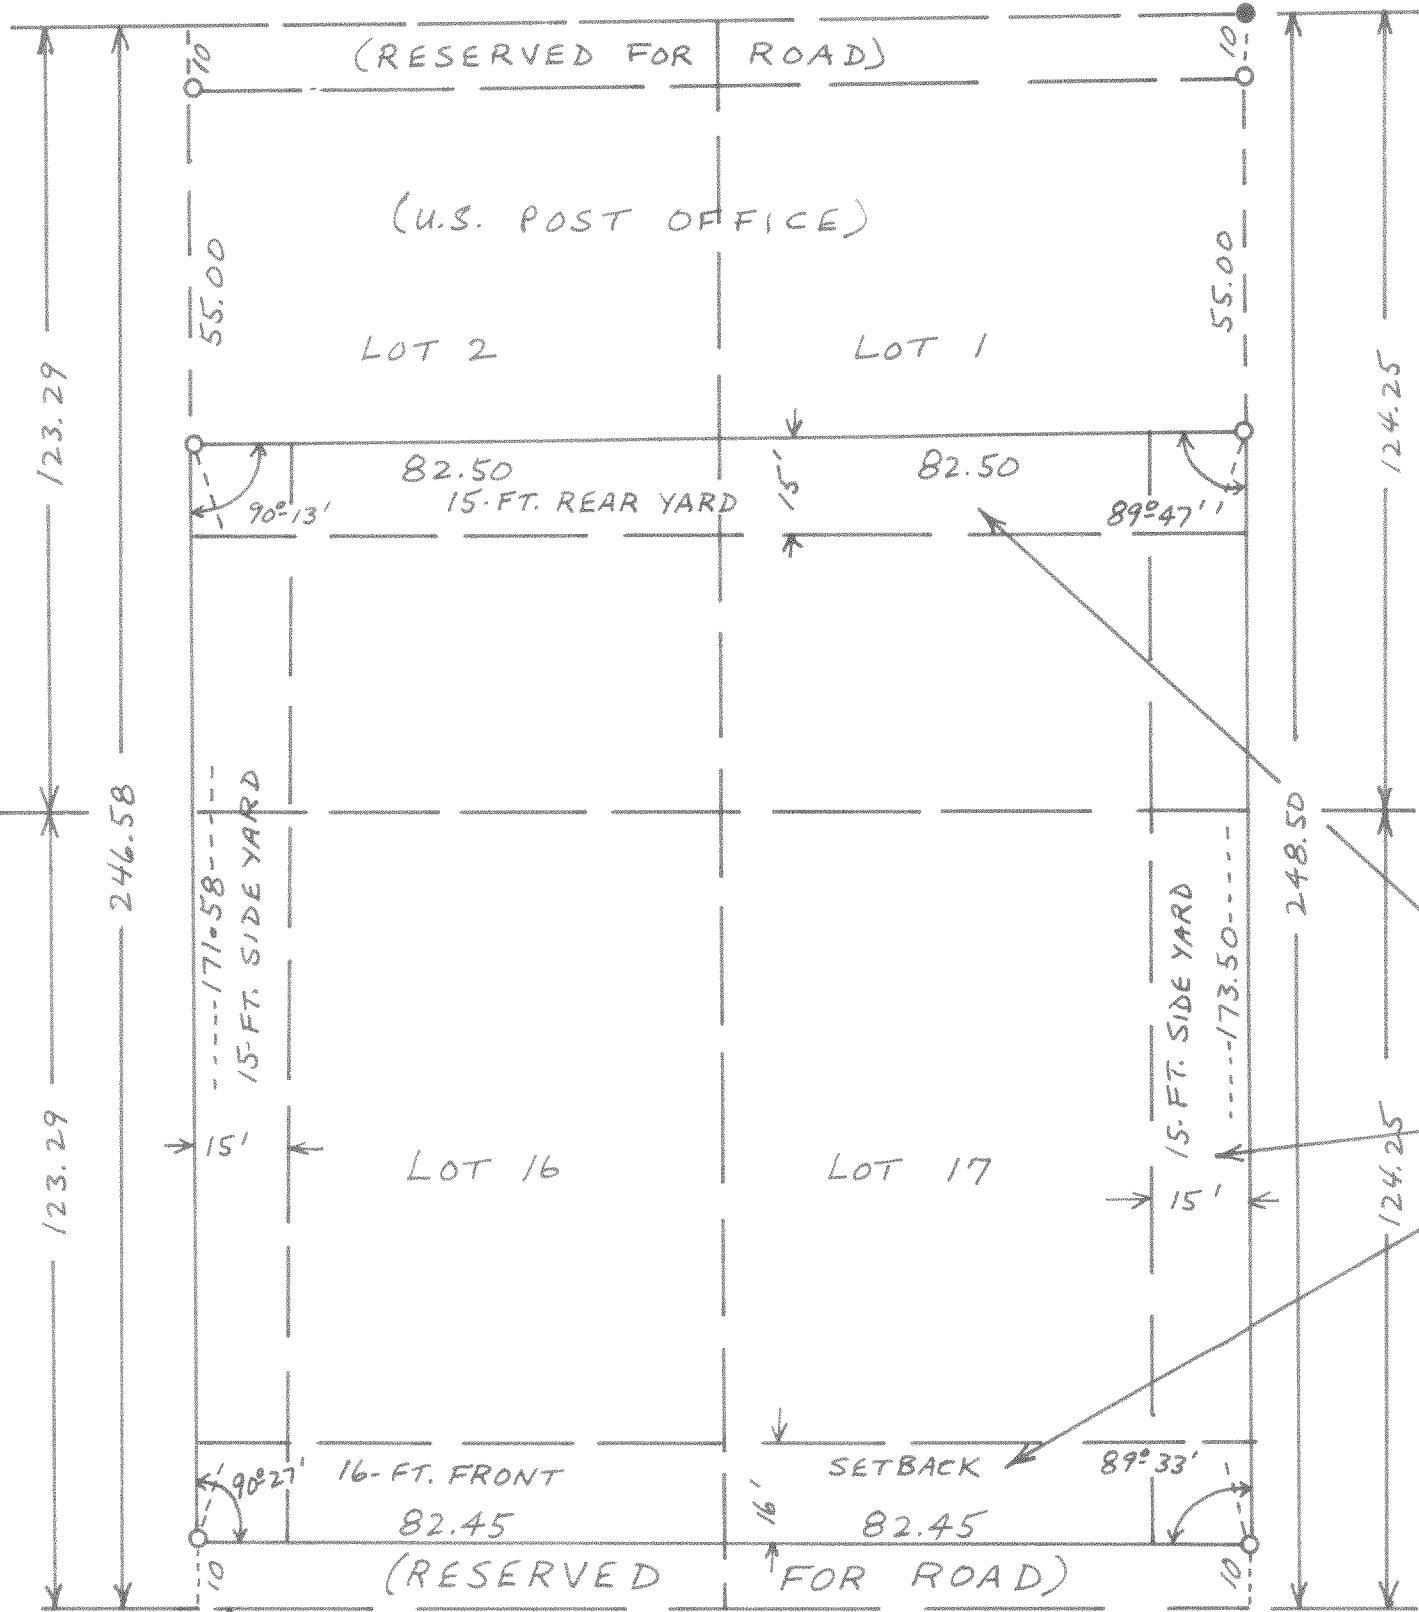

SETBACK, REAR YARD AND SIDE YARD REQUIREMENTS AS
FURNISHED BY LESTER ORCUTT, BUILDING INSPECTOR FOR
THE VILLAGE OF FONTANA-ON-GENEVA LAKE, WISCONSIN.

NOTE: 15-FT. REAR YARD MAY BE USED AS A DRIVE.
1 1/2 PARKING SPACES REQUIRED FOR EACH APARTMENT.

EAST-WEST 1/6 LINE

FONTANA BLVD.