


#4590

## PLAT OF SURVEY

OF  
THE WEST 92.00' OF LOTS 1-2-3 BLOCK 1  
HARBOR VIEW SUBDIVISION  
WILLIAMS BAY, WISCONSIN.

S.T.H. #36

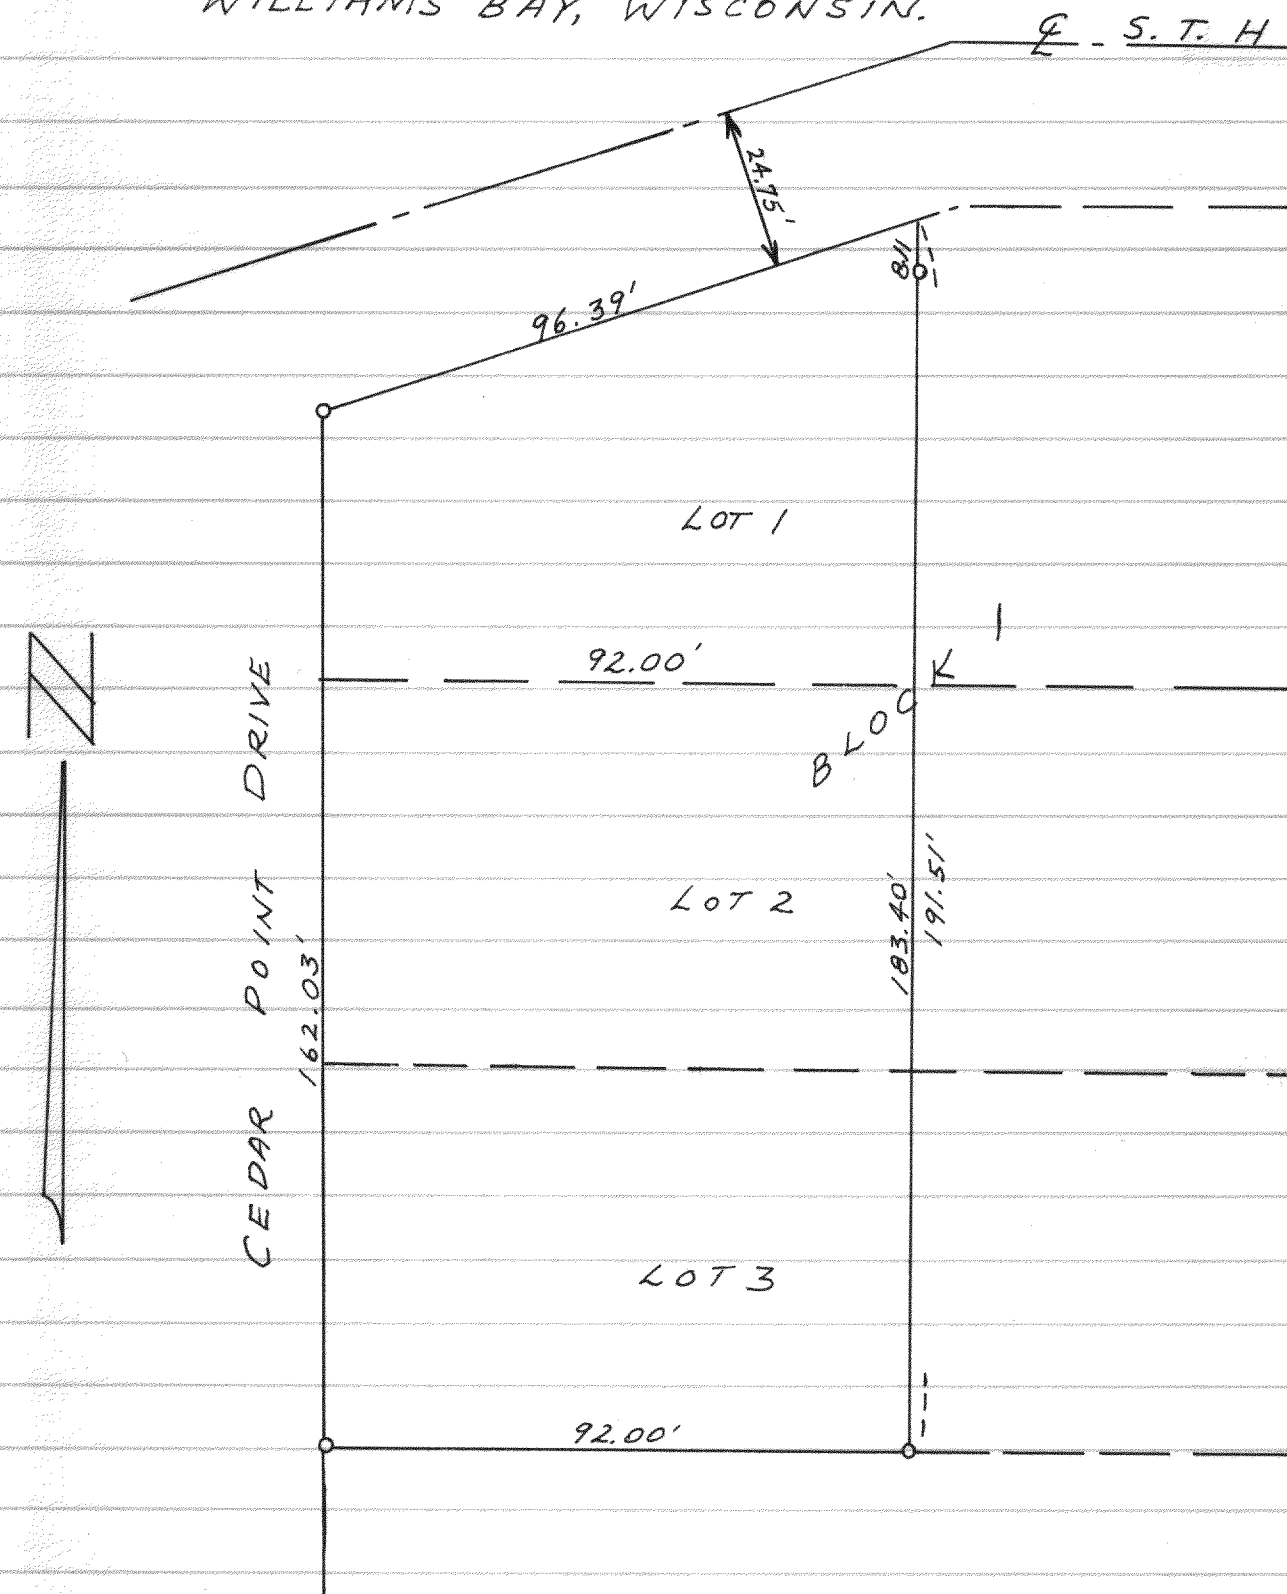

## LEGEND

- — Iron Pipe
- — Concrete Monument
- Scale 1" = 30'

Date DEC. 1968

*Lloyd L. Jensen*  
COUNTY SURVEYOR

707


#4591

## PLAT OF SURVEY

OF  
PART OF WILLIAMS PARK  
W $\frac{1}{2}$  SECTION 4, T4N R18E

PRIVATE ROAD HORSESHOE LANE

(33' WIDE)

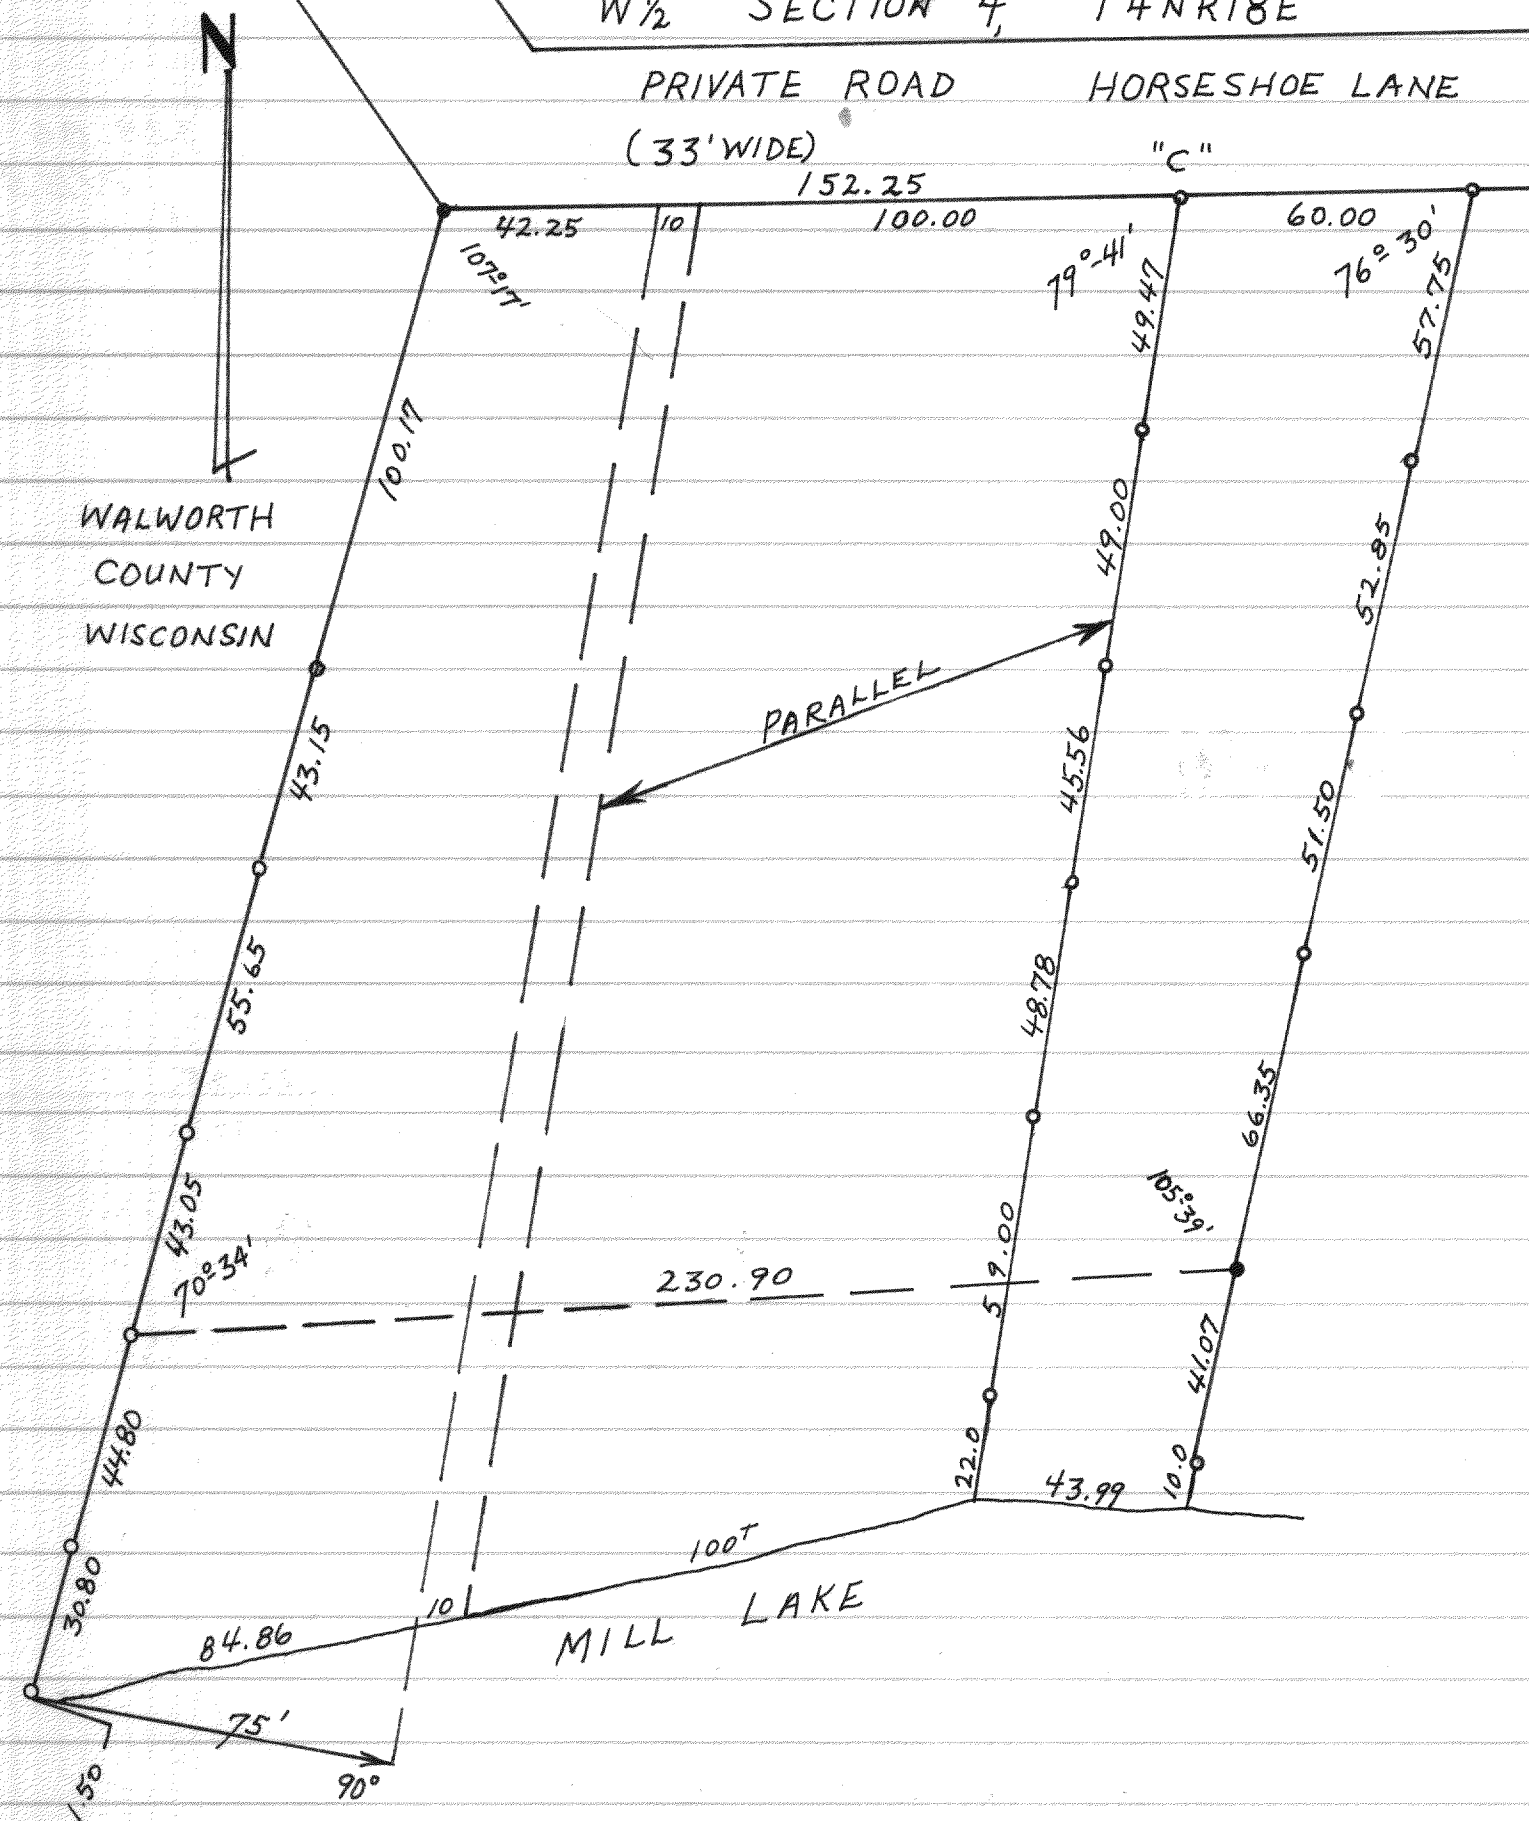

## LEGEND

- — Iron Pipe
- — Concrete Monument
- Scale 1" = 40'
- — IRON PIPE SET

Date DEC. 1968

*Lloyd L. Jensen*  
COUNTY SURVEYOR