


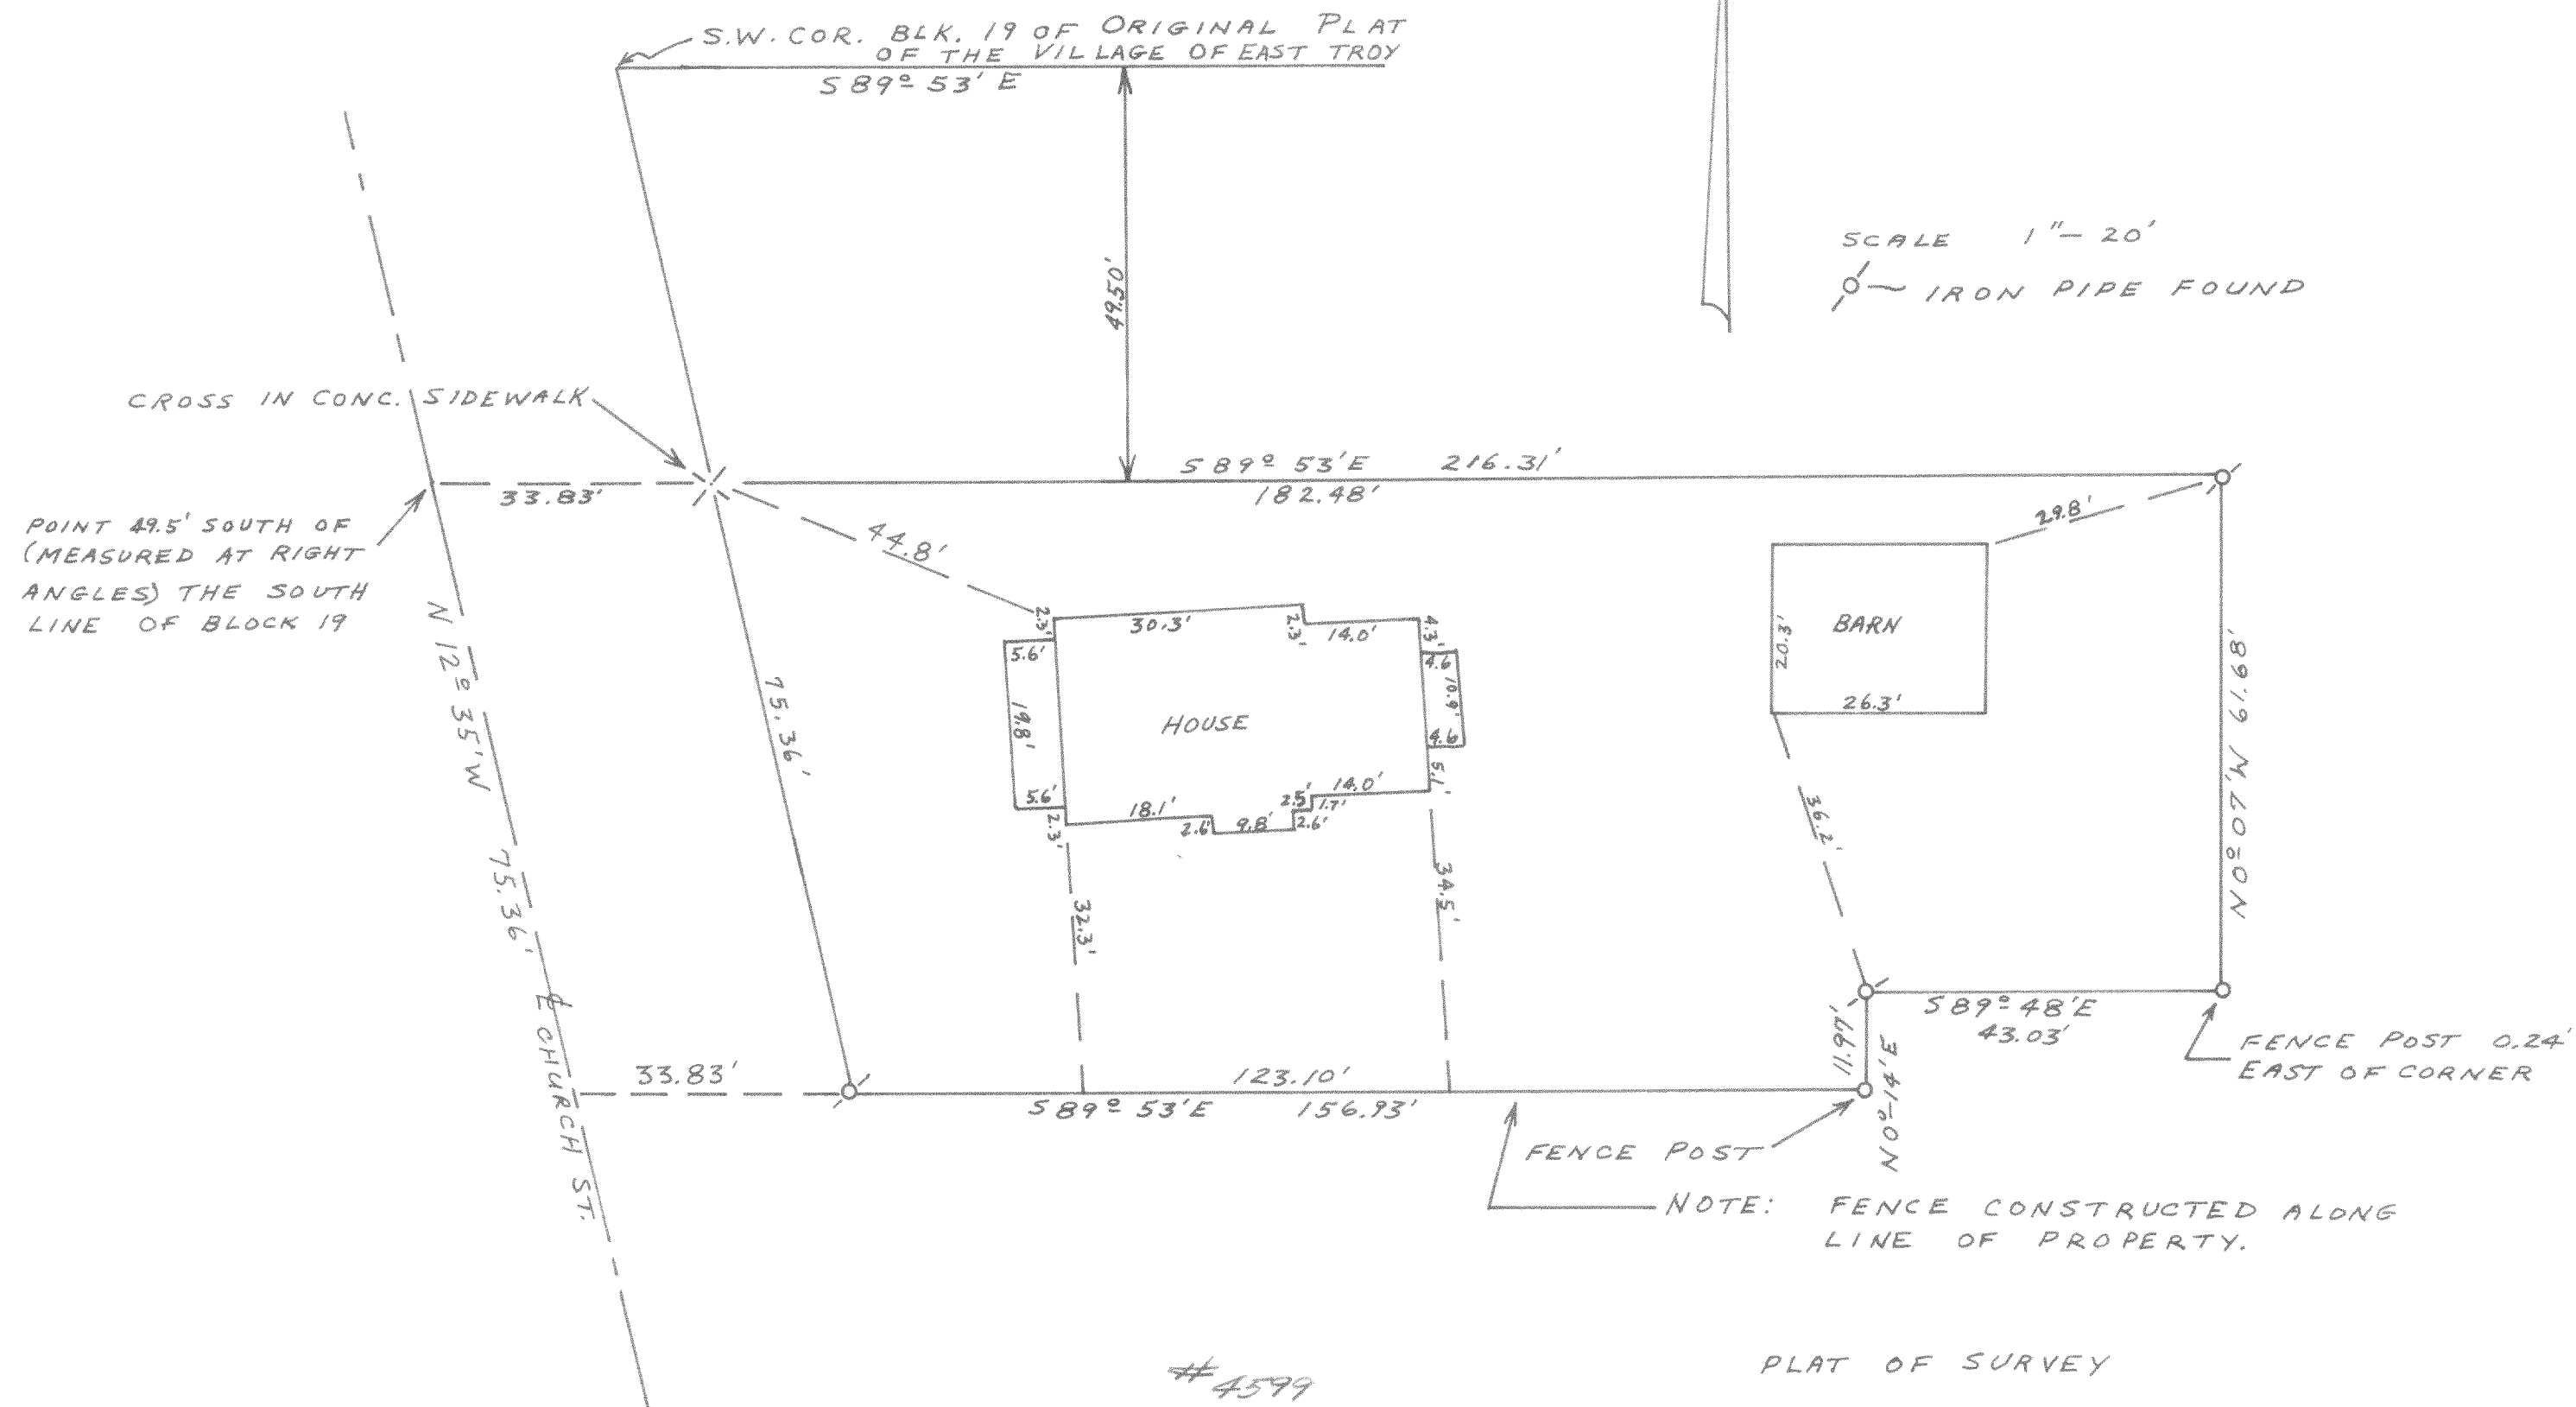

PLAT OF SURVEY
OF A PARCEL OF LAND LOCATED
IN THE NW $\frac{1}{4}$ OF SECTION 29,
T4N R18E WAL. CO. WIS.

OCT. 8, 1968 George L. Jensen
COUNTY SURVEYOR