


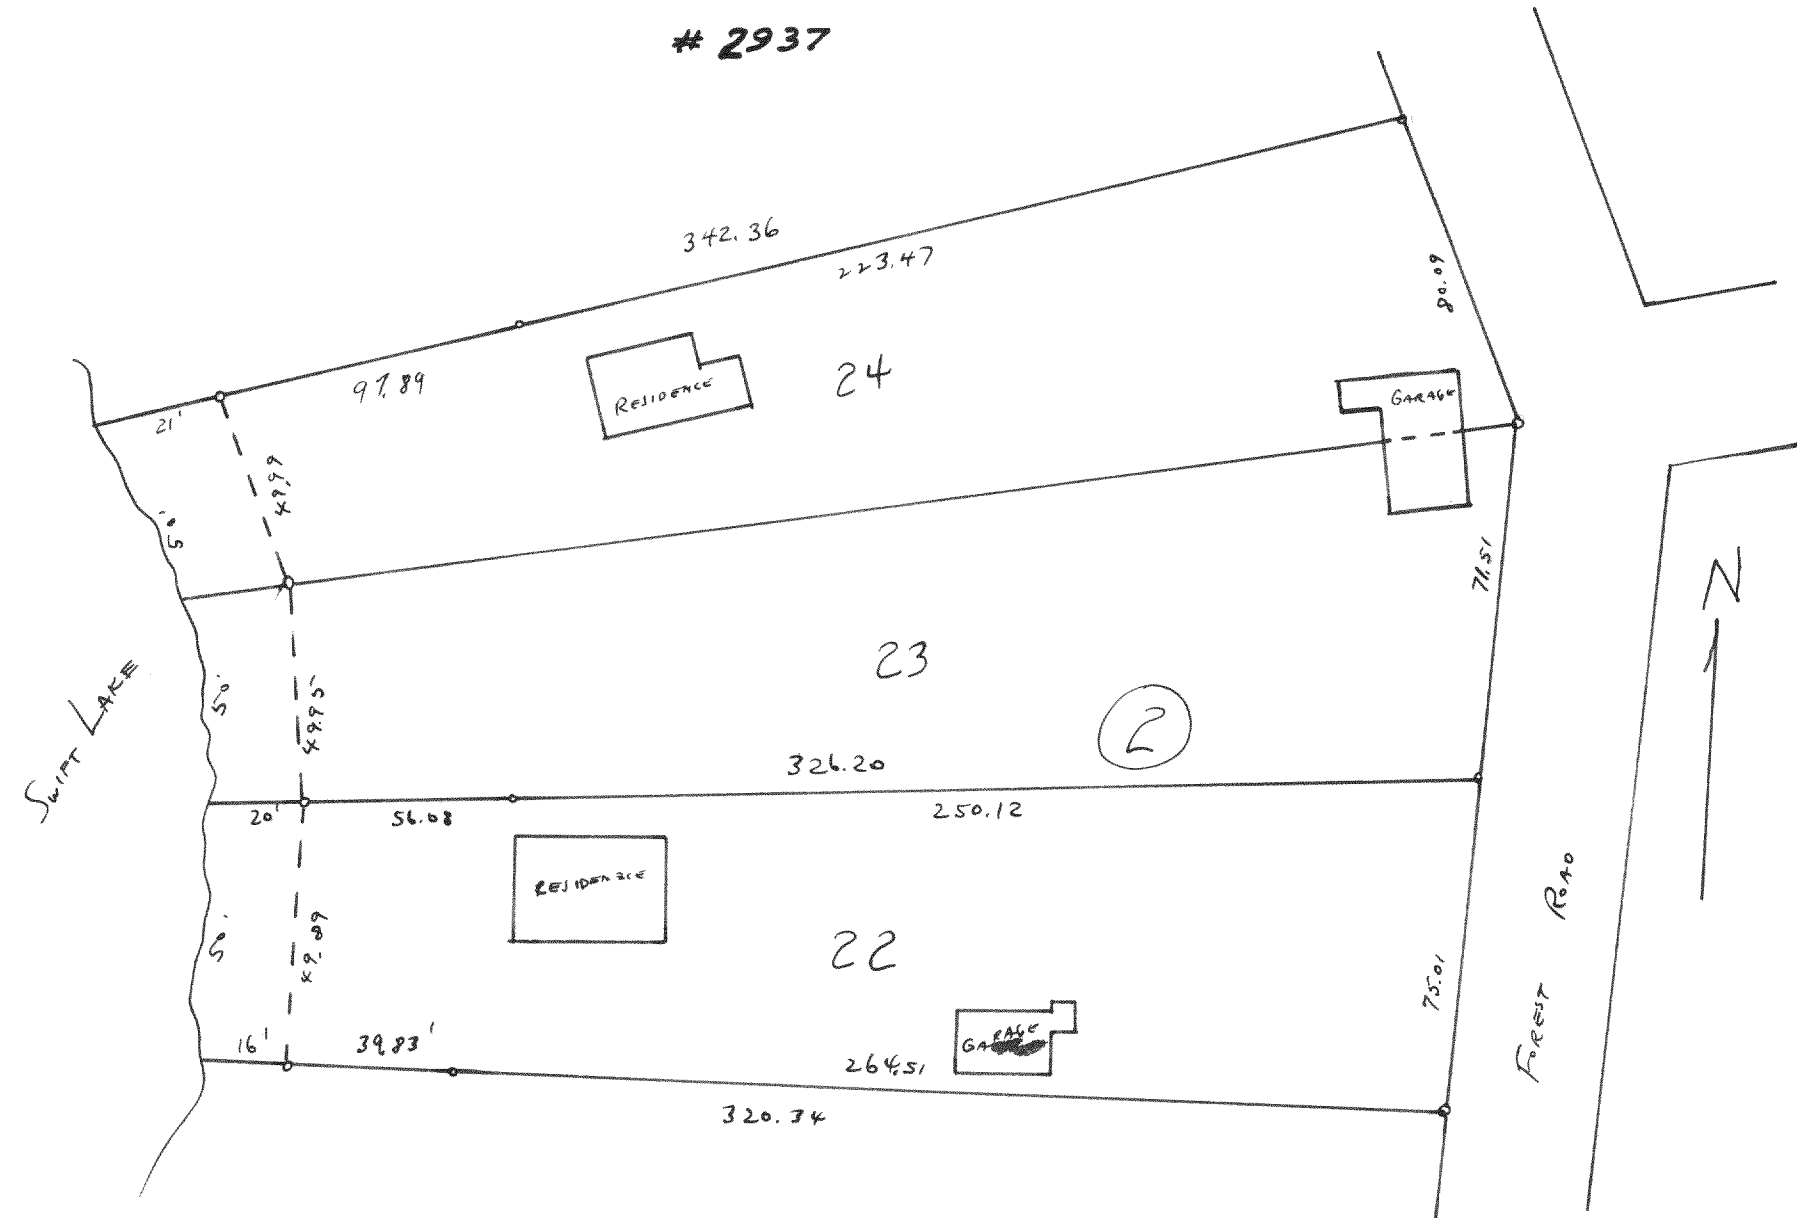


PLAT OF SURVEY OF LOTS 22-23-24 BLOCK 2

SWIFT LAKE SUBD. SEC 8 T4N R17E
WALWORTH COUNTY, WISCONSIN

MARCH 54

Lloyd L. Jones
County Surveyor


#2939

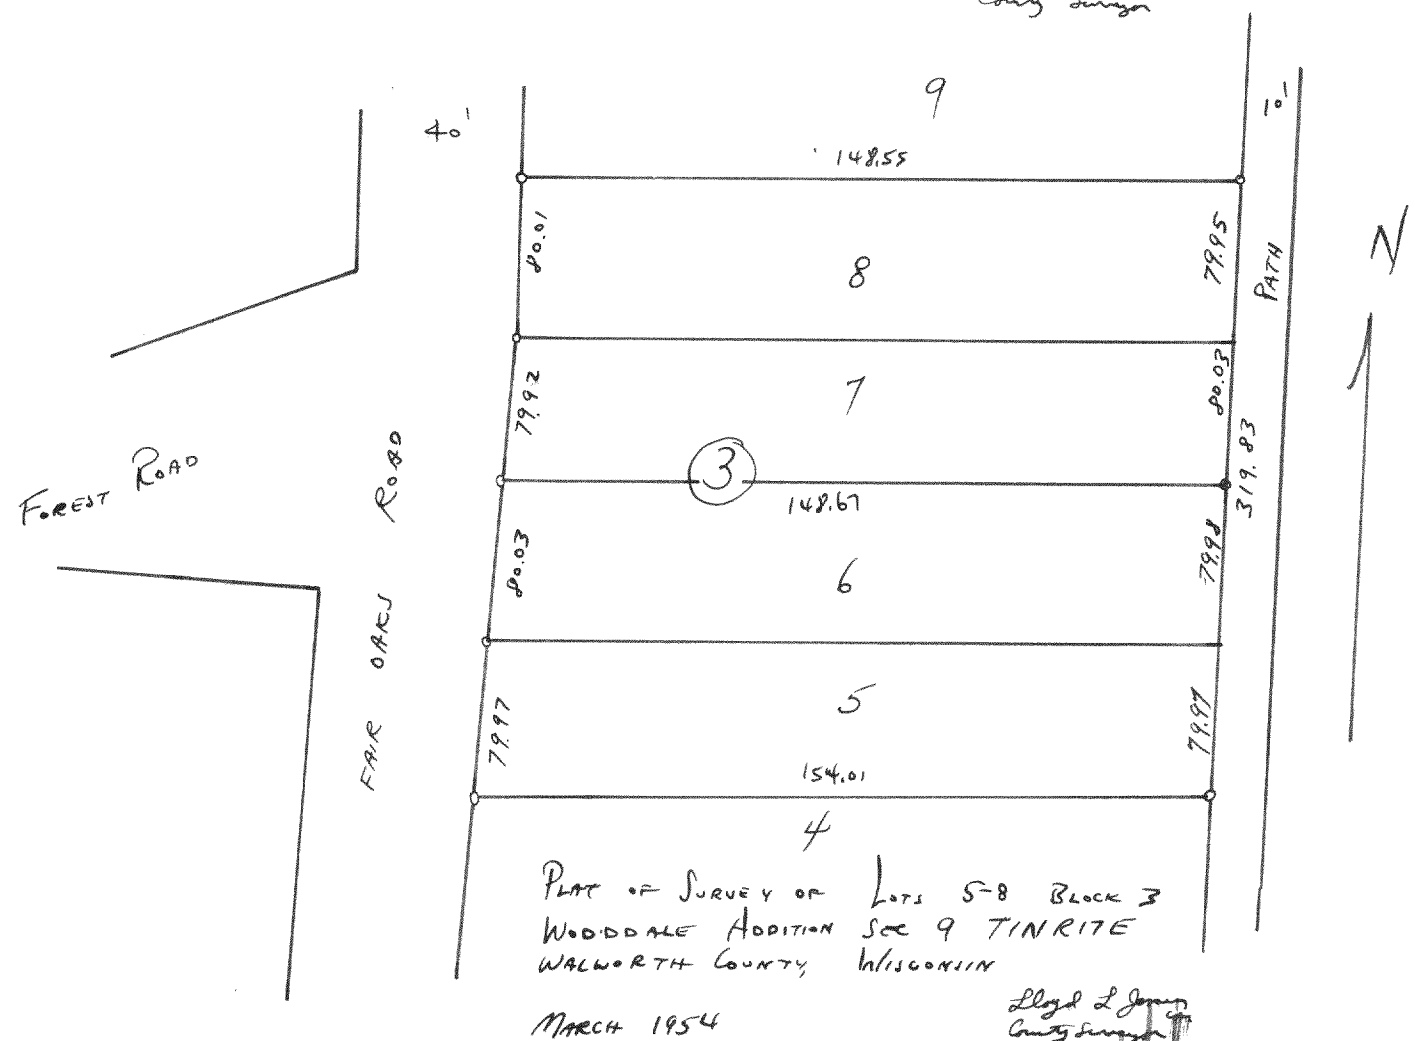

PLAT OF SURVEY OF LOTS 5-8 BLOCK 3
WOODDALE ADDITION SEC 9 T4N R17E
WALWORTH COUNTY, WISCONSIN

MARCH 1954

Lloyd L. Jones
County Surveyor

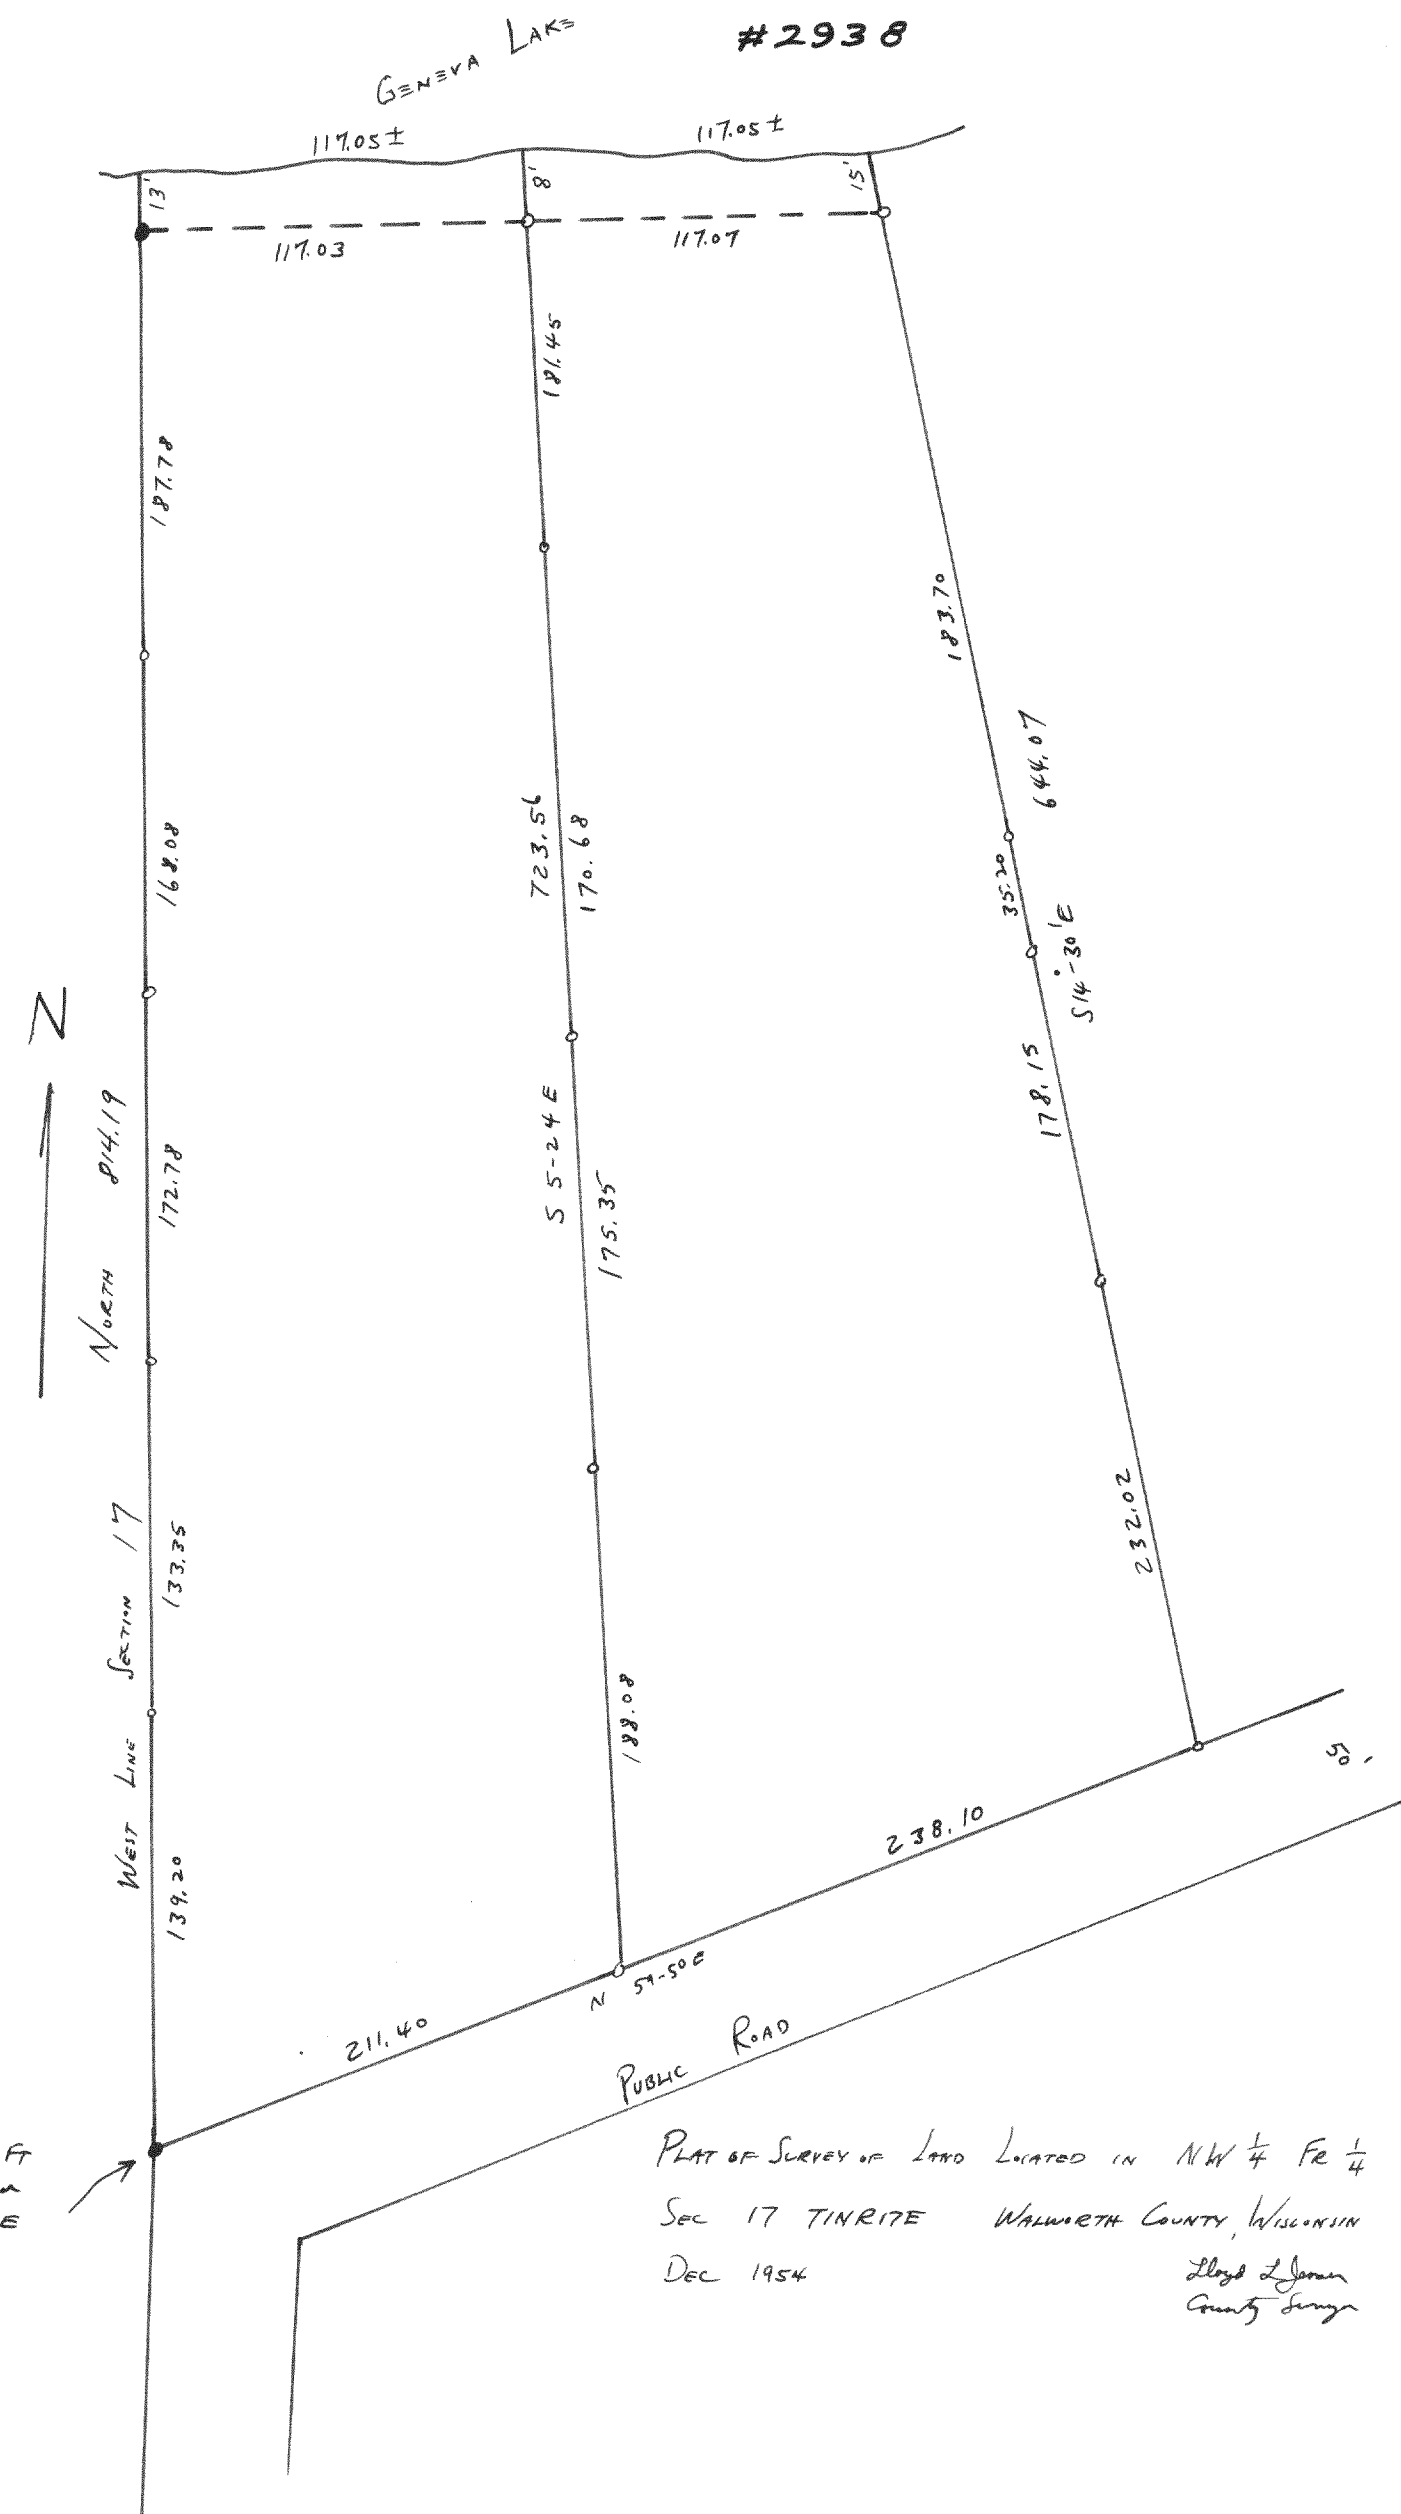

POINT IS 985.12 FT
NORTH OF W 1/4 SEC CORNER
SEC 17 T4N R17E

PLAT OF SURVEY OF LAND LOCATED IN NW 1/4 PR 1/4
SEC 17 T4N R17E WALWORTH COUNTY, WISCONSIN
DEC 1954

Lloyd L. Jones
County Surveyor