



#2940

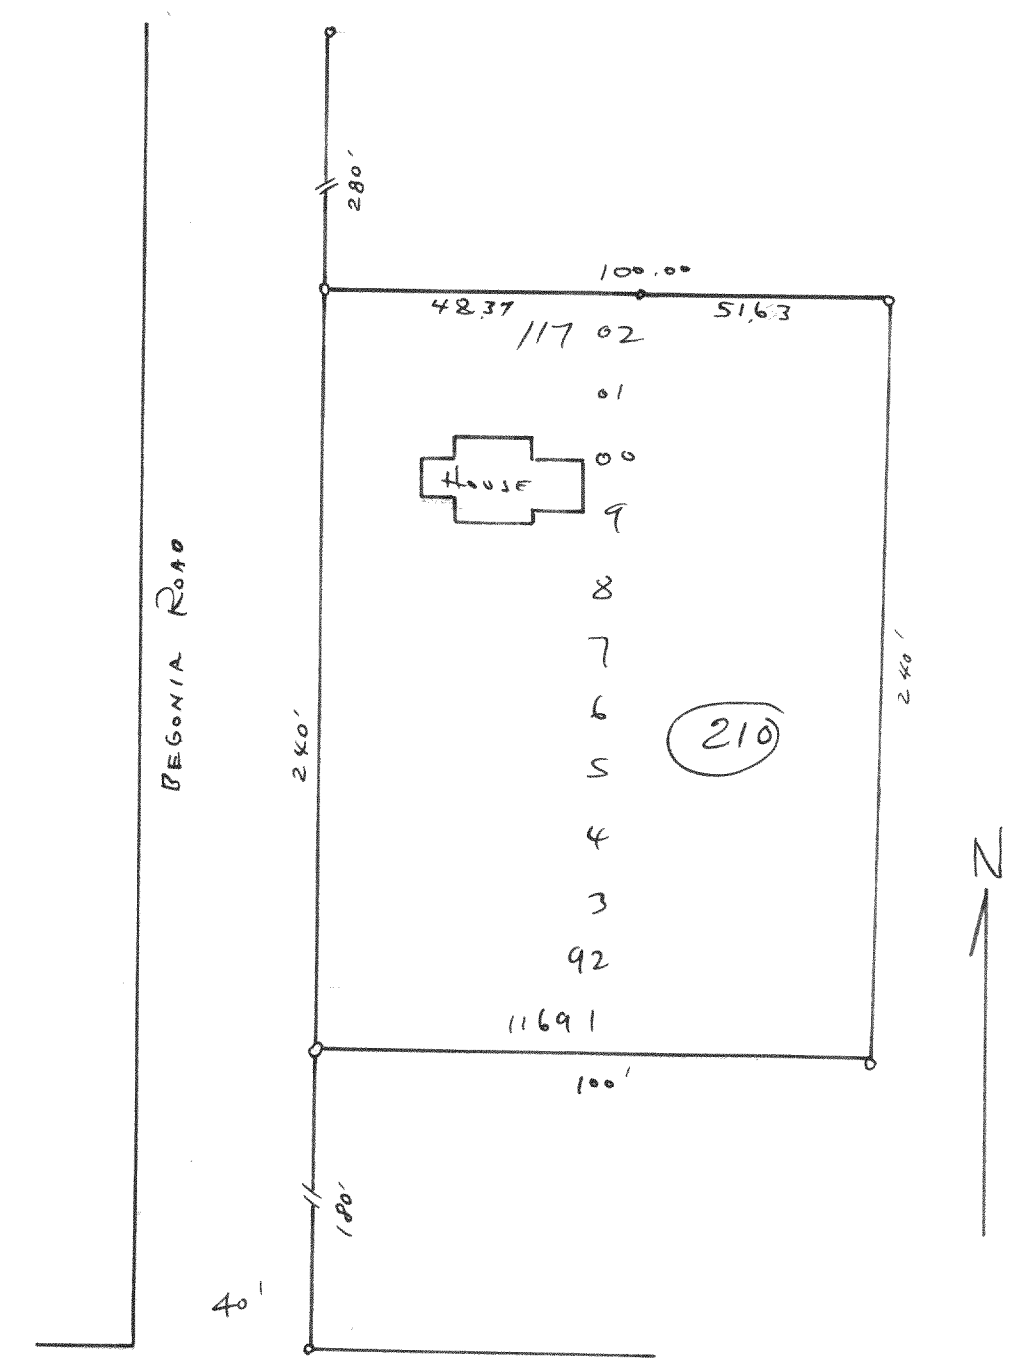


PLAT OF SURVEY OF LOTS 11691-11702 BLOCK 210
LAKE GENEVA BEACH IN T2N R1E
WALWORTH COUNTY, WISCONSIN
August 1954
Lloyd L. Jensen
County Engineer

#2941

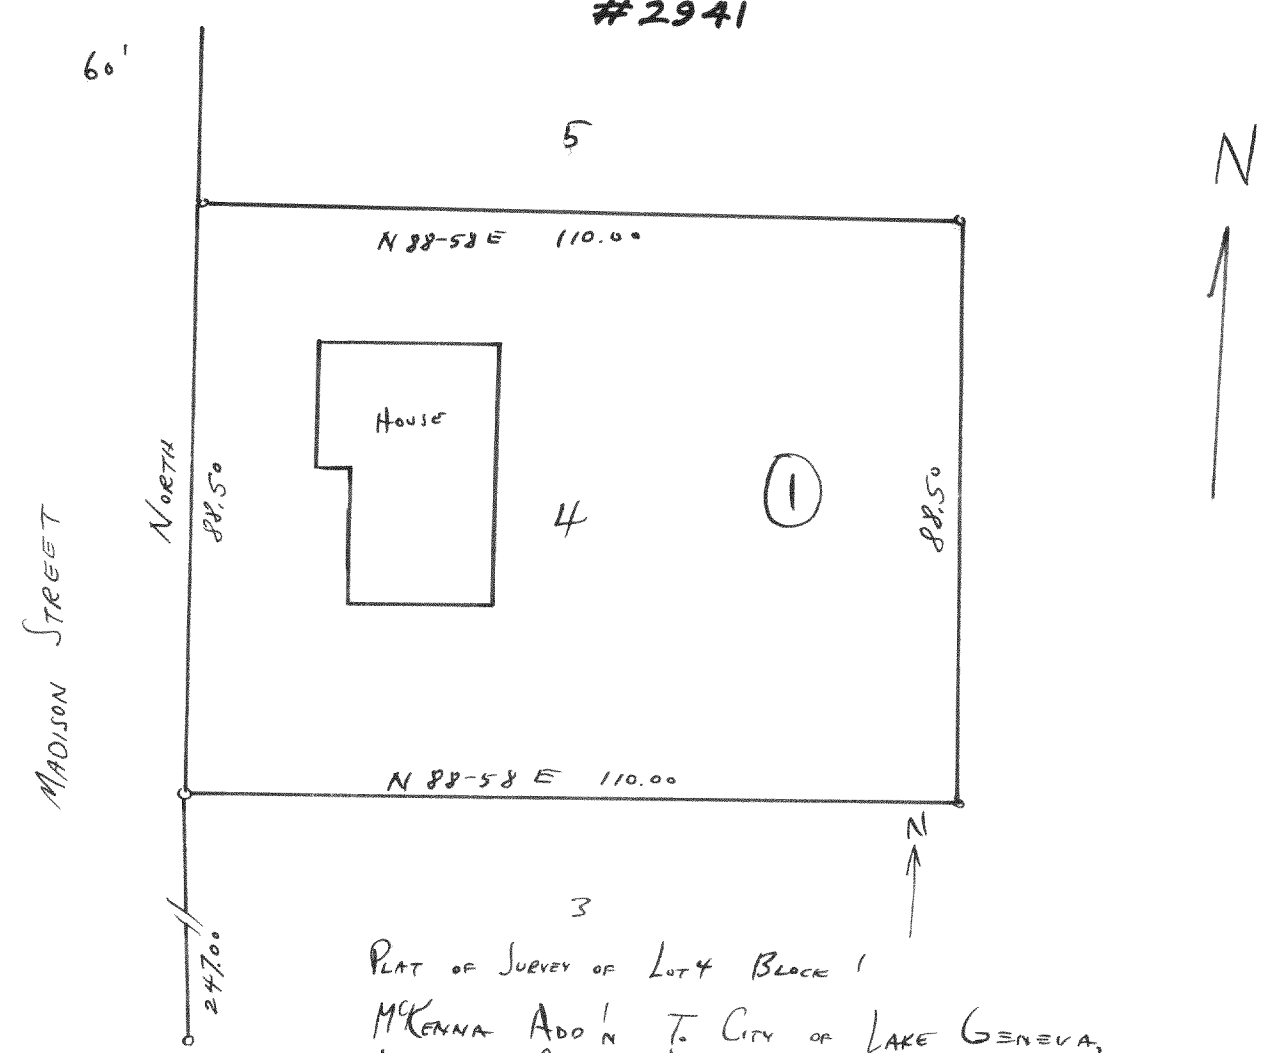


PLAT OF SURVEY OF LOT 4 BLOCK 1
MCKENNA ADDITION TO THE CITY OF LAKE GENEVA,
WALWORTH COUNTY, WISCONSIN
October 1954
Lloyd L. Jensen
County Engineer

#2942

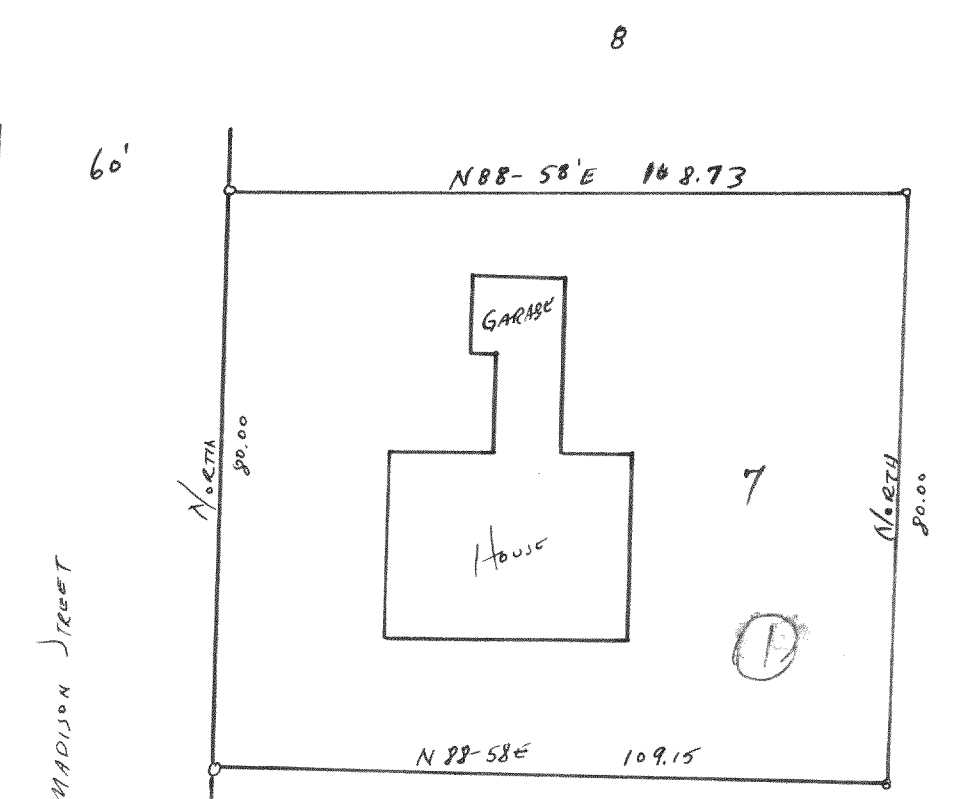


PLAT OF SURVEY OF LOT 7 BLOCK 1
MCKENNA ADDITION TO THE CITY OF LAKE GENEVA
WALWORTH COUNTY, WISCONSIN
Oct 1954
Lloyd L. Jensen
County Engineer

#2944

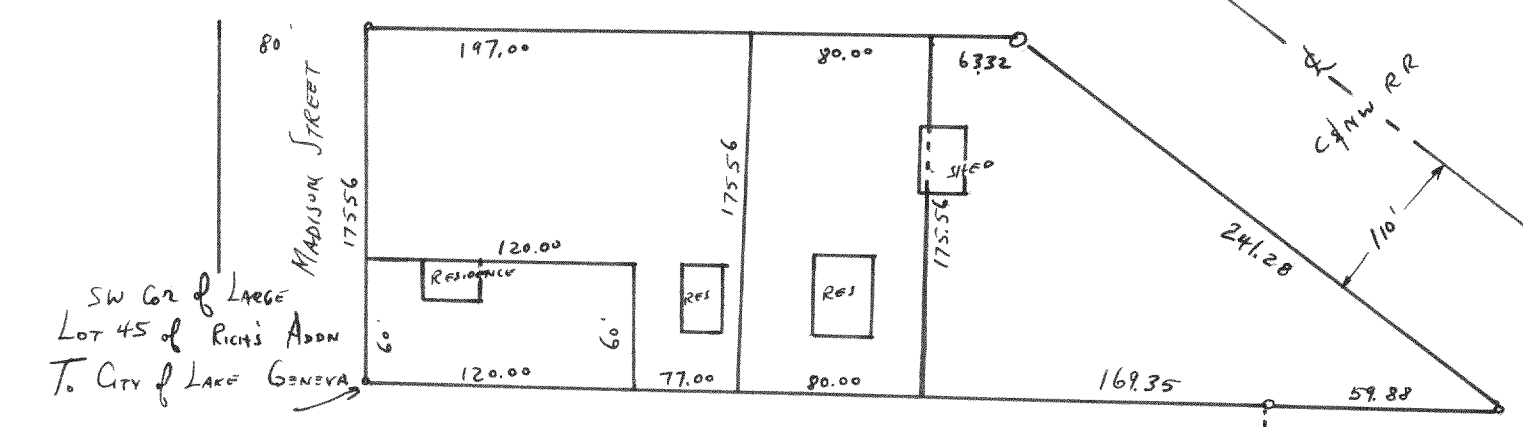


SW COR of LARGE
LOT 45 of RICH'S ADDN
TO CITY of LAKE GENEVA

#2943

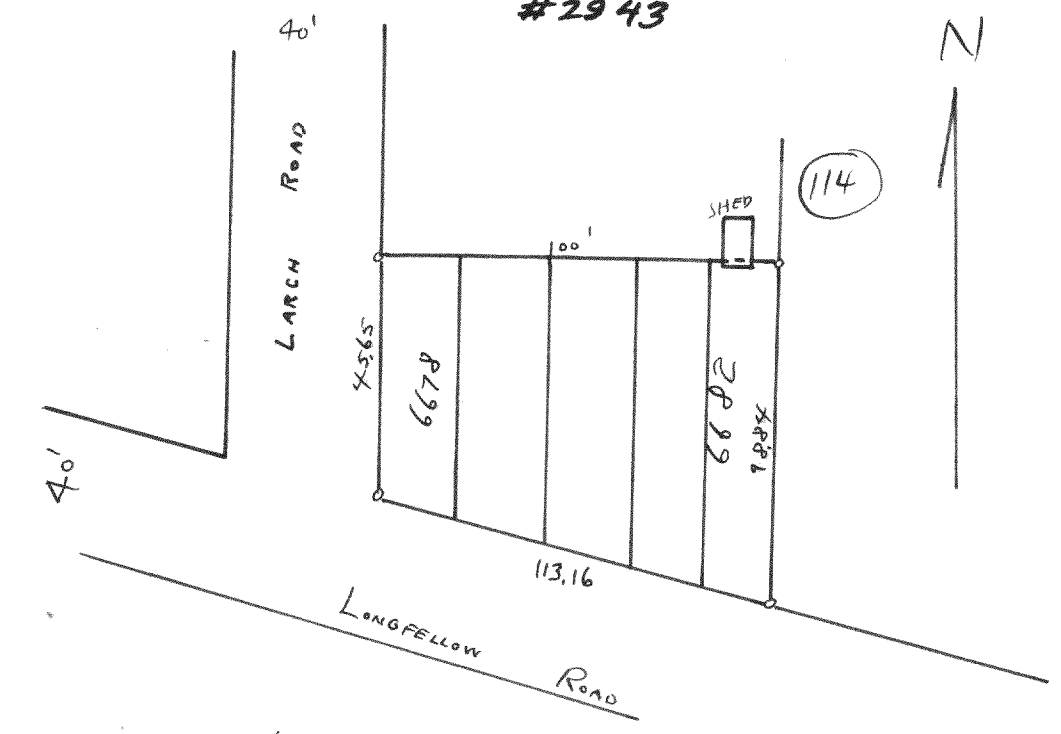

PLAT OF SURVEY OF LOTS 6678-6682
BLOCK 114 LAKE GENEVA BEACH
T2N R1E WALWORTH COUNTY, WISCONSIN
MAY 1954
Lloyd L. Jensen
County Engineer

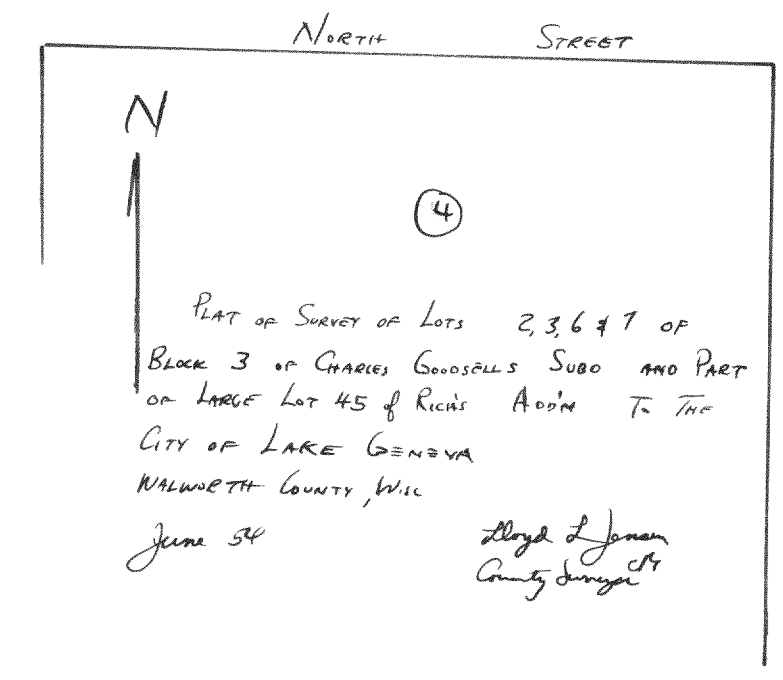

PLAT OF SURVEY OF LOTS 2, 3, 6 & 7 OF
BLOCK 3 OF CHARLES GOODSELL'S SUBD AND PART
OF LARGE LOT 45 of RICH'S ADDN TO THE
CITY OF LAKE GENEVA
WALWORTH COUNTY, WISCONSIN
June 54
Lloyd L. Jensen
County Engineer

