

#4619


PLAT OF SURVEY

OF

LOT 15 BLOCK 2 MORaine HEIGHTS SUBD.
 LOCATED IN SECTIONS 26 & 35 TAN RISE
 WALWORTH COUNTY, WISCONSIN.

MAY 1969

Floyd L. Jensen
 COUNTY SURVEYOR

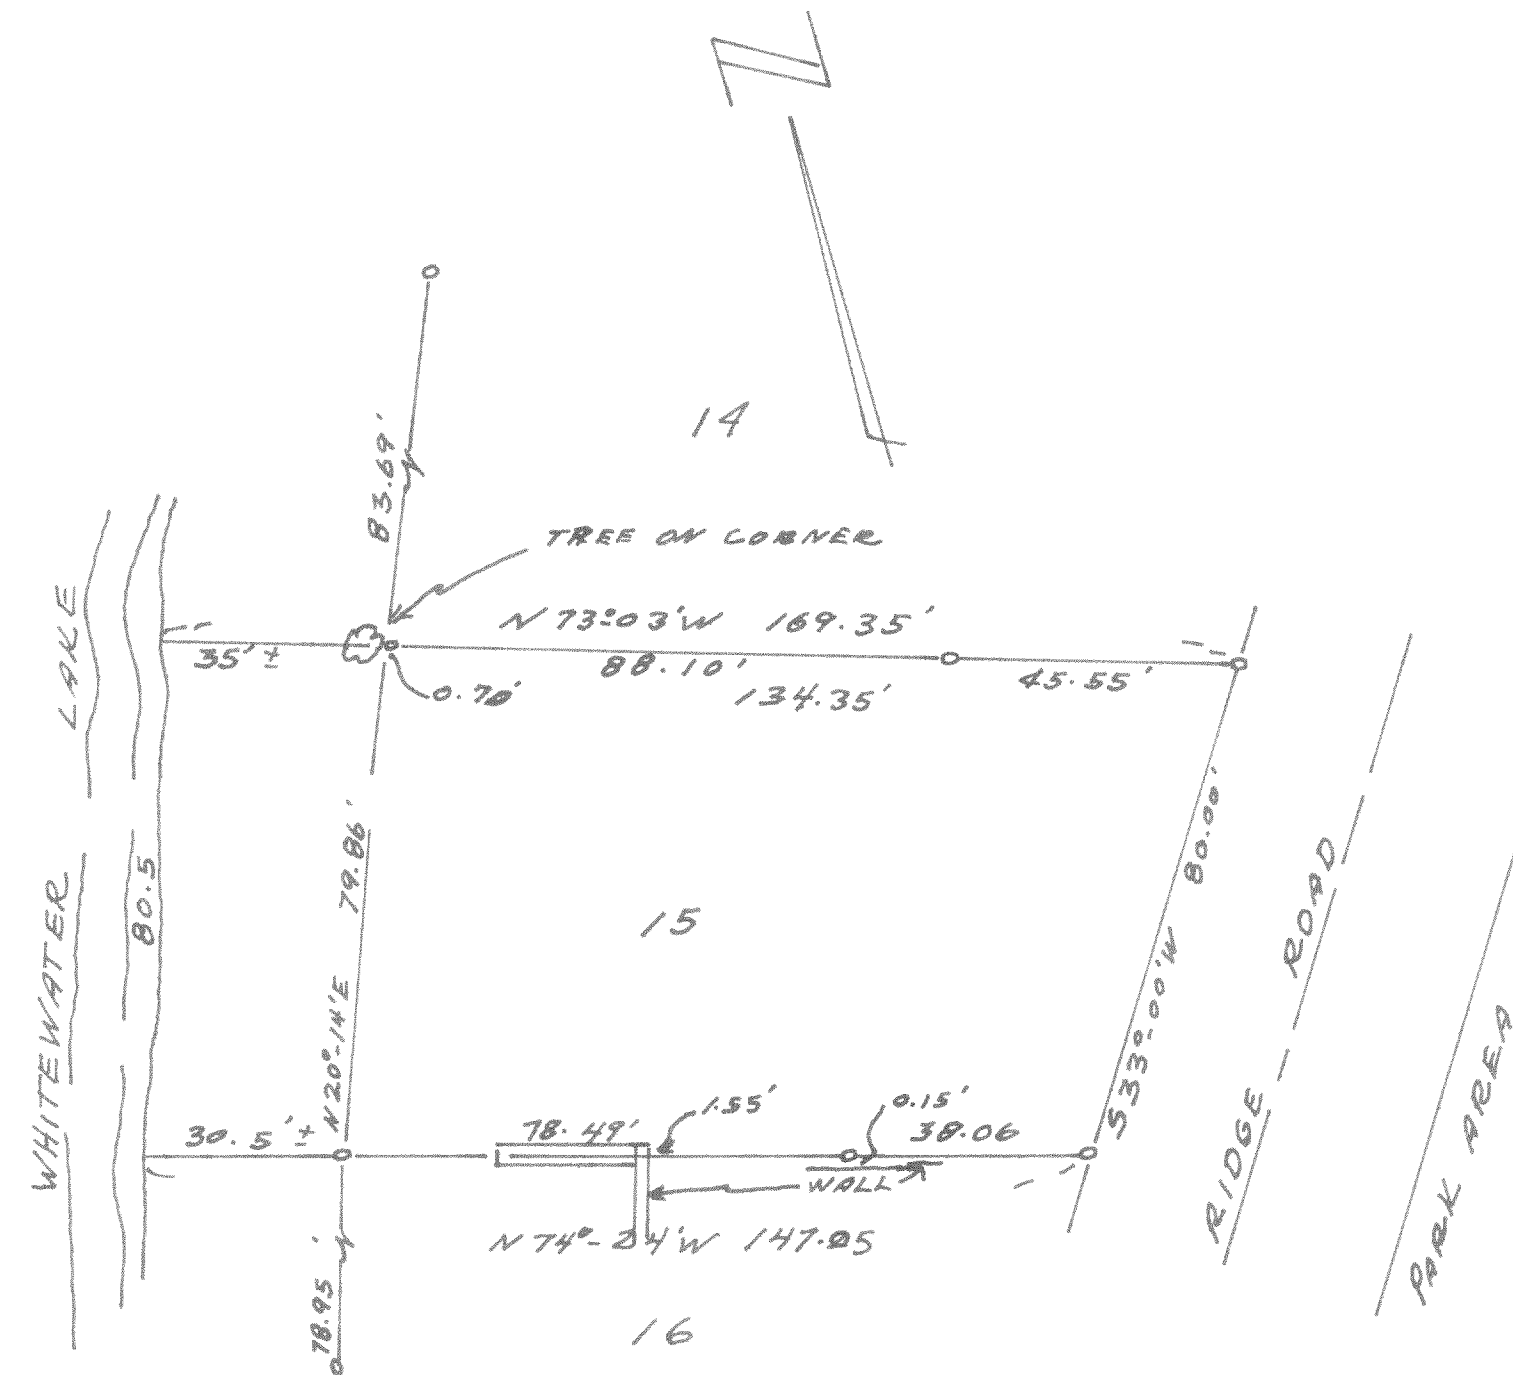

#4620

PLAT OF SURVEY

OF

WALWORTH COUNTY OF WISCONSIN
 THE NORTH 190' OF THE EAST 61.50'
 LOT 5 - OBSERVATORY SUBDIVISION
 SW 1/4 SECTION 1, TAN-RISE, WILLIAMS BAY

MAY 23, 1969

Floyd L. Jensen
 SURVEYOR

