



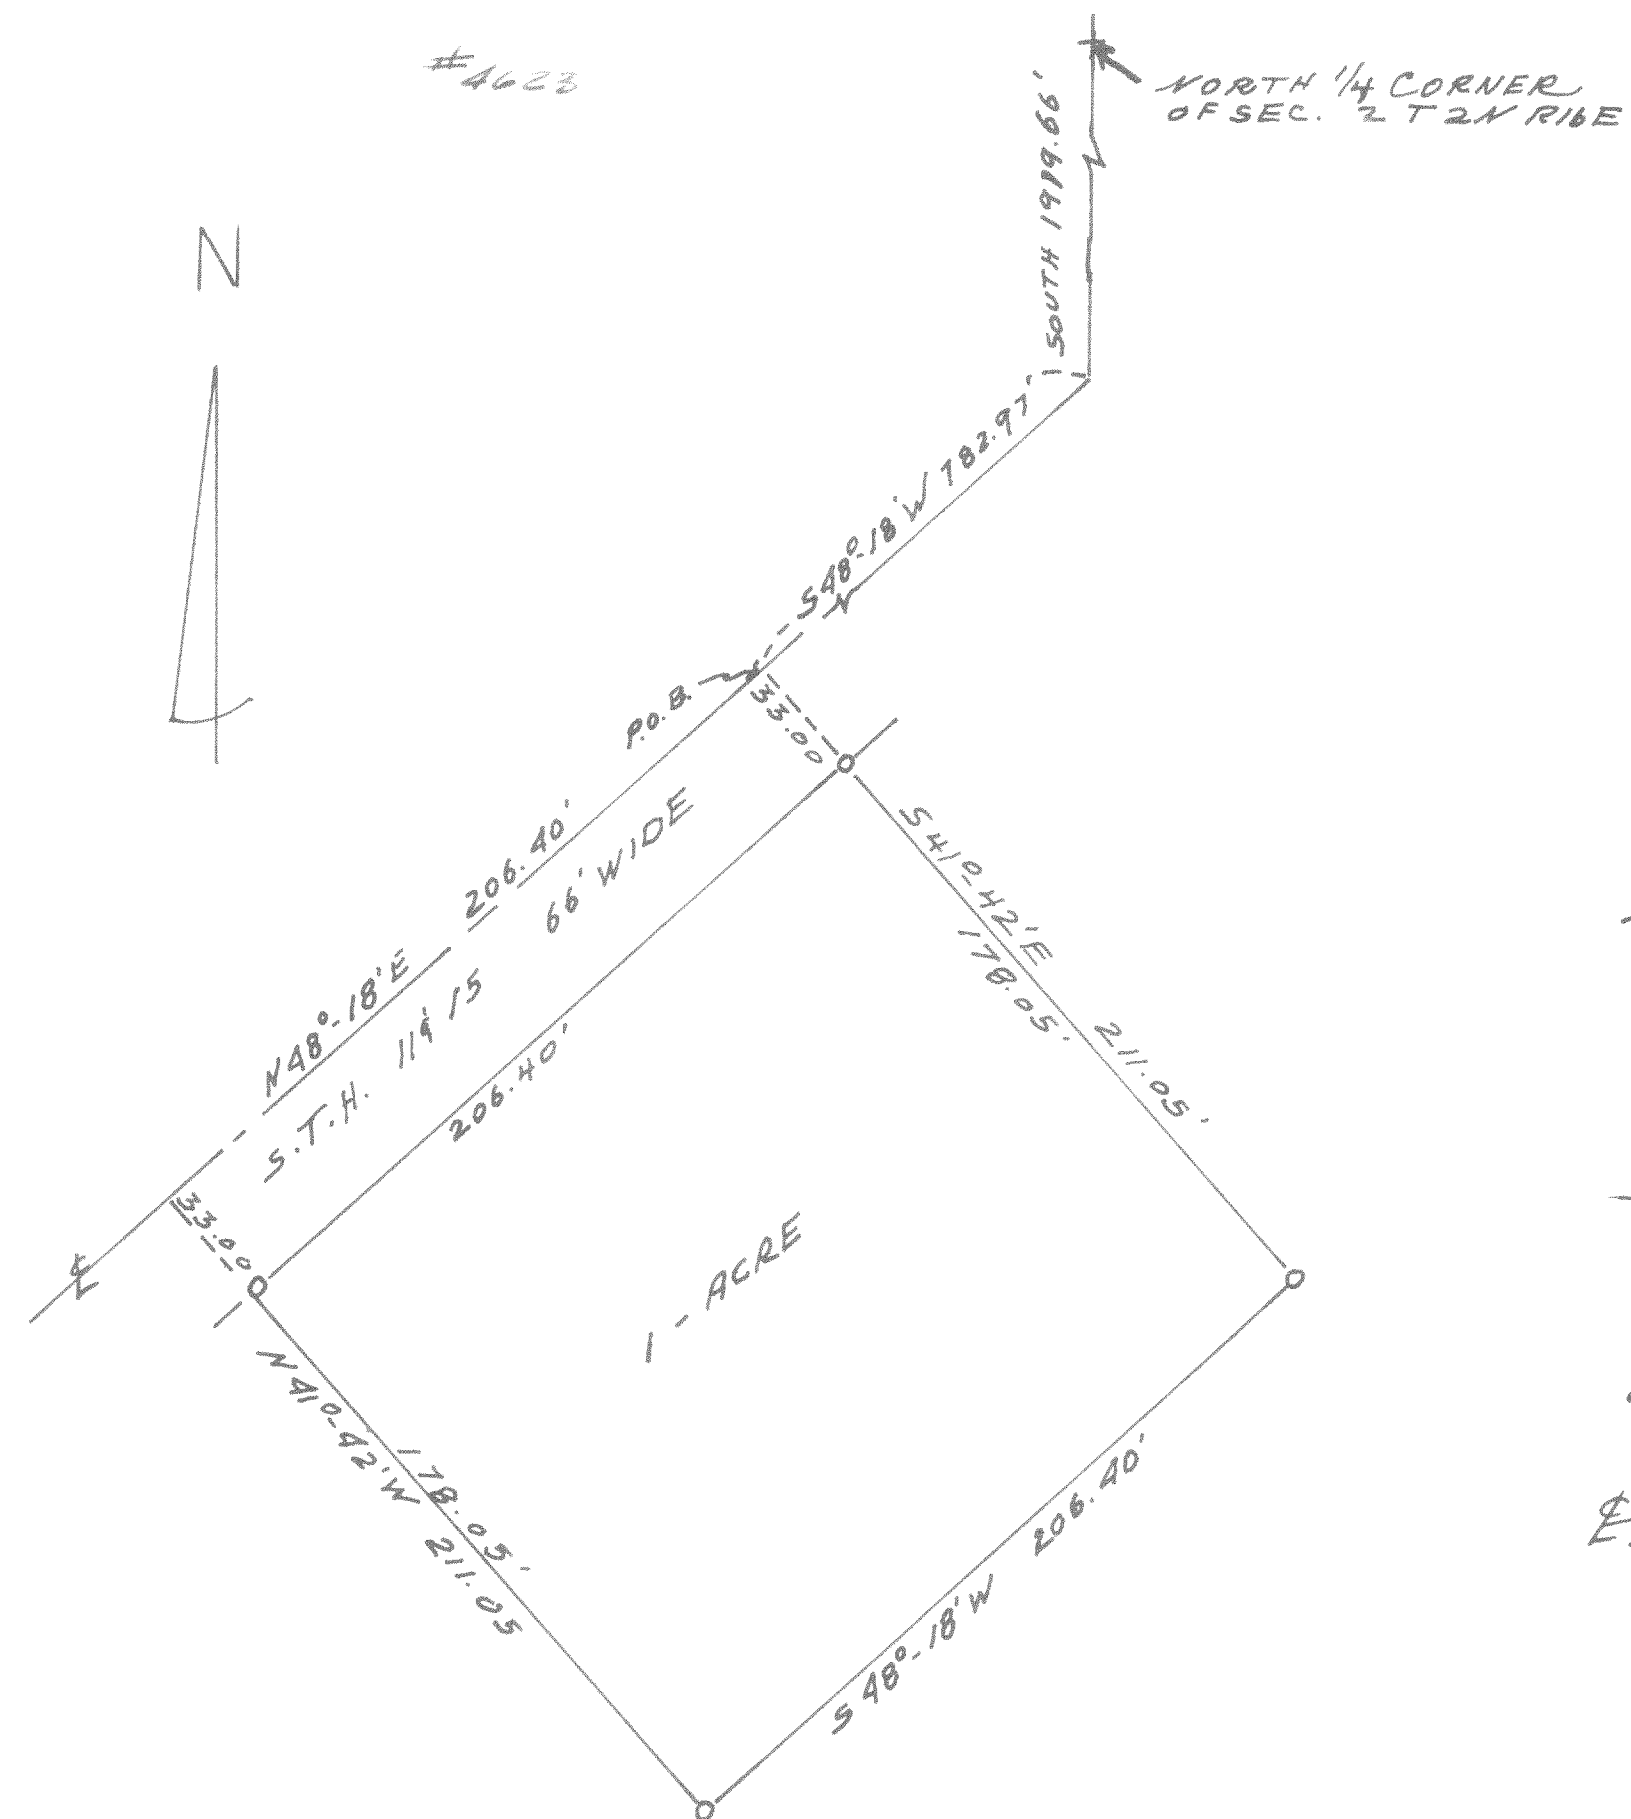

PLAT OF SURVEY
OF
A PARCEL OF LAND LOCATED IN
THE W 1/2 OF SECTION 2, T2N R16E
WALWORTH COUNTY, WISCONSIN.
MARCH 1969

Thos. J. Jensen
SURVEYOR

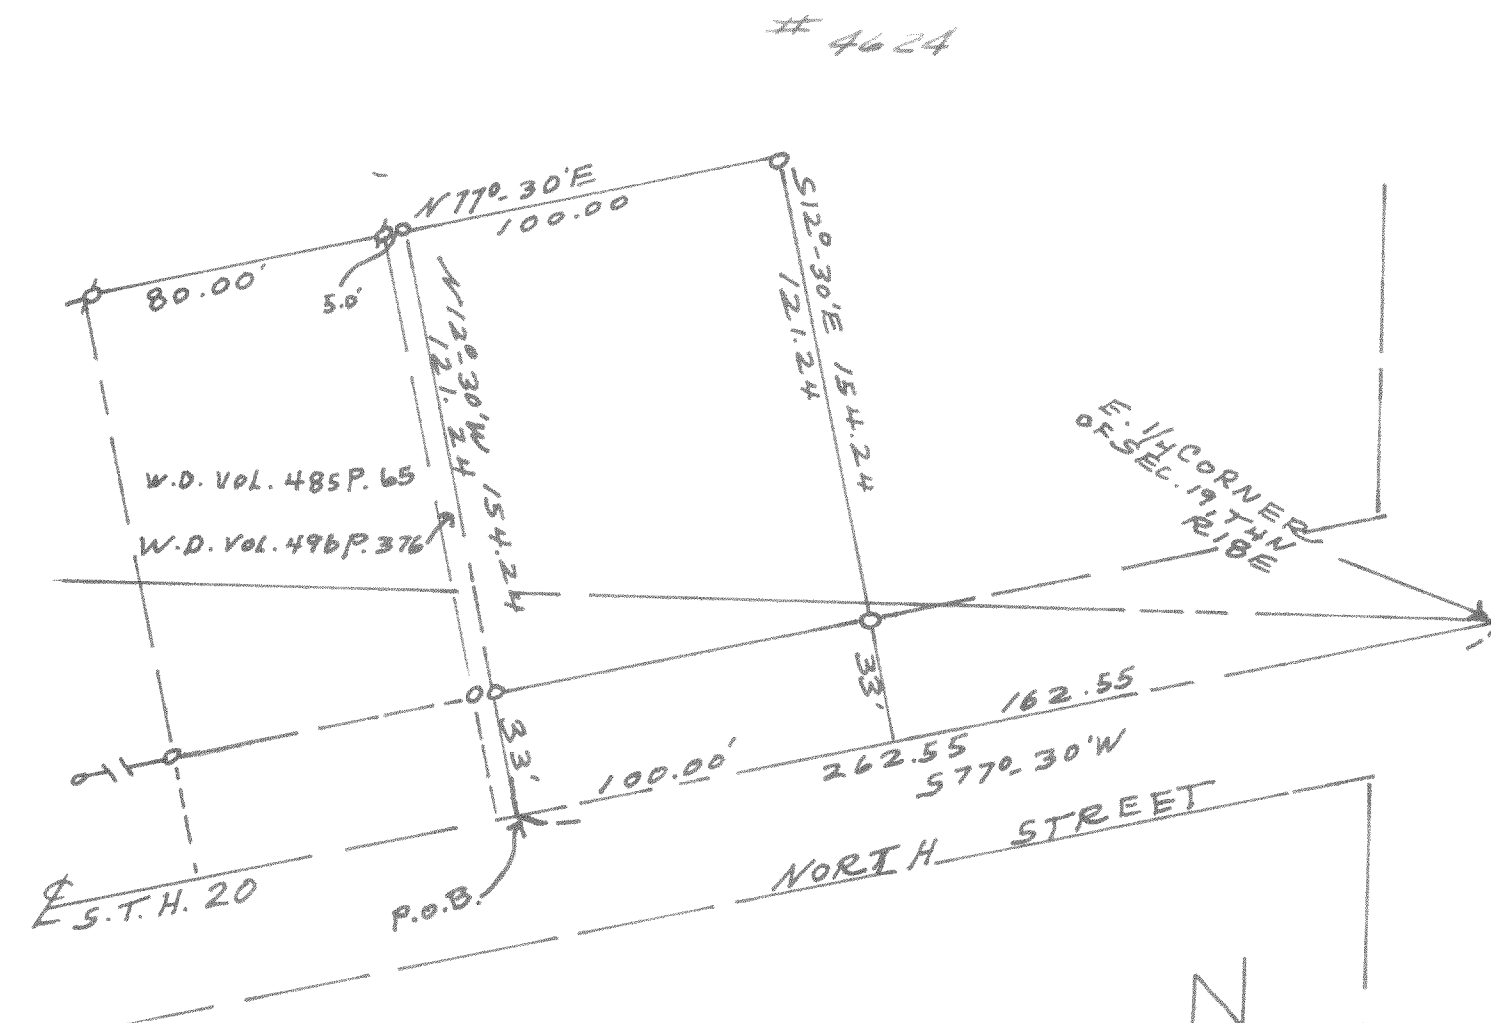

PLAT OF SURVEY
OF
A PARCEL OF LAND LOCATED IN THE
E 1/2 OF SECTION 19, T4N R16E VILLAGE
OF EAST TROY, WISCONSIN.
COMMENCE AT THE E 1/4 CORNER OF SAID
SECTION 19, THENCE S77°-30'W ALONG THE
CENTERLINE OF S.T.H. 20 262.55 FEET TO
THE PLACE OF BEGINNING THENCE N12°-30'W
154.24 FEET, THENCE N77°-30'E 100.00
FEET, THENCE S12°-30'E 154.24 FEET, THENCE
S77°-30'W 100.00 FEET TO THE PLACE OF BEGINNING.
MARCH 1969

Thos. J. Jensen
SURVEYOR