


2945

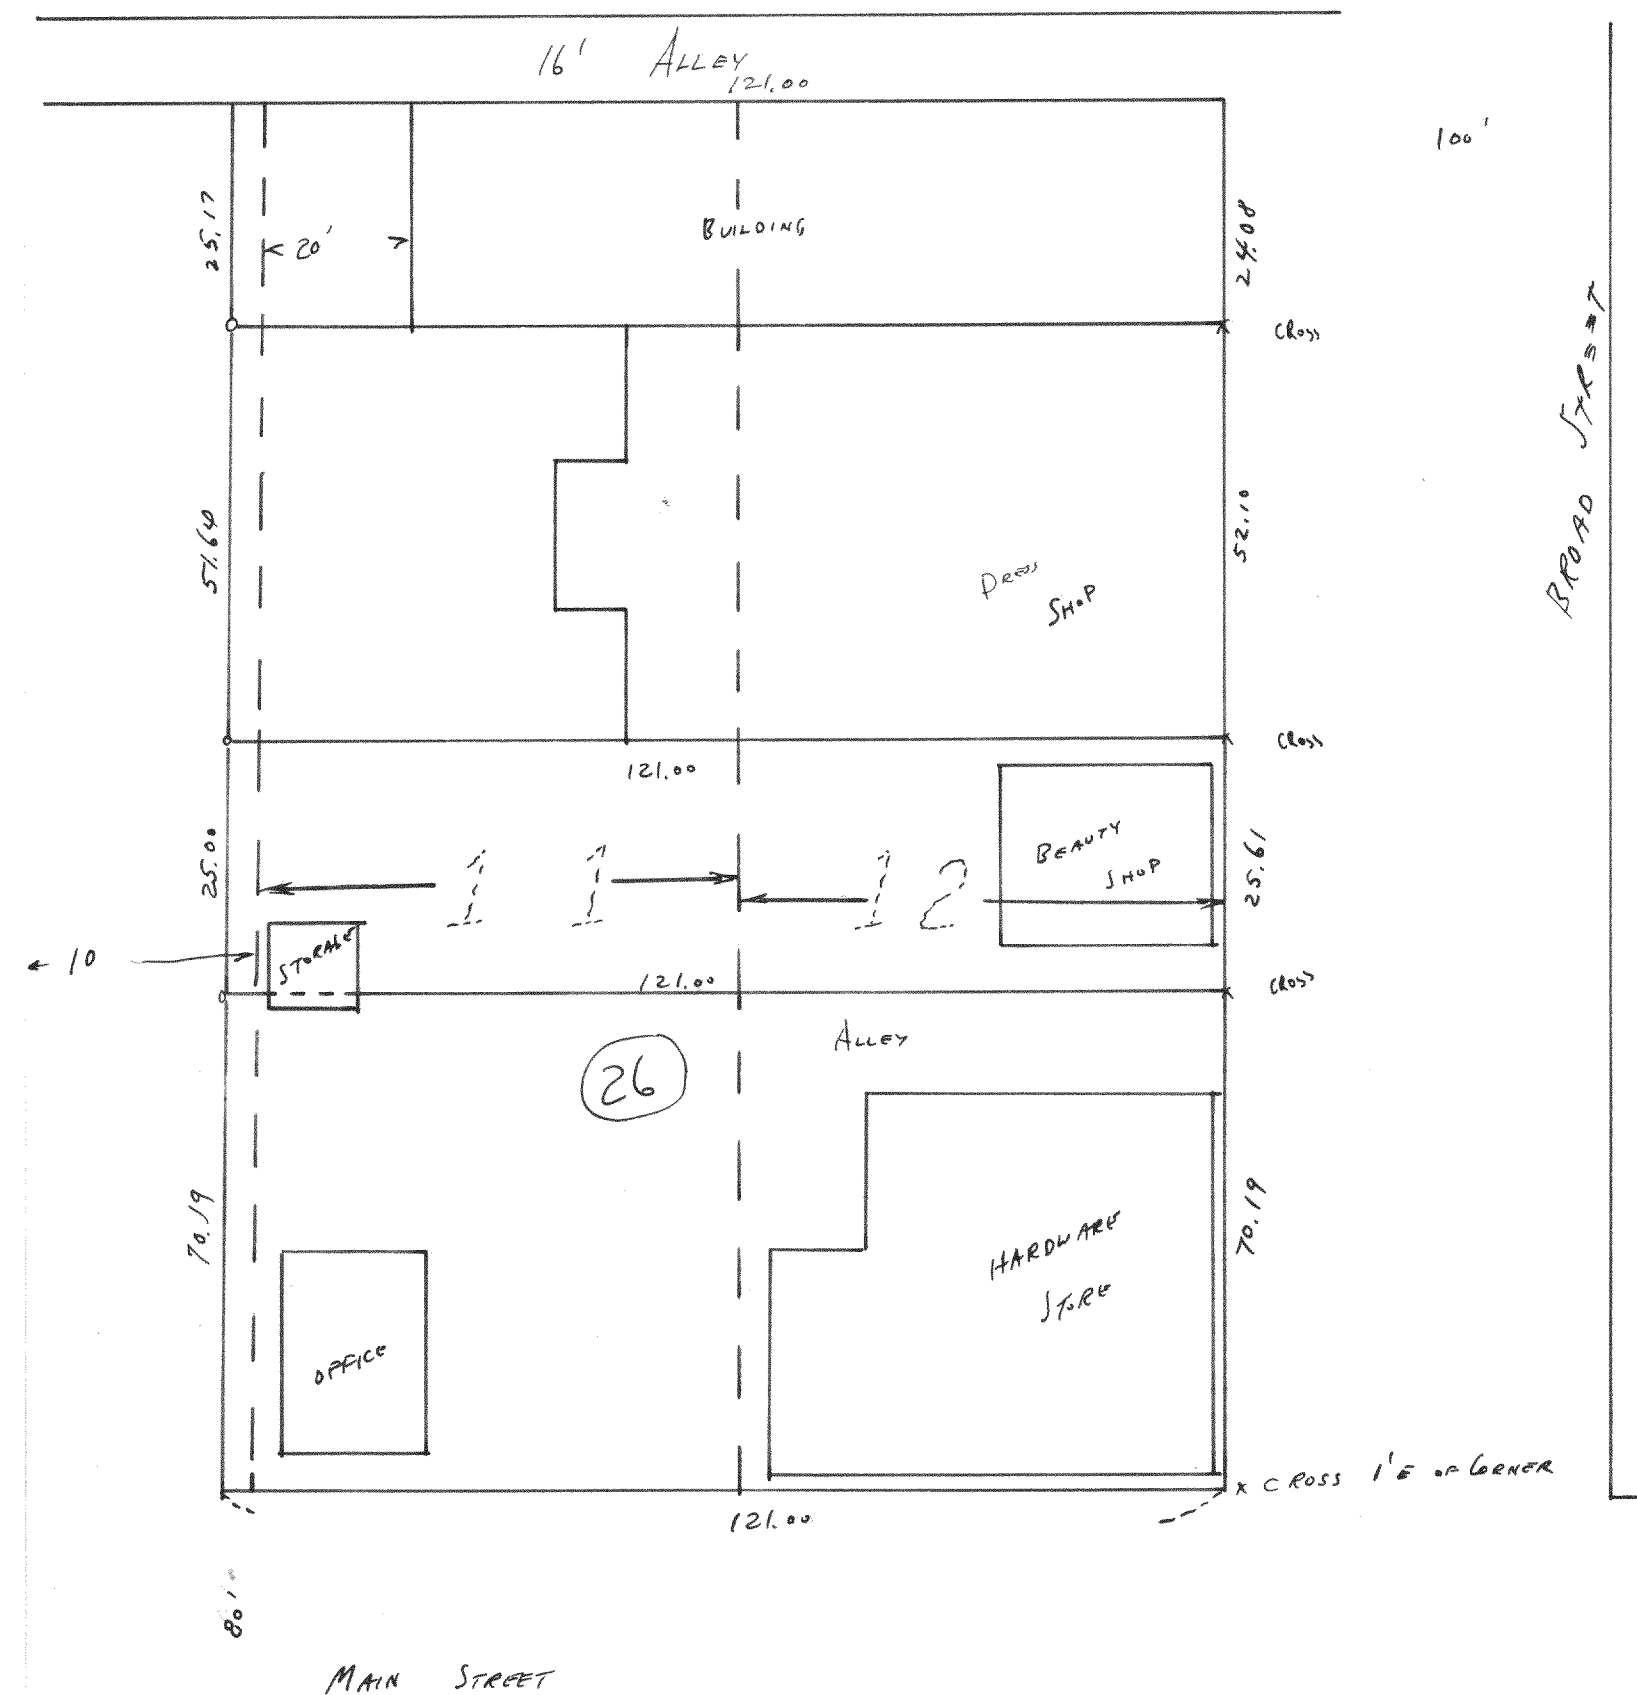


PLAT OF SURVEY OF LOTS 11 AND 12 AND EAST 1/4 OF LOT 10
OF BLOCK 26 OF ORIGINAL CITY OF LAKE GENÈVA,
WALWORTH COUNTY WISCONSIN

June '54


Lloyd S. Jones
County Surveyor

2946

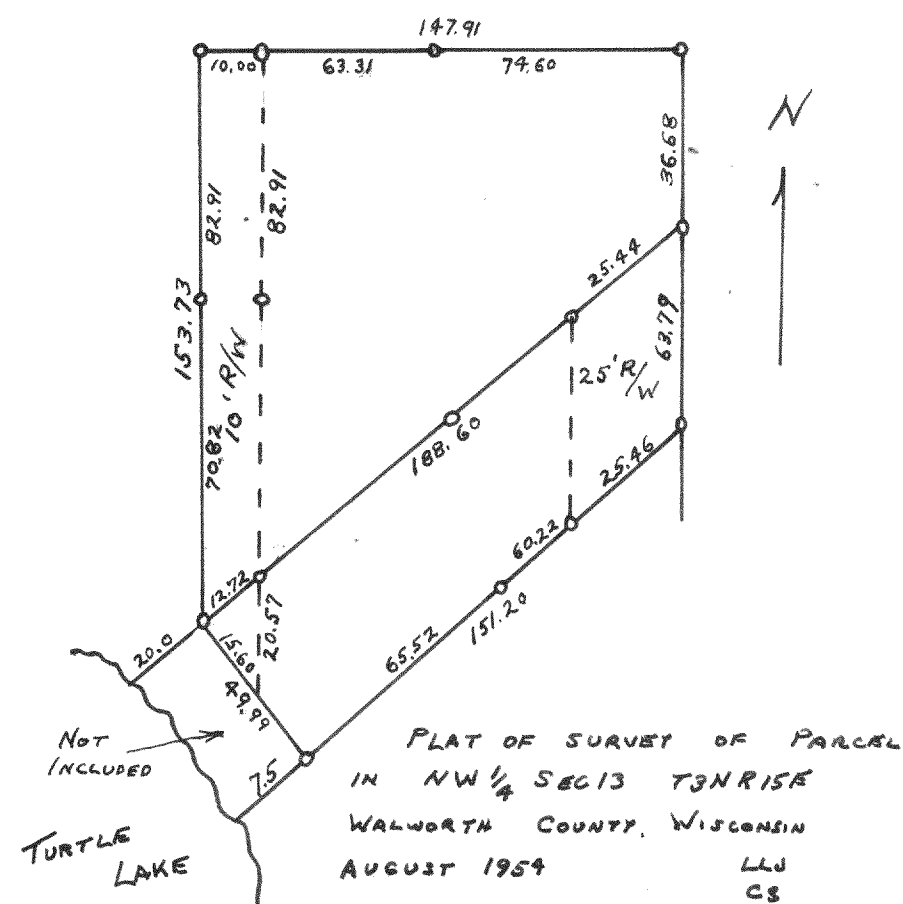


PLAT OF SURVEY OF PARCEL
IN NW 1/4 SEC 13 T39N R15E
WALWORTH COUNTY, WISCONSIN
AUGUST 1954 LLJ

NW CORNER
SECTION 2-3-15
EAST 161.90

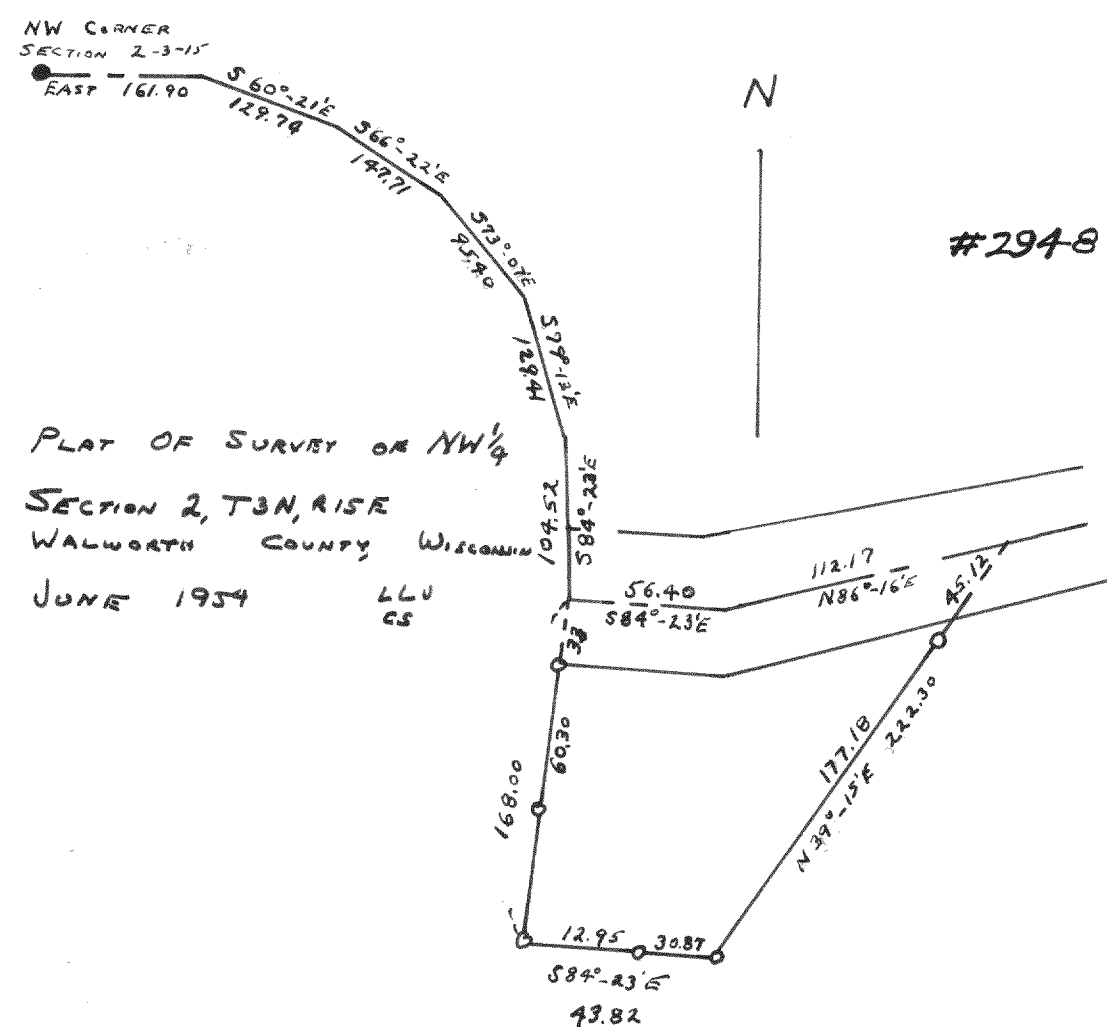

PLAT OF SURVEY ON NW $\frac{1}{4}$
SECTION 2, T3N, R1E
WALWORTH COUNTY, WISCONSIN
JUNE 1954 LLV

2947

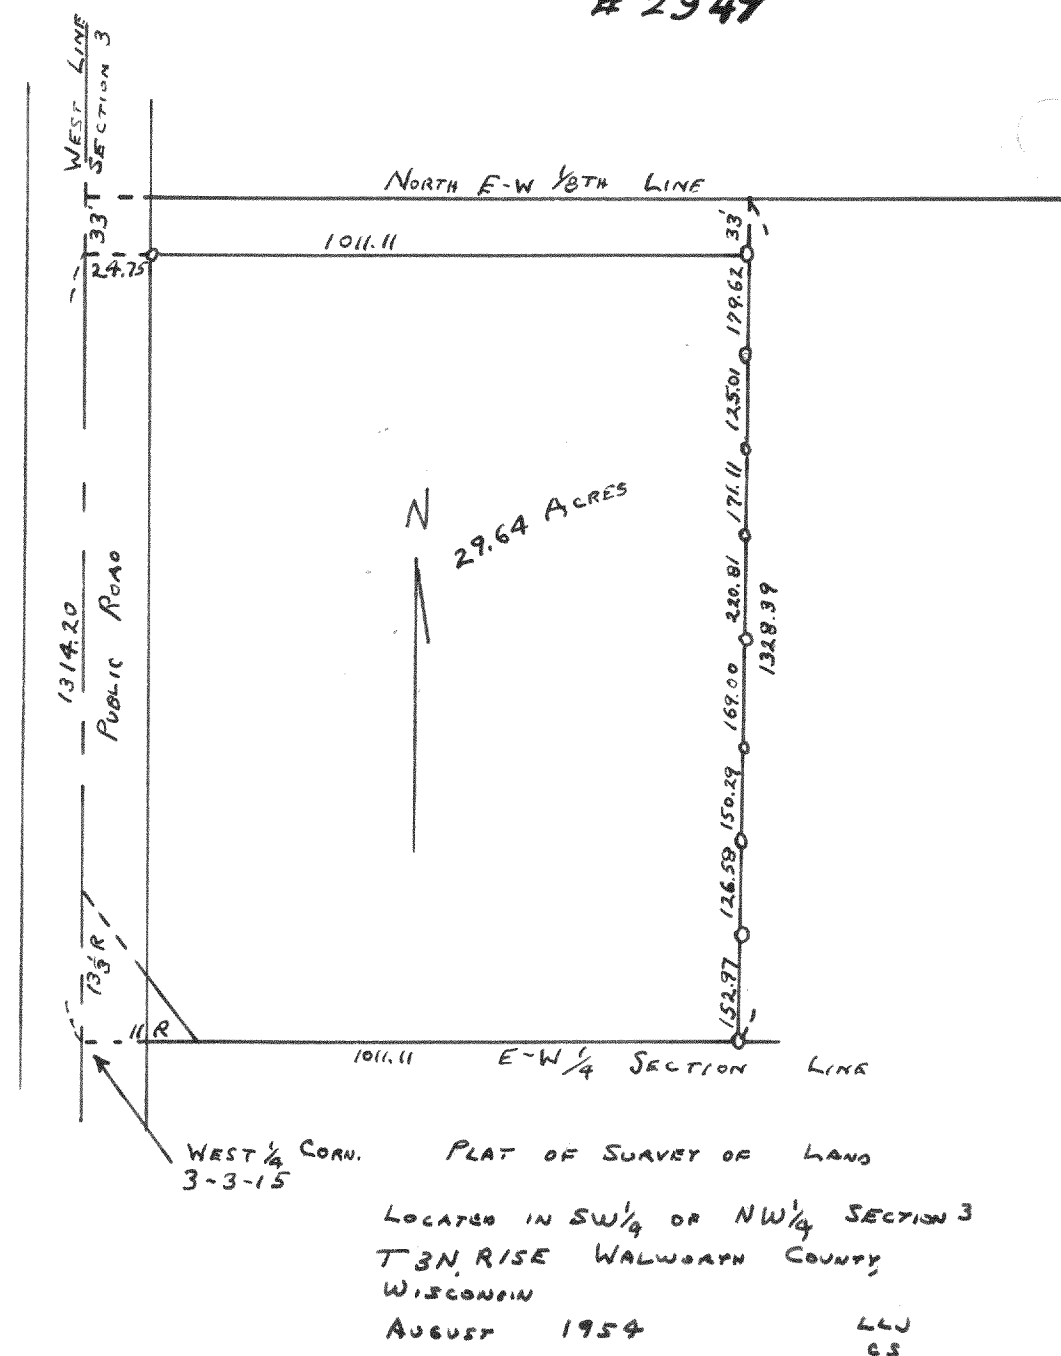

LOCATED IN SW¹/₄ OR NW¹/₄ SECTION 3
T3N. R1E WALWORTH COUNTY,
WISCONSIN
AUGUST 1954 44
CS

#2948