


PLAT OF SURVEY  
OF  
LOT 242 - 3<sup>RD</sup> ADDITION CEDAR  
POINT PARK, VILLAGE OF WILLIAMS  
BAY, WALWORTH COUNTY, WISCONSIN.

JUNE 1969

Clayton J. Jensen  
SURVEYOR

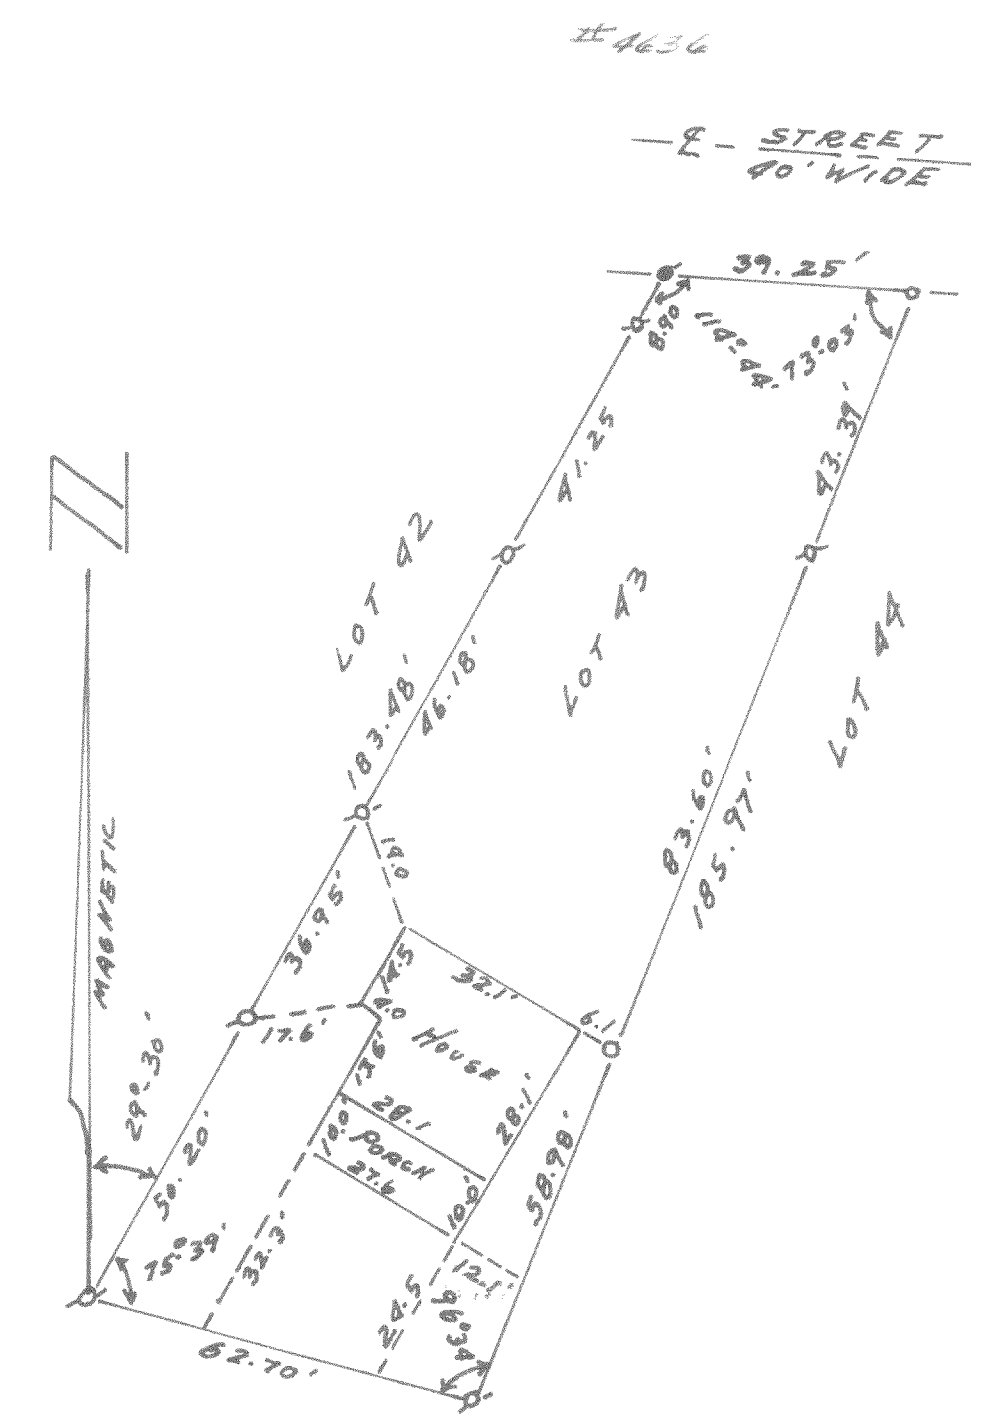

PLAT OF SURVEY  
OF  
LOT 43 - FIRST ADDITION CEDAR POINT  
PARK, VILLAGE OF WILLIAMS BAY,  
WALWORTH COUNTY, WISCONSIN.

JUNE 1969

Clayton J. Jensen  
SURVEYOR