


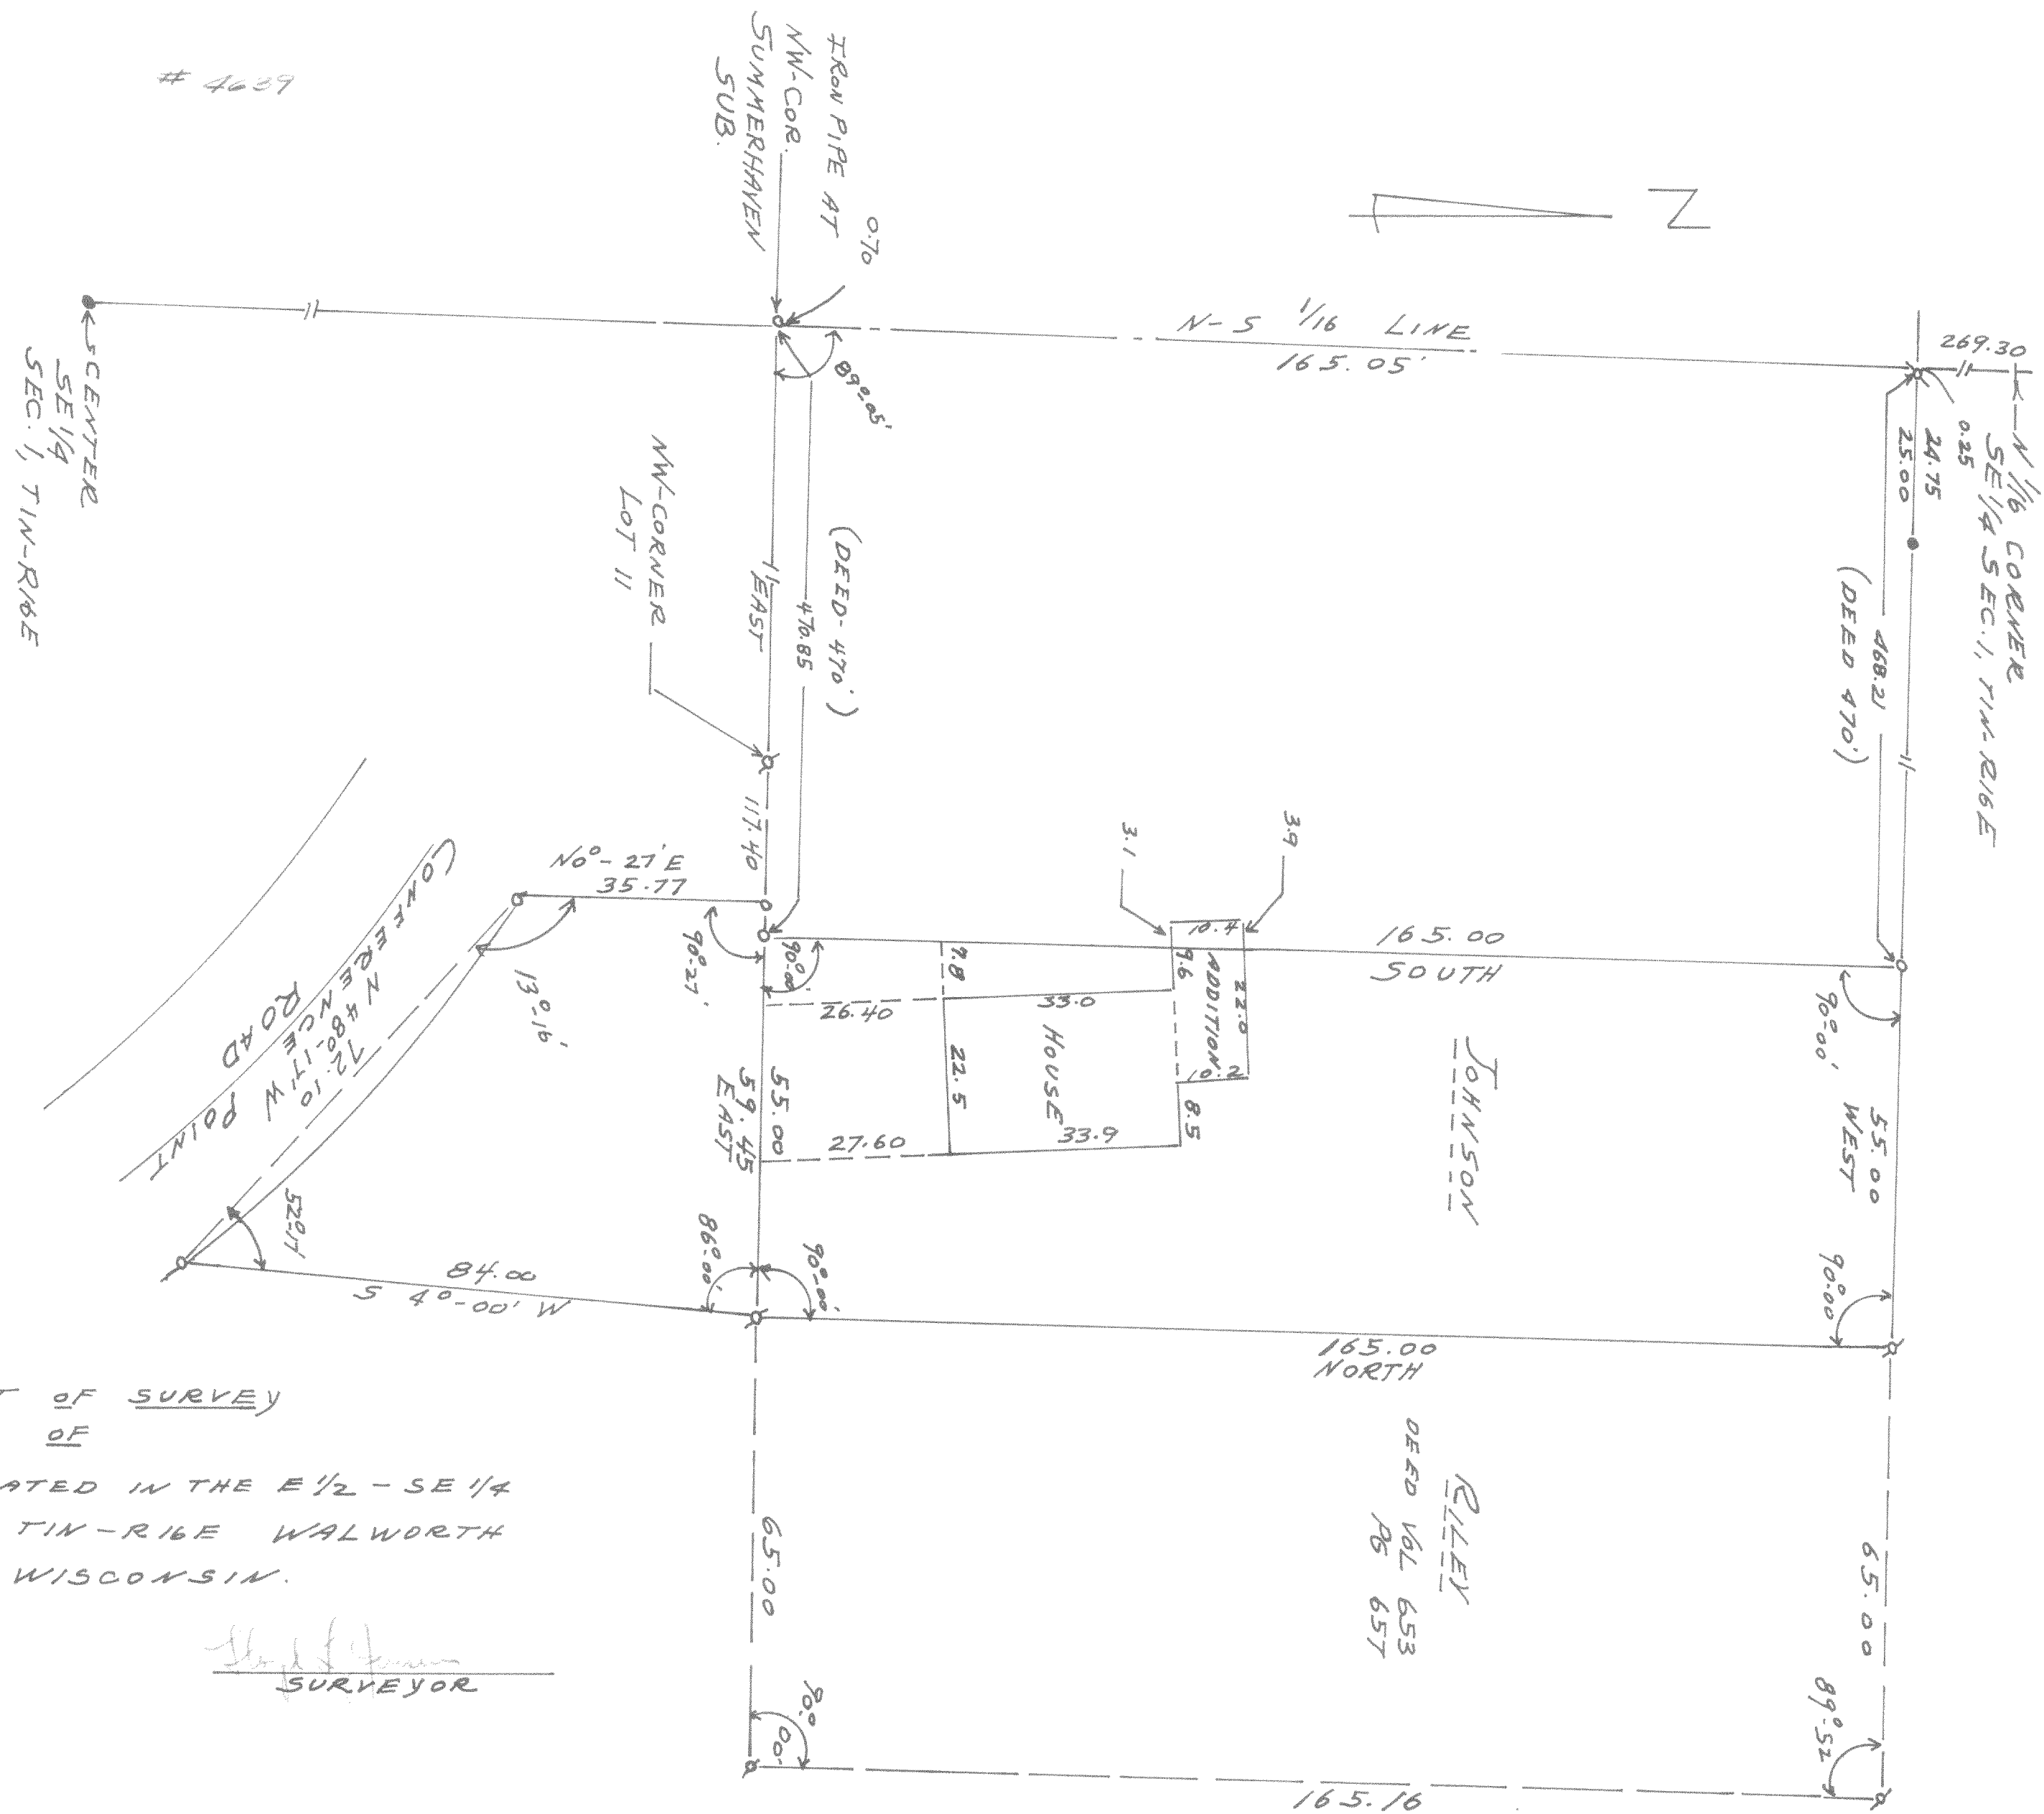

JUNE 27, 1969

Shirley L. Johnson
SURVEYOR