


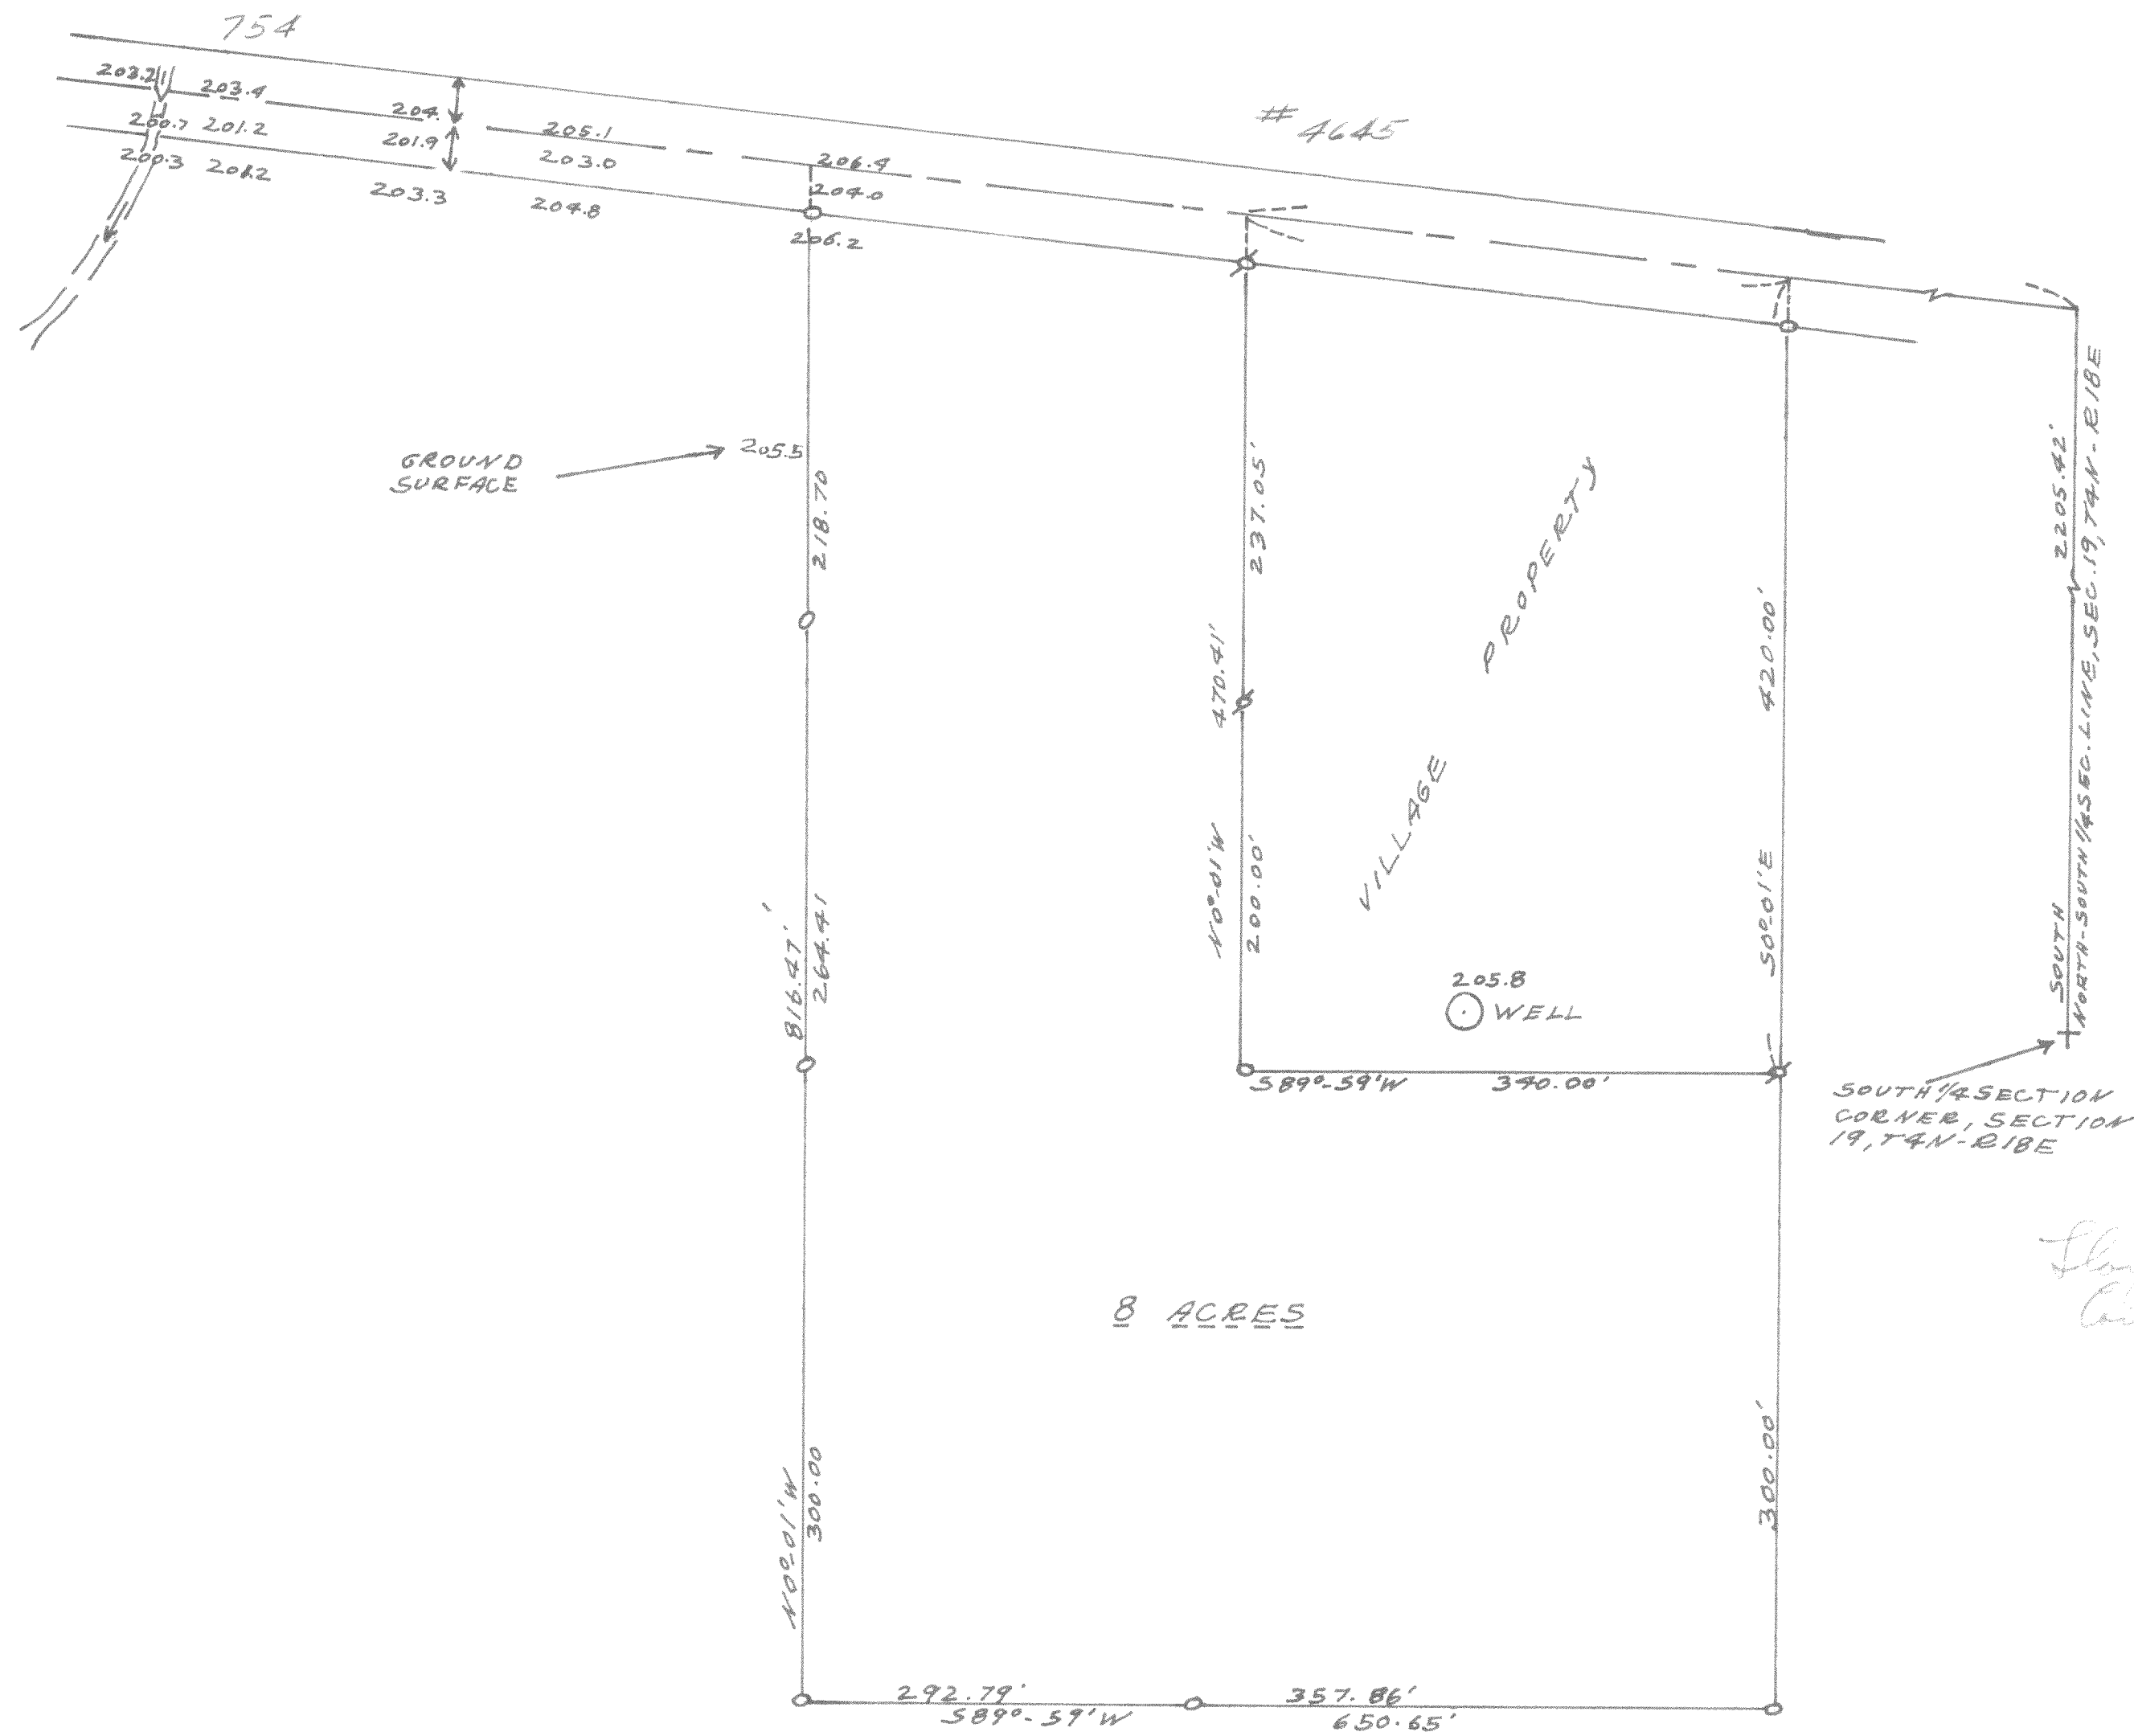

Lloyd S. Jensen
County Surveyor