




4646

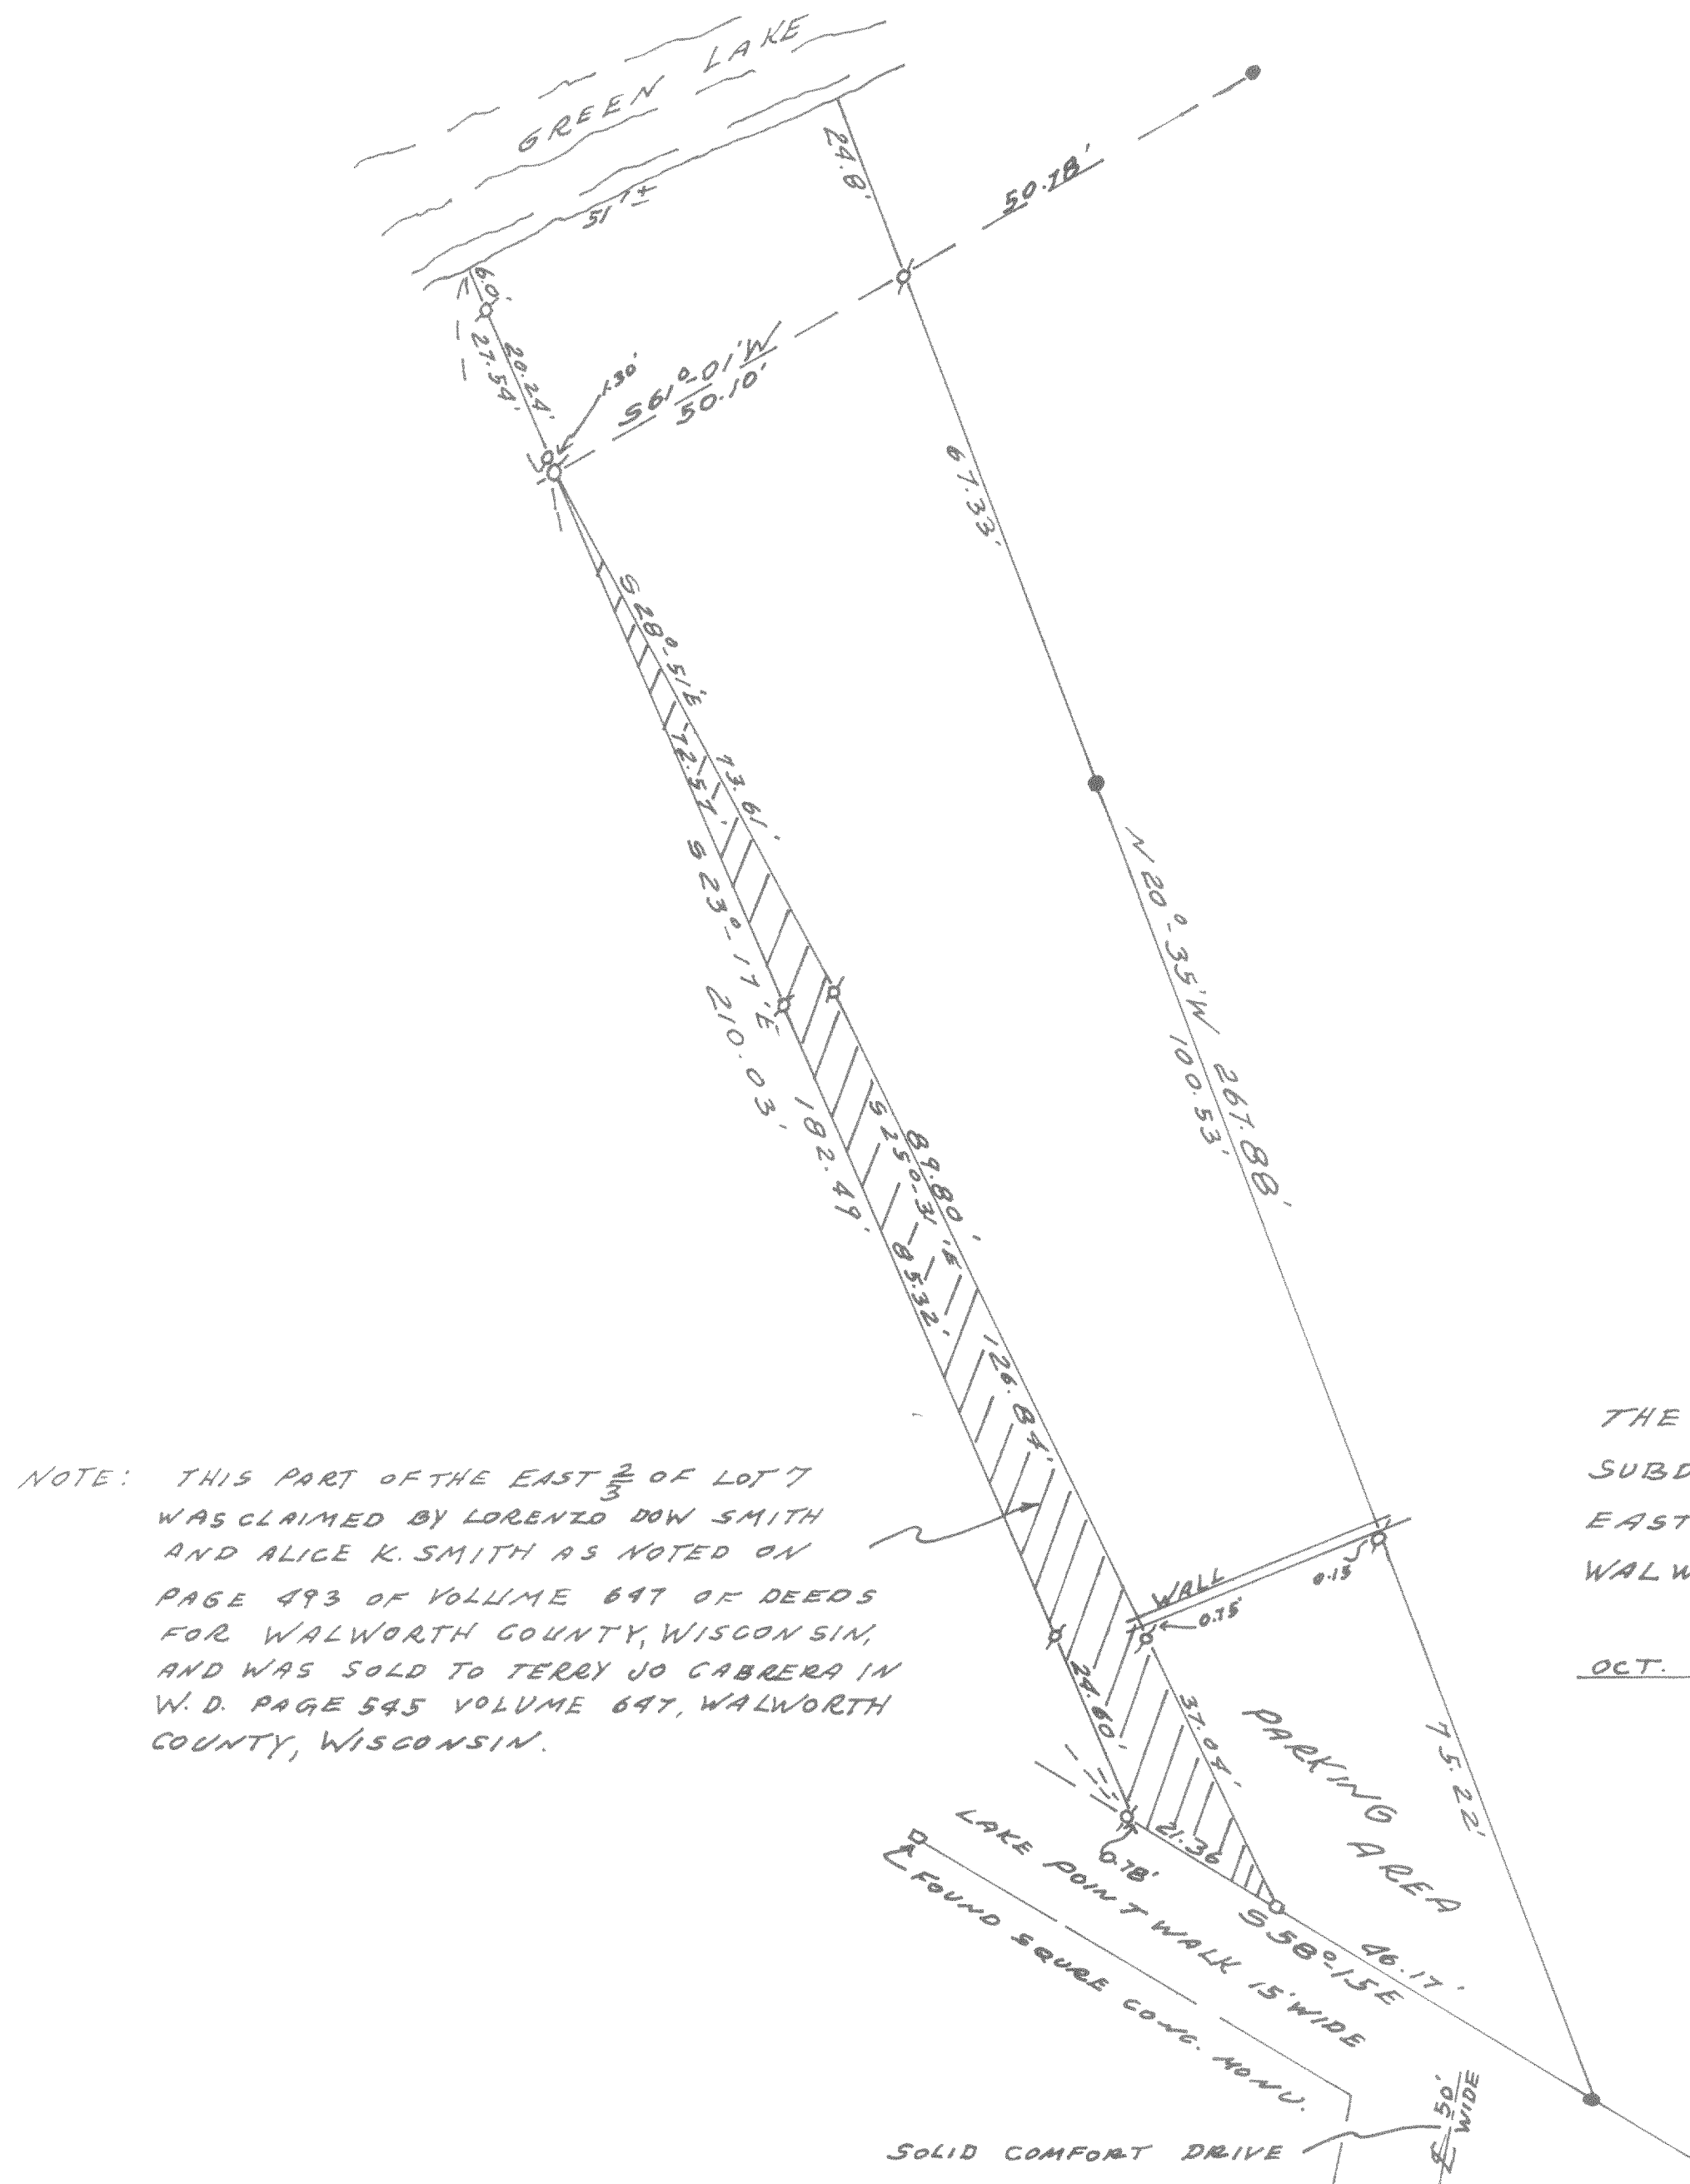

PLAT OF SURVEY

OF

THE EAST $\frac{2}{3}$ OF LOT 7 IN SOLID COMFORT
SUBDIVISION, LOCATED IN THE SOUTH
EAST $\frac{1}{4}$ OF SECTION 26, T4N R16E
WALWORTH COUNTY, WISCONSIN.

OCT. 1969

Flavel F. Jordan
SURVEYOR

NOTE: THIS PART OF THE EAST $\frac{2}{3}$ OF LOT 7 WAS CLAIMED BY LORENZO DOW SMITH AND ALICE K. SMITH AS NOTED ON PAGE 493 OF VOLUME 647 OF DEEDS FOR WALWORTH COUNTY, WISCONSIN, AND WAS SOLD TO TERRY JO CABRERA IN W.D. PAGE 545 VOLUME 647, WALWORTH COUNTY, WISCONSIN.