


- CURVE DATA**
- ① C = N46°-54'-15"E 38.53 / = 100°-48'-30" R = 25.00'
 - ② C = N78°-32'-05"W 19.43' / = 8°-18'-50" R = 134.00'
 - ③ C = N83°-57'-21"W 66.56' / = 19°-09'-23" R = 200.00'
 - ④ C = N51°-03'-40"E 40.74' / = 109°-07'-20" R = 25.00'

NOTE: SURVEYOR'S CERTIFICATE FOR ADDITION NO 1
 TO ROSE CREST ADDITION GIVES THE DISTANCE
 FROM THE WEST 1/4 SECTION CORNER OF SEC.
 5, T4N R15E AS 1333.78 FEET. A FIELD
 SURVEY OF THIS LINE FOUND THIS DISTANCE
 TO BE 1335.30 FEET. THE FIELD SURVEY
 GIVES AN OVER RUN OF 1.52 FEET. NO
 NO EFFORT WAS MADE TO APPORTION
 THIS OVER RUN AMONG THE PROPERTIES
 BETWEEN THE WEST 1/4 SECTION CORNER
 OF SEC. 5 AND THE SOUTHWEST CORNER
 OF ROSE CREST ADDITION.

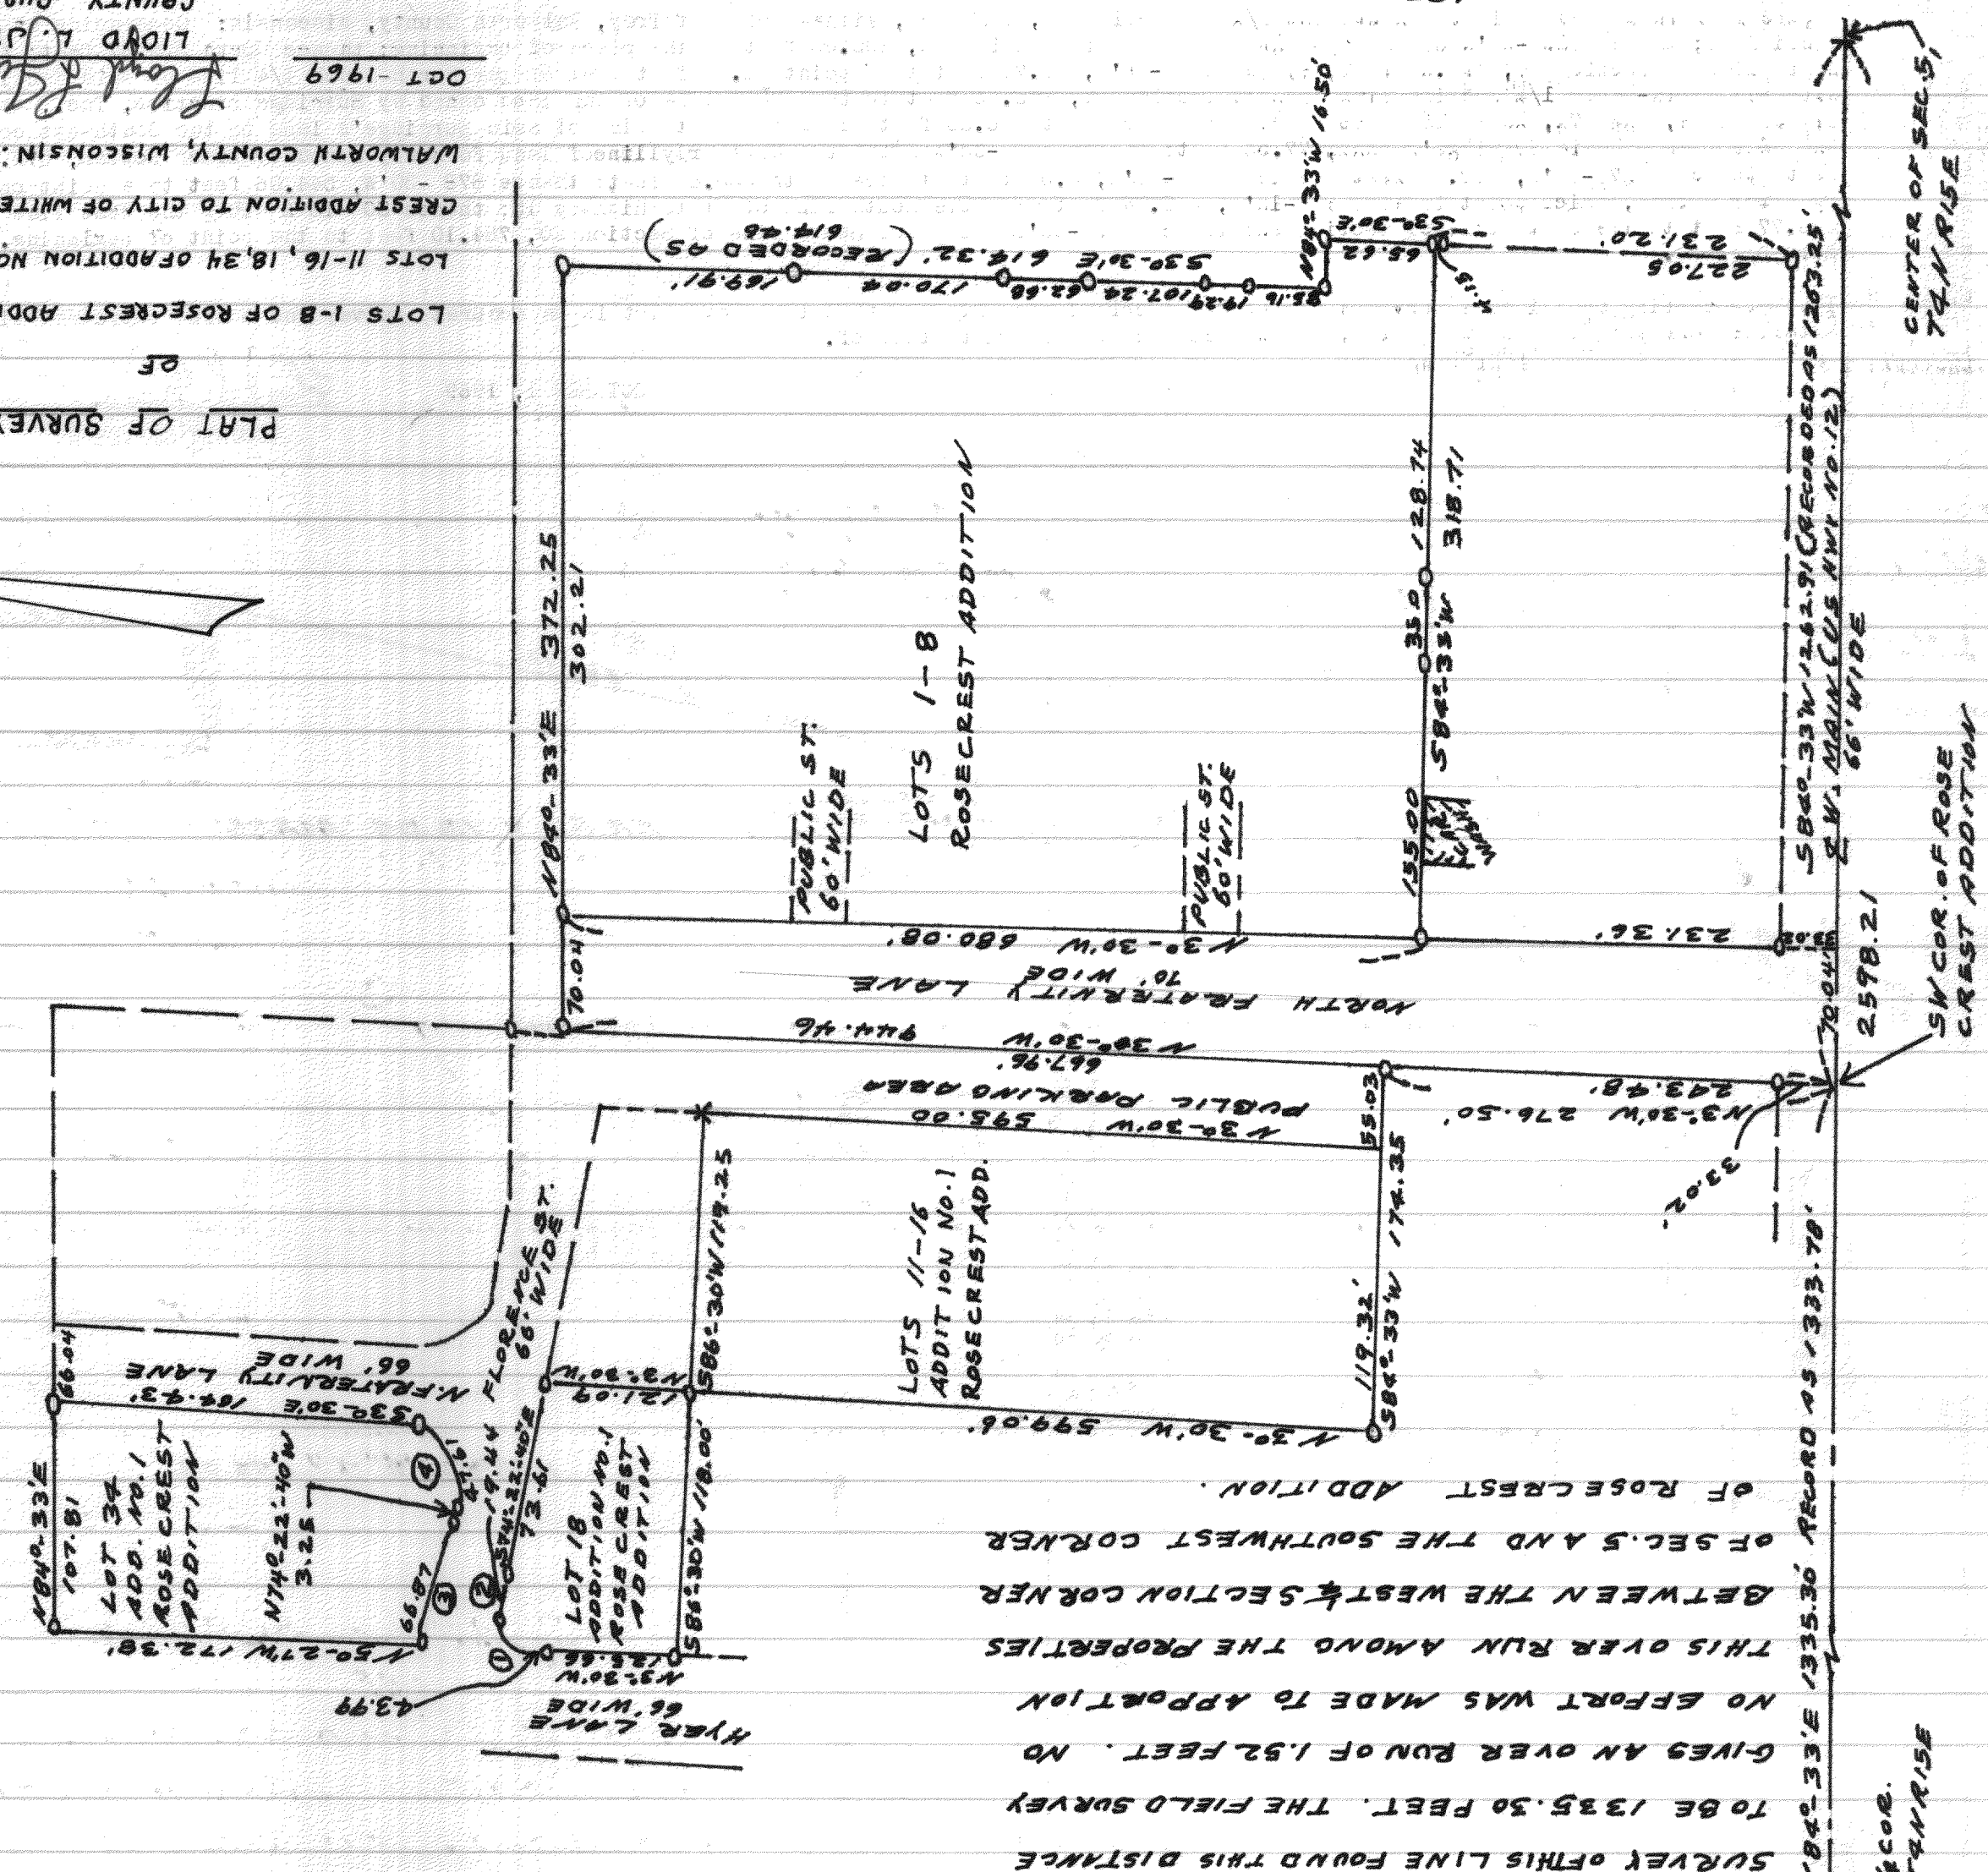

PLAT OF SURVEY
 OF
 LOTS 1-8 OF ROSECREST ADDITION AND
 LOTS 11-16, 18, 34 OF ADDITION NO. 1 TO ROSE
 CREST ADDITION TO CITY OF WHITEWATER,
 WALWORTH COUNTY, WISCONSIN.
 OCT 1969
 Lloyd L. Jensen
 LLOYD L. JENSEN
 COUNTY SURVEYOR