


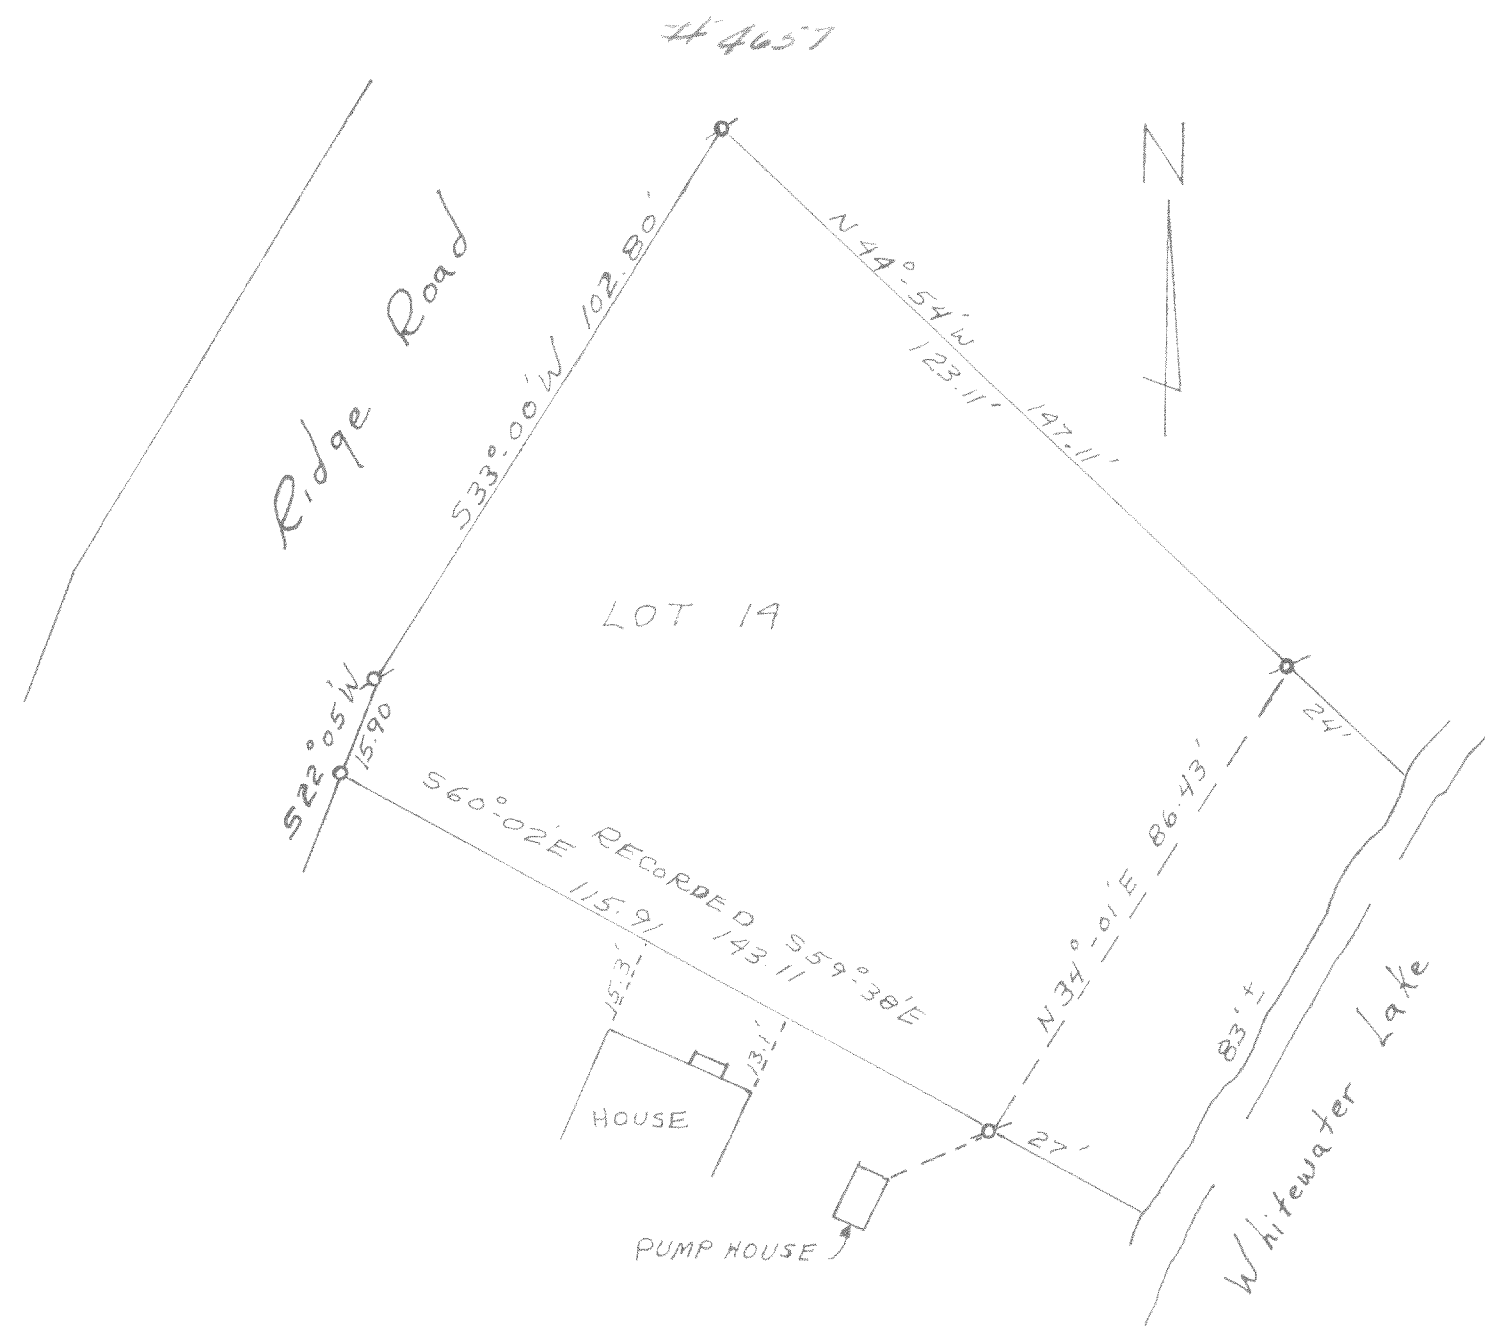


- ✕ IRON PIPE FOUND
○ IRON PIPE SET

PLAT OF SURVEY
OF
Lot 14 Block 1 Moraine Heights Subdivision
Located in Sections 26 & 35 T4N R15E
Walworth County, Wis.

MAY 1969


 COUNTY SURVEYOR

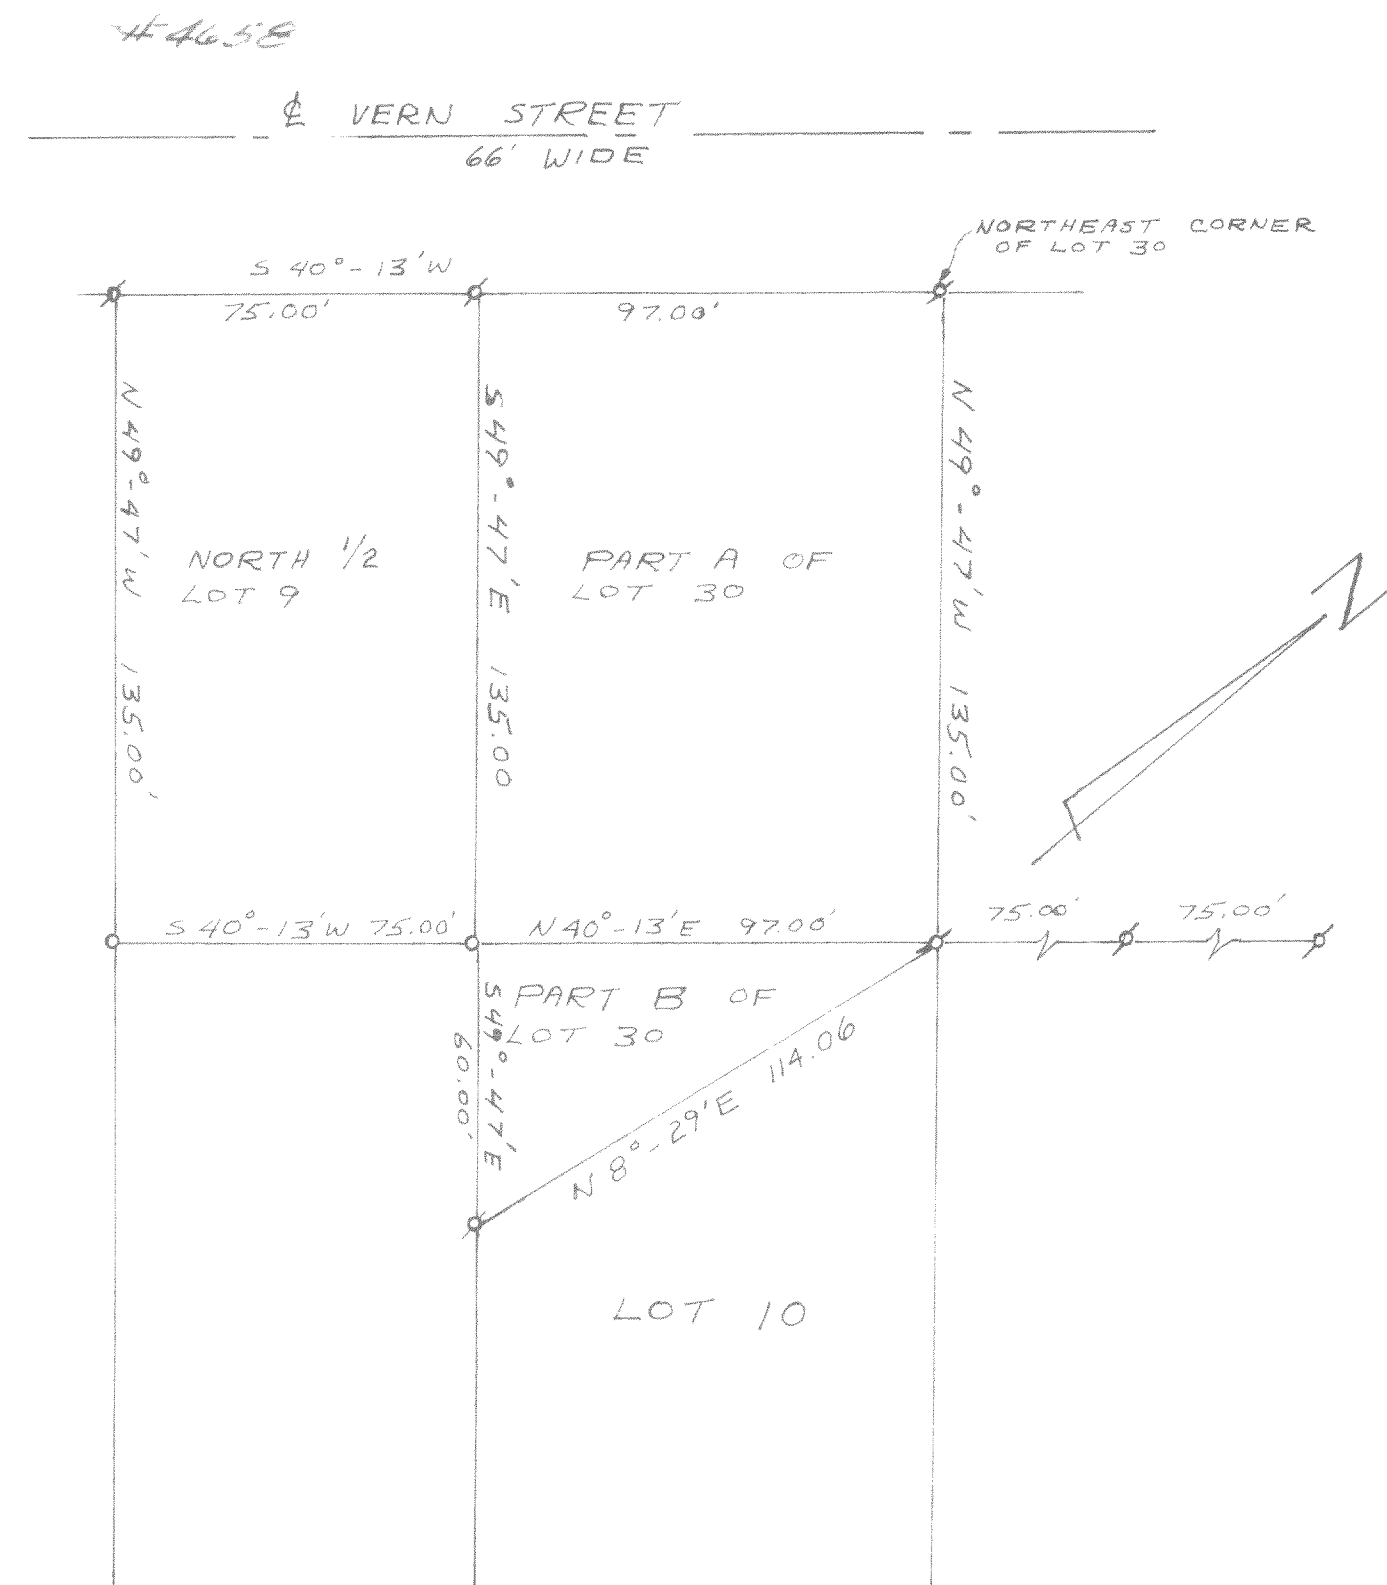

- 0 IRON PIPE SET
Ø IRON PIPE FOUND

PLAT OF SURVEY
OF
THE NORTH $\frac{1}{2}$ OF LOT 9 & LOT 30 OF BLOCK 3
OF GRANDVIEW SUBDIVISION LOCATED IN
SECTION 34, TAN RISE WAL. CO. WISC.

OCT- 1969


 COUNTY SURVEYOR