

4664





4665

PLAT OF SURVEY
OF

ACCESS RIGHT OF WAY TO
BEULAH LAKE, LOCATED IN
THE NORTHEAST FRACTIONAL 1/4
OF SECTION 9, T4N R1E,
WALWORTH COUNTY, WISCONSIN.

JUNE 24, 1969

Lloyd L Jensen
SURVEYOR

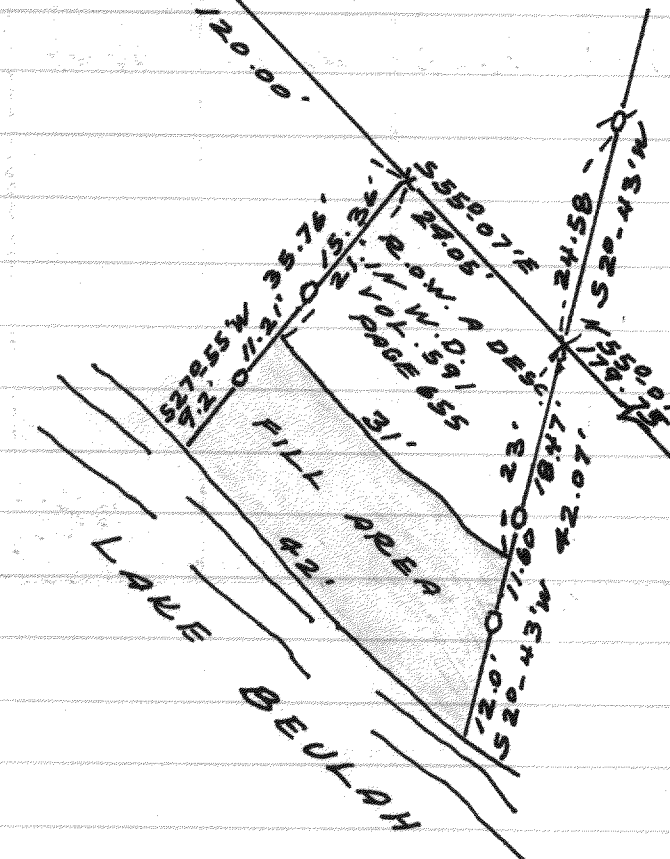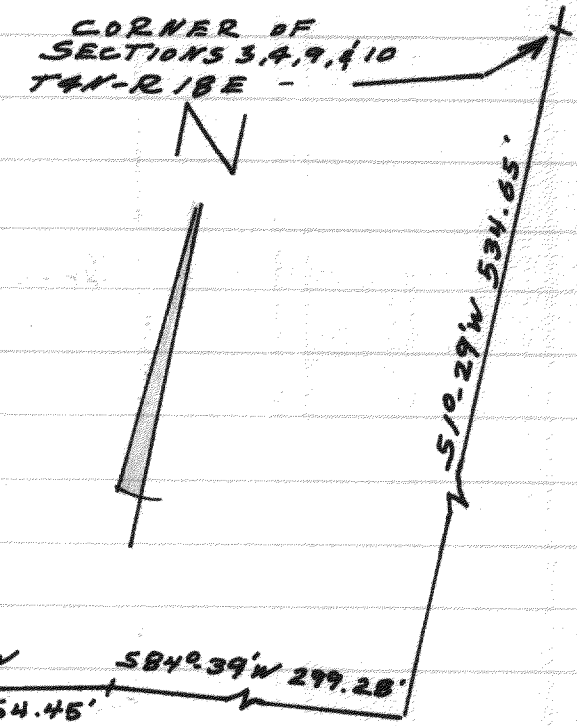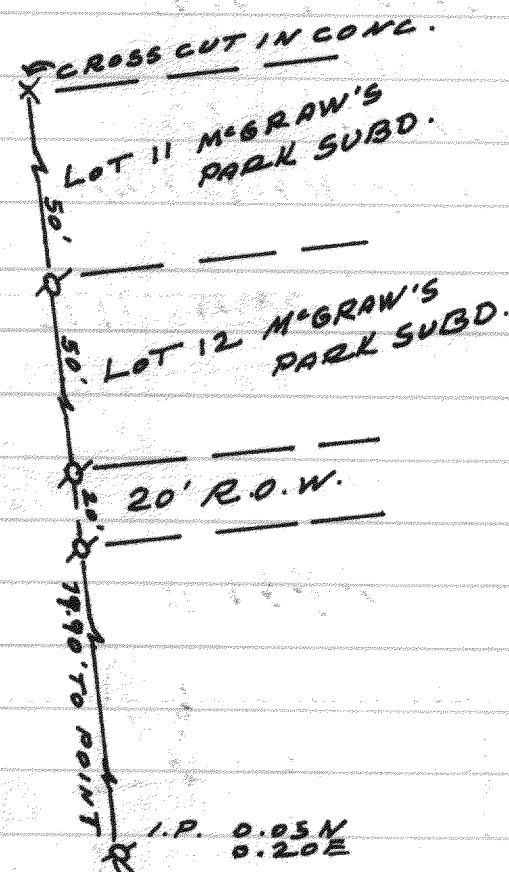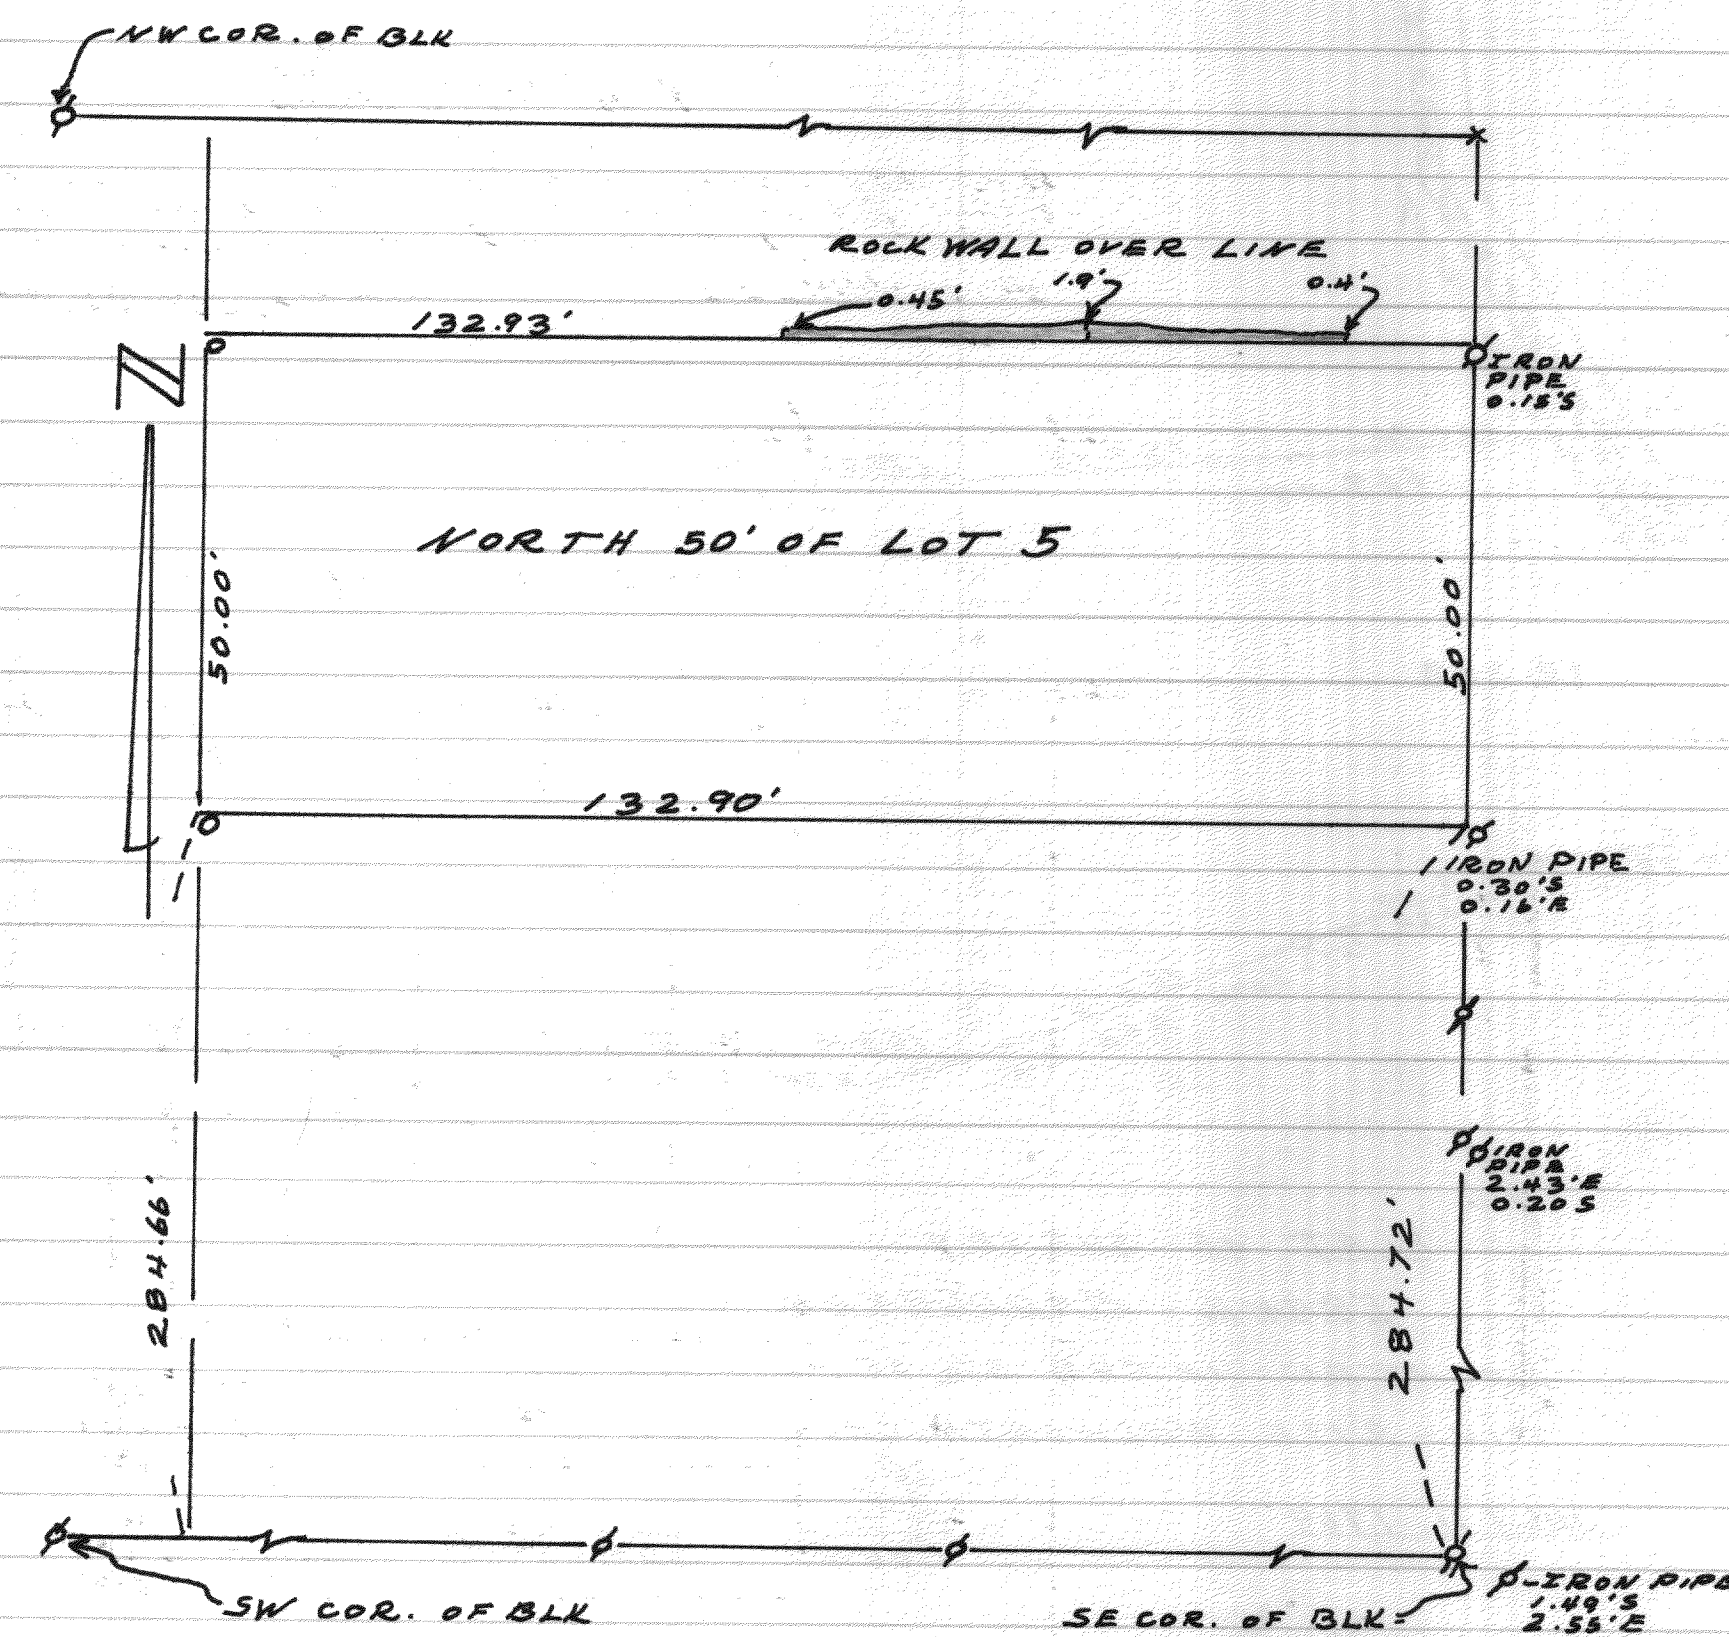

PLAT OF SURVEY
OF

THE NORTH 50.00' OF LOT 5, BLOCK 8,
ORIGINAL PLAT CITY OF ELKHORN, WISC.

JUNE 1969

Lloyd L Jensen
SURVEYOR

Ø - IRON PIPE FOUND
O - IRON PIPE SET