


#4669

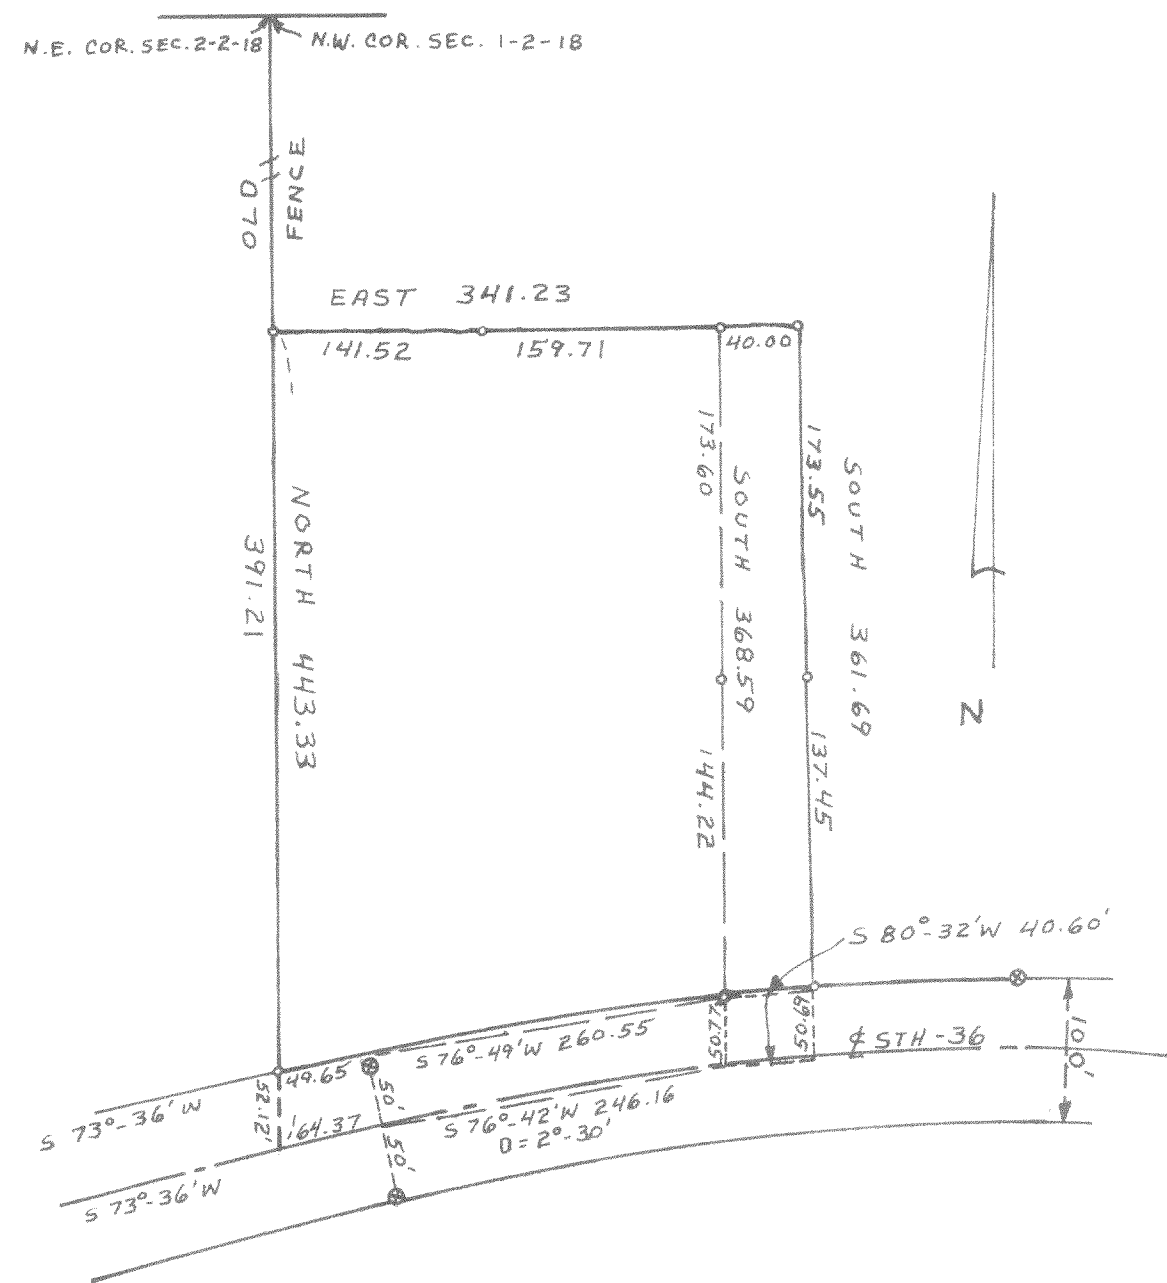

2.732 ACRES NORTH OF HIGHWAY
0.401 ACRES HIGHWAY R.O.W.
3.133 ACRES TOTAL

- o IRON PIPE
- ⊗ R.O.W. POST

SURVEY OF PLAT


OF

PARCEL OF LAND LOCATED IN NW 1/4 OF THE
NW 1/4 OF SECTION 1, T2N, R18E
WALWORTH COUNTY, WISCONSIN

AUGUST 29, 1969

Shay L. Jensen
COUNTY SURVEYOR

#4670

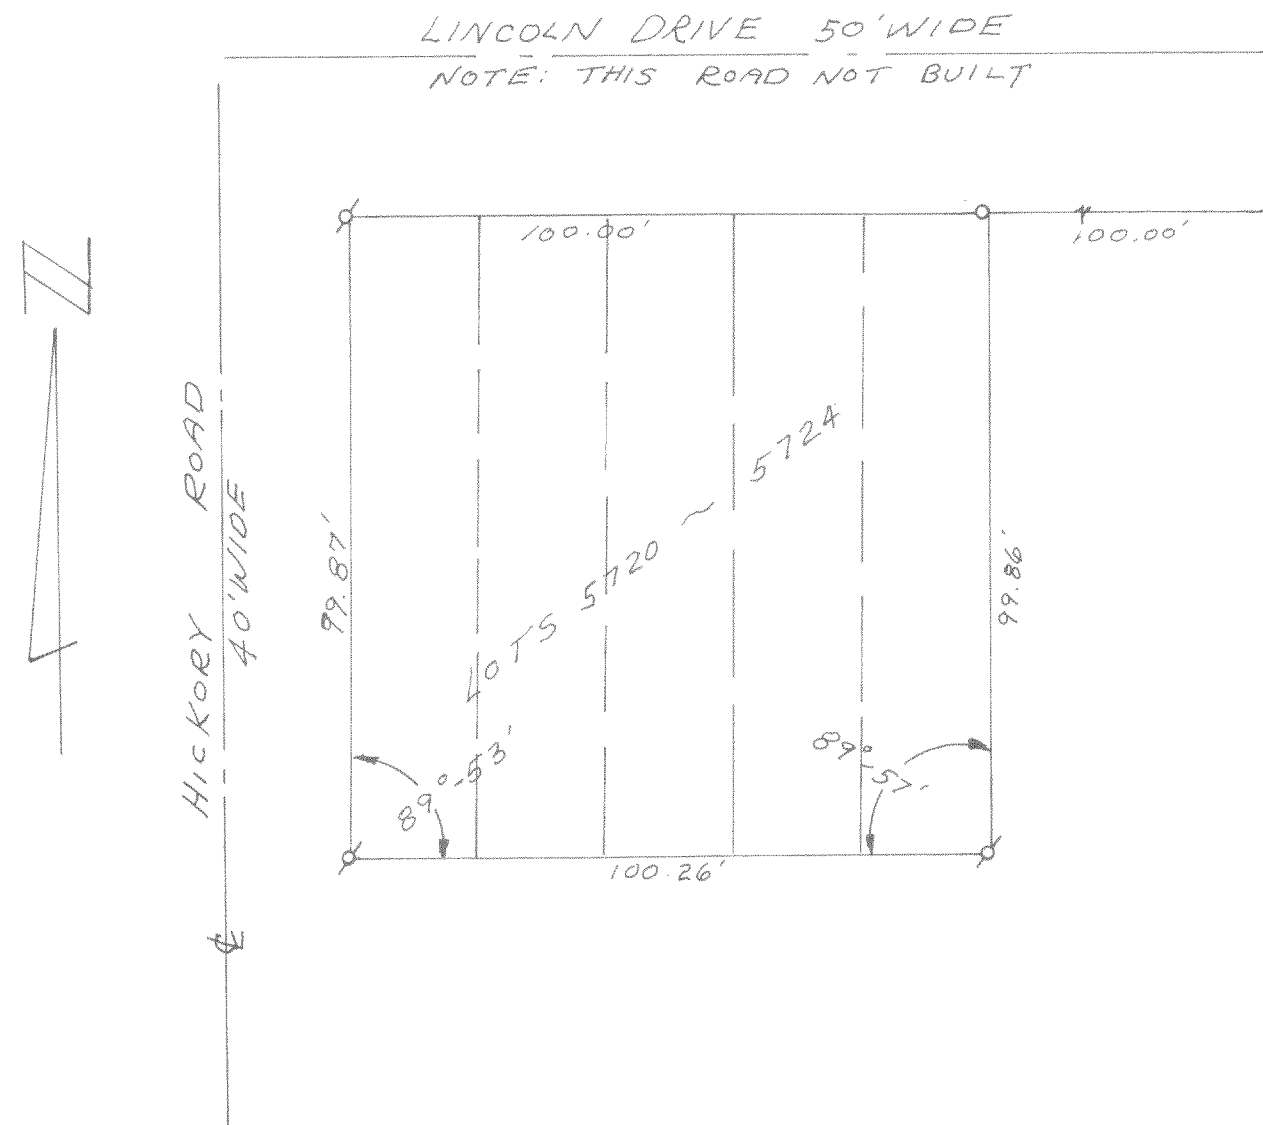

PLAT OF SURVEY OF

LOTS 5720 TO 5724, BLOCK 102 OF
LAKE COMO BEACH SUBDIVISION,
WALWORTH COUNTY, WISCONSIN

- o IRON PIPE SET
- ⊗ IRON PIPE FOUND

AUGUST 1968

Shay L. Jensen
COUNTY SURVEYOR