


#4673

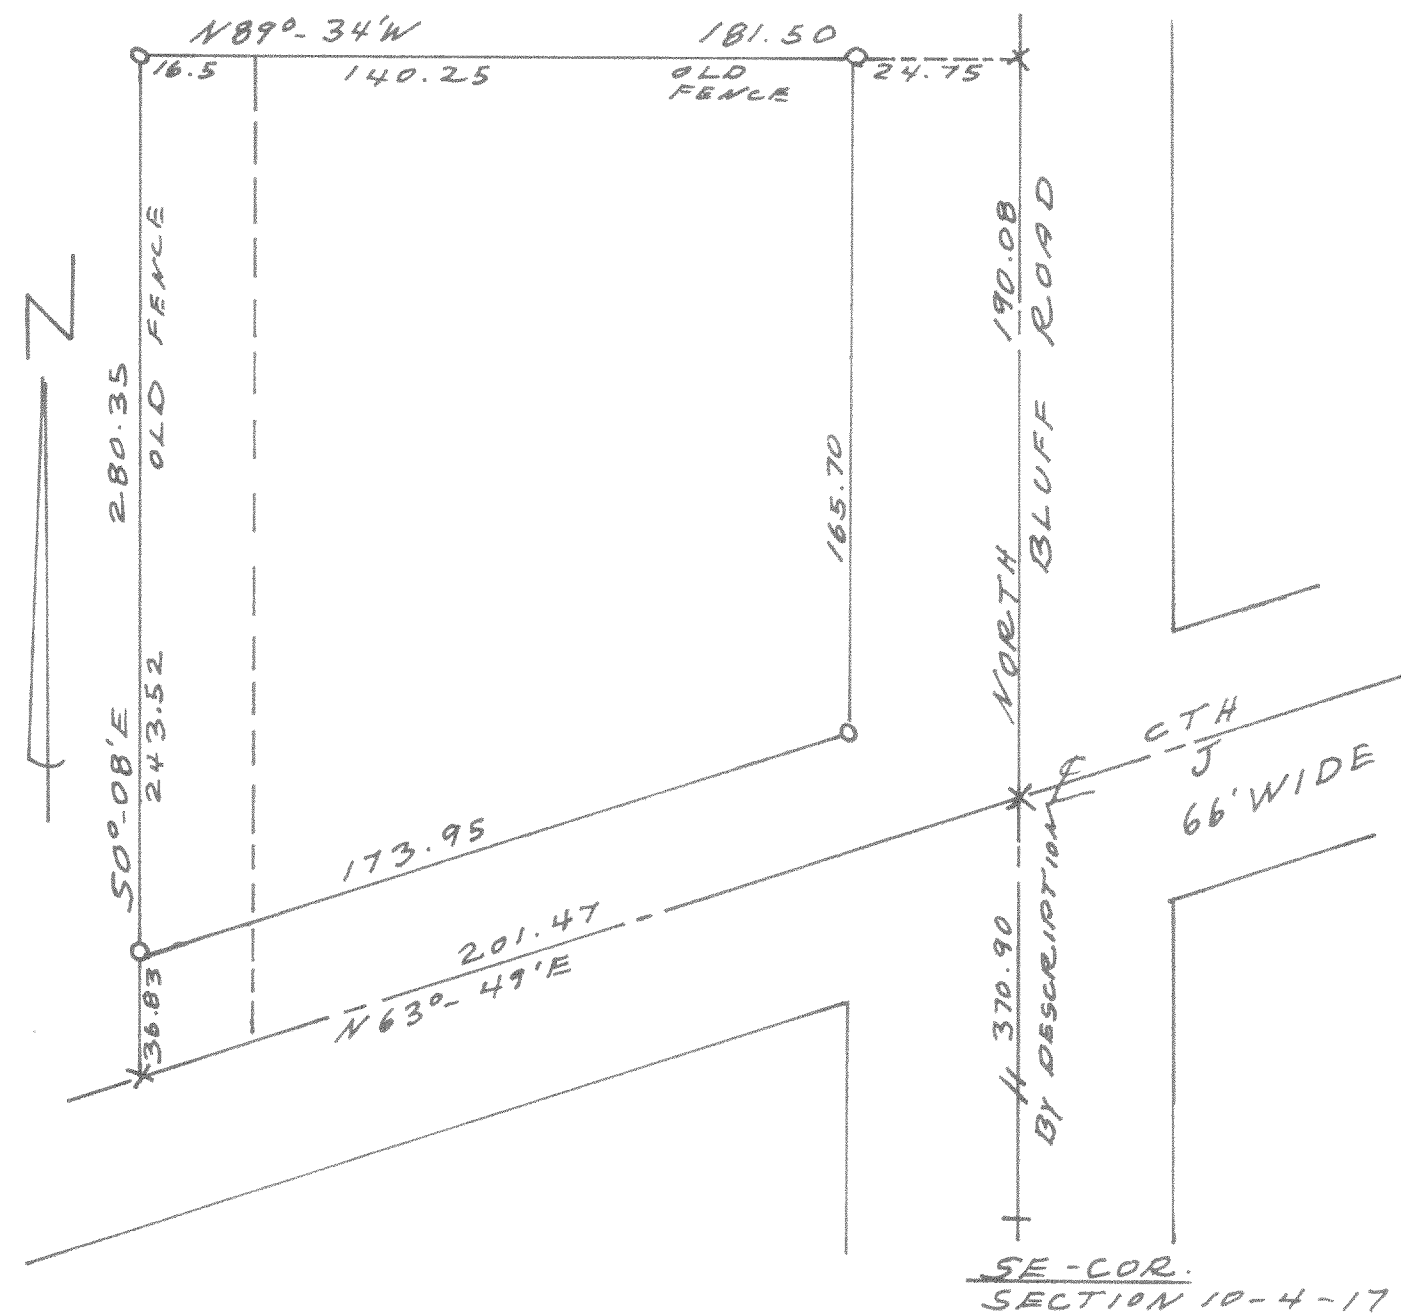


PLAT OF SURVEY
OF

PART OF THE SE 1/4 SECTION 10
T4N-R17E, WALWORTH CO., WISCONSIN.

JULY 11, 1969

Shay L. Jensen
COUNTY SURVEYOR

#4674

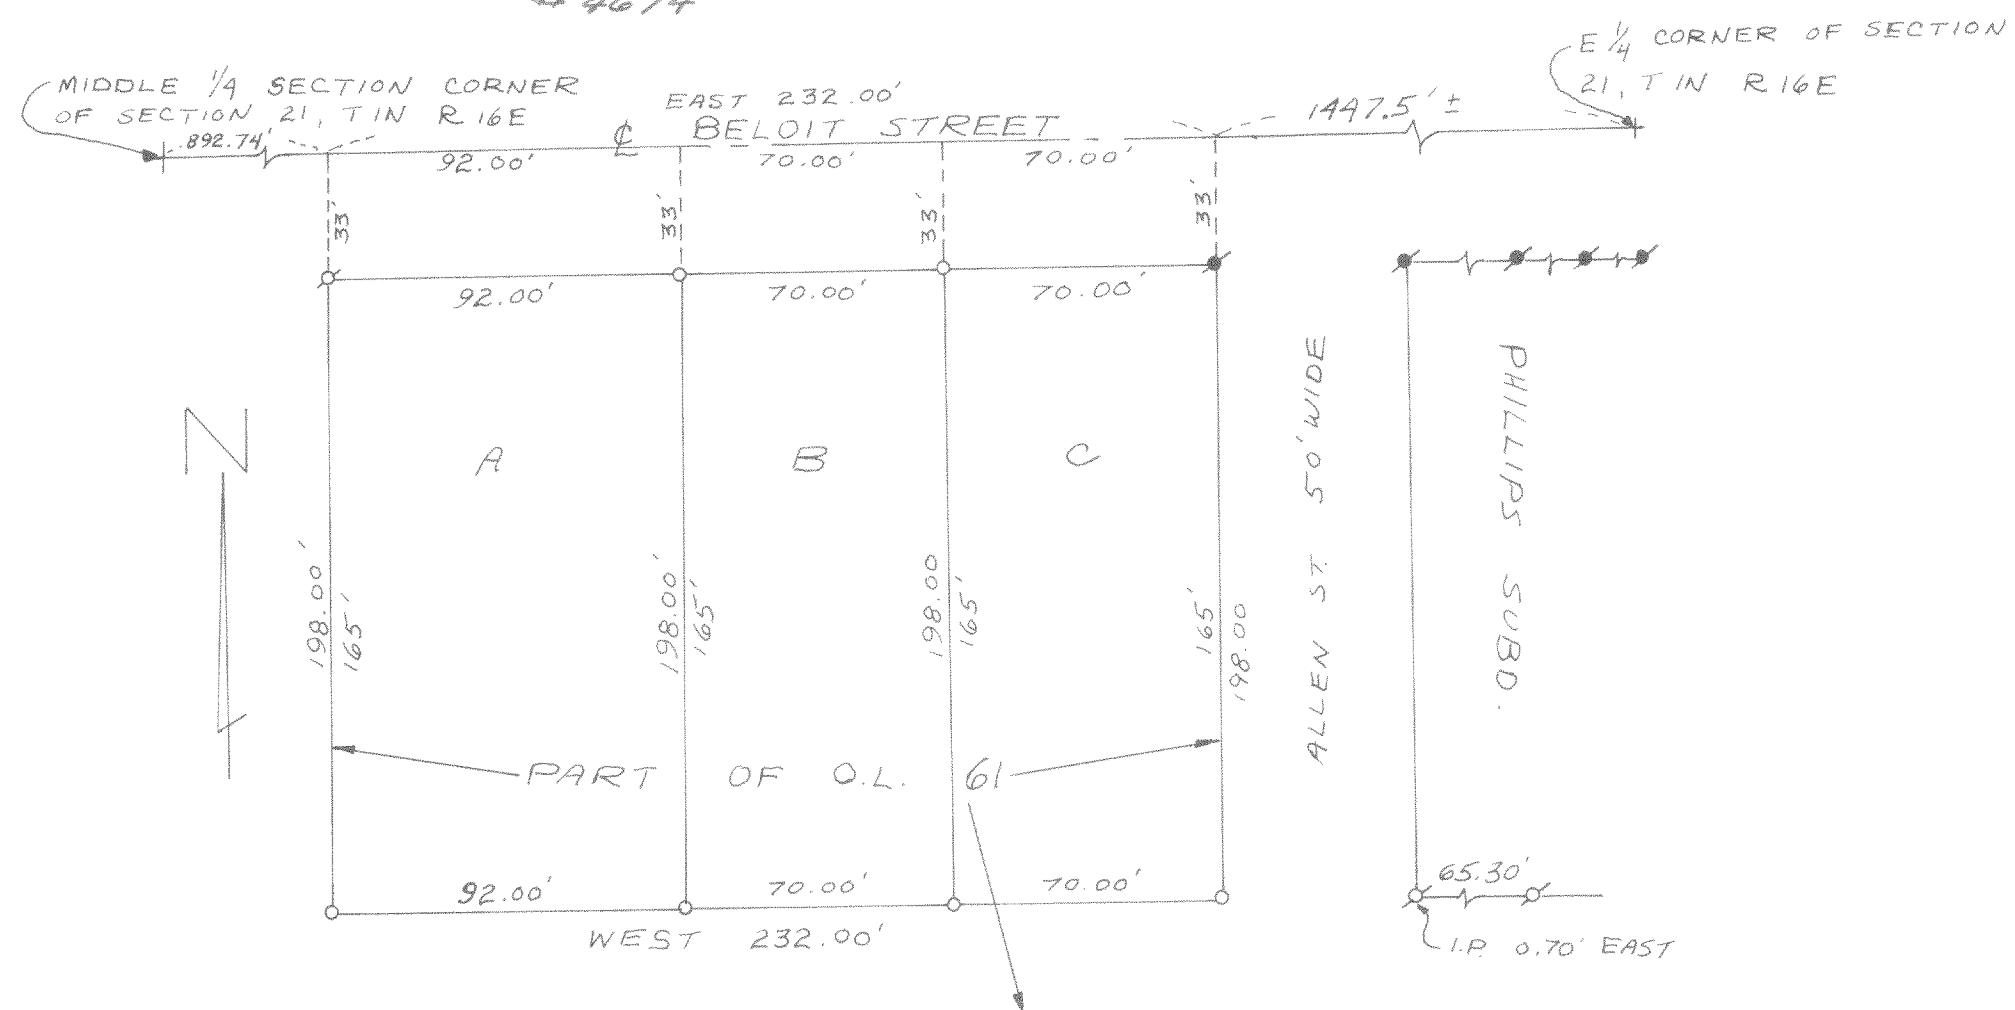

- CONCRETE MONUMENT FOUND
- o IRON PIPE FOUND
- o IRON PIPE SET

PLAT OF SURVEY
OF

A PARCEL OF LAND LOCATED IN THE SE 1/4 OF
SECTION 21, T1N R16E VILLAGE OF WALWORTH,
WALWORTH COUNTY, WISCONSIN,
PART OF OUTLOT 61 OF THE ASSESSOR'S PLAT

DEC. 1969

Shay L. Jensen
COUNTY SURVEYOR