


4678

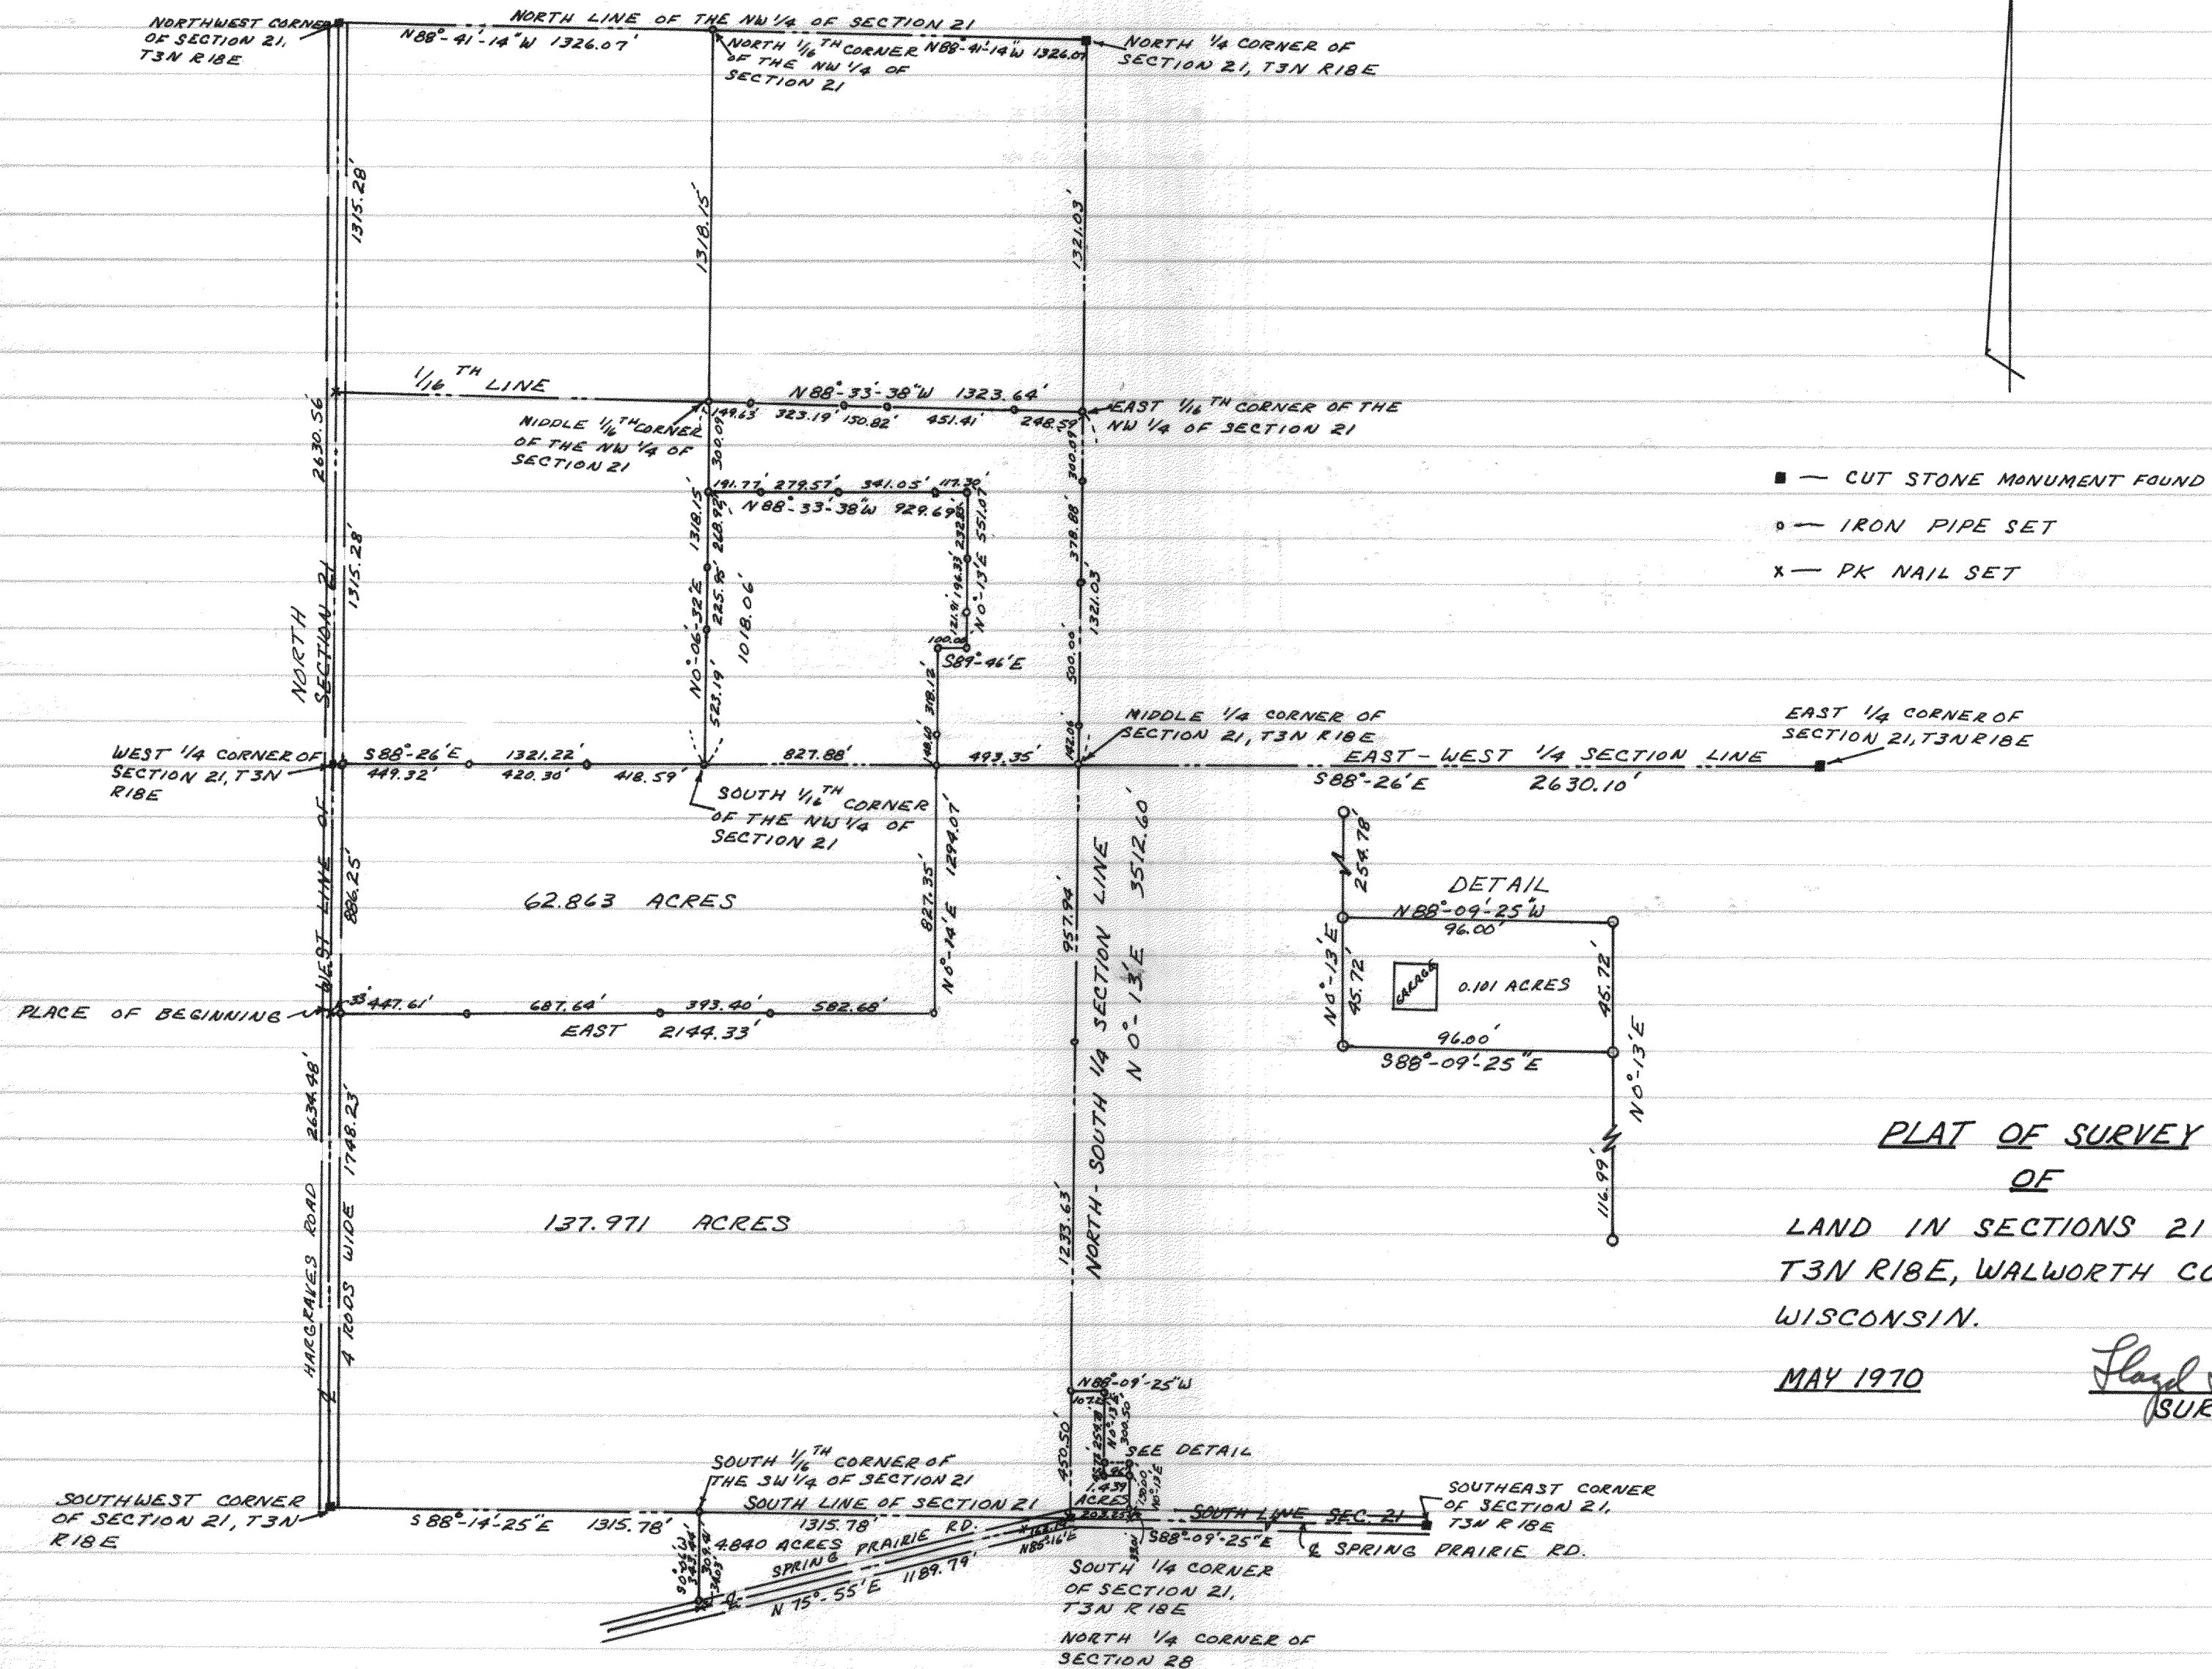

**PLAT OF SURVEY
OF**

LAND IN SECTIONS 21 AND 28
T3N R1E, WALWORTH COUNTY,
WISCONSIN.

MAY 1970

David L. Jensen
SURVEYOR