


#4682

PLAT OF SURVEY OF
PART OF LOT 13 E 10 BLOCK 27
CHAPMAN'S E LUDINGTON'S ADD.
TO THE CITY OF WHITEWATER
WAL. CO. WISCONSIN.


JAN. 1965

Lloyd S Jensen
CO. SURVEYOR

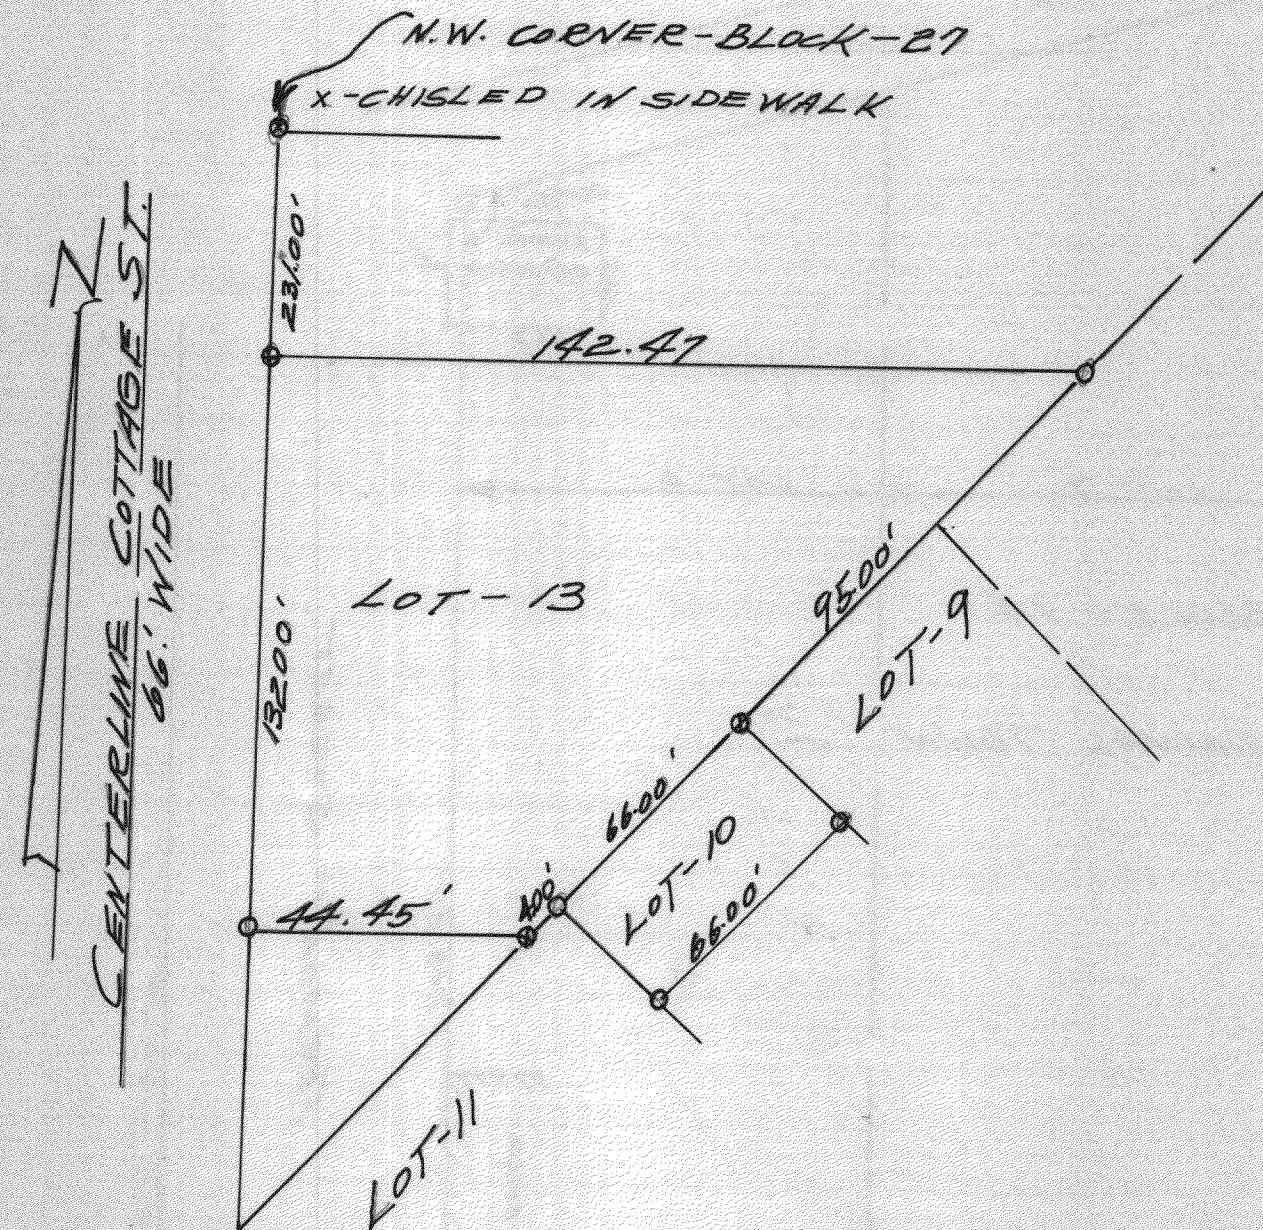

#4683

Plat of survey of 5.001 ACRES IN
SW 1/4 Section 6, T34N R18E.

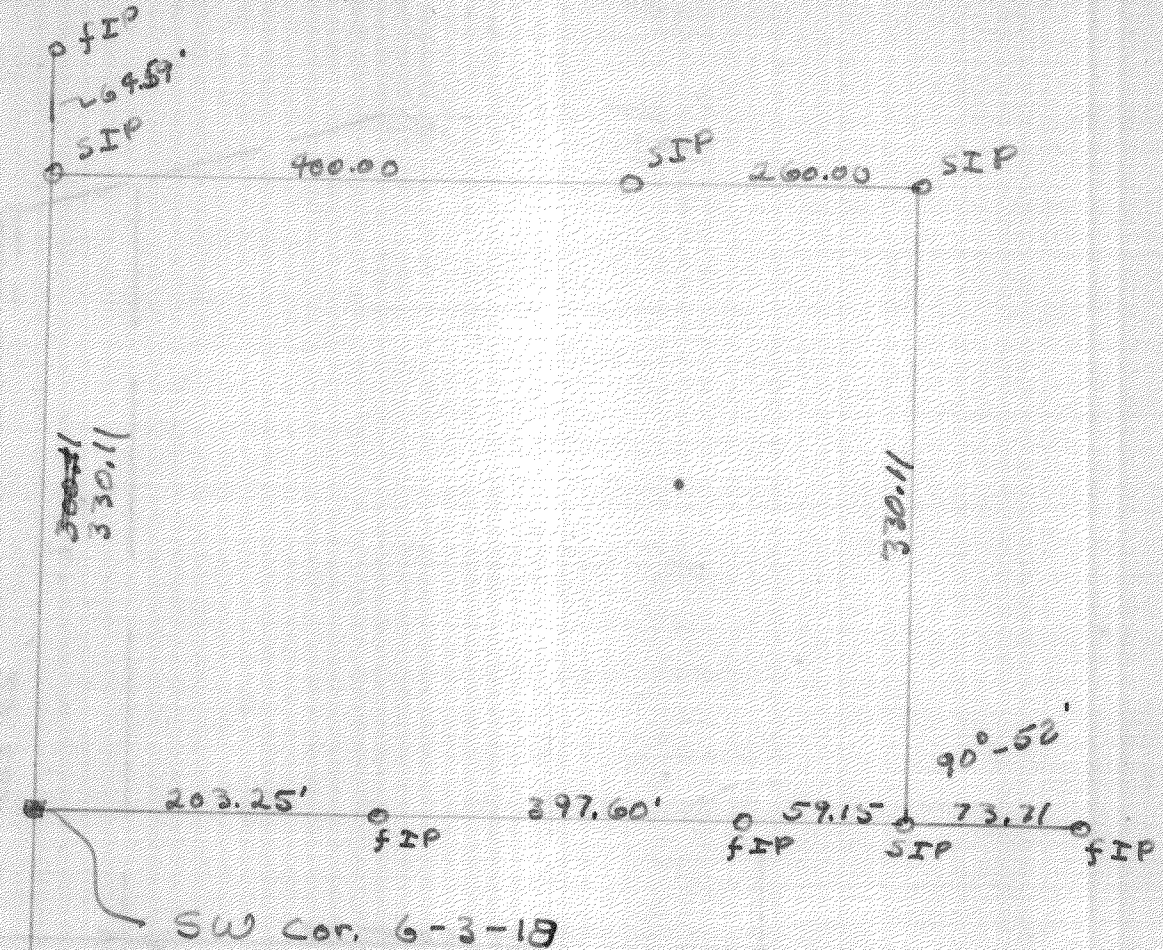

Lloyd S Jensen
County Surveyor