


4693



4694

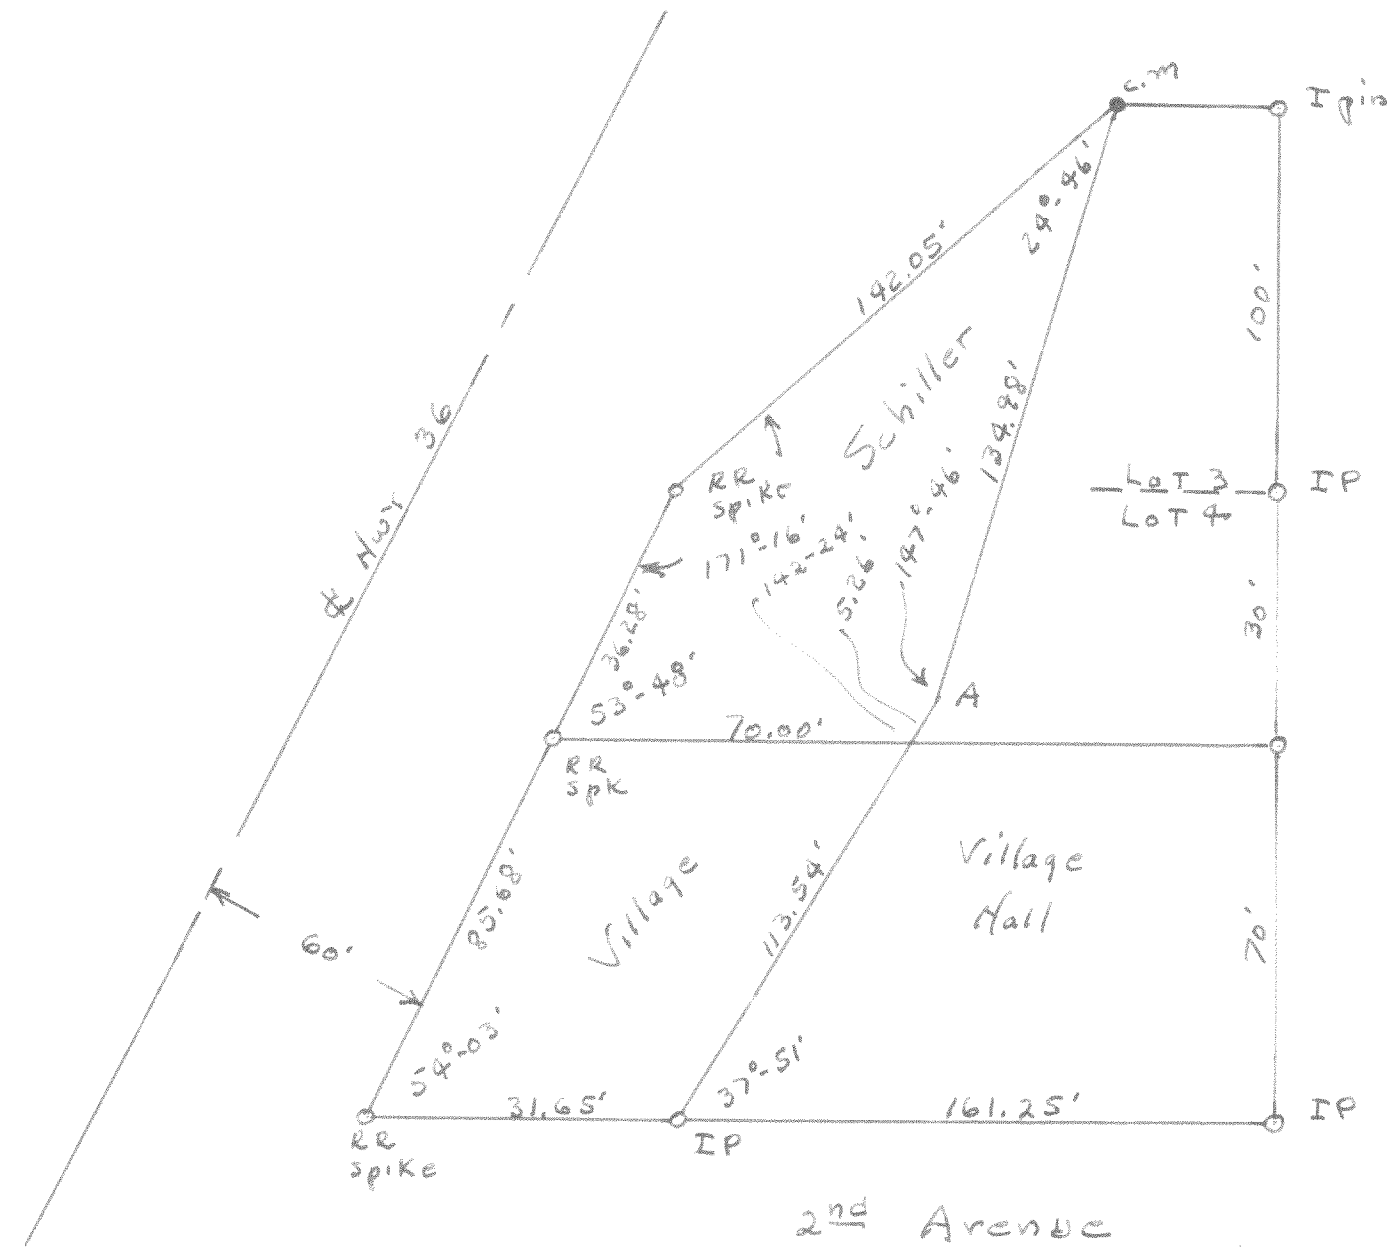