


#4695

PLAT OF SURVEY
OF Flord & Jensen
SURVEYOR

MAY 1965

SW 1/4 SECTION 14, T1N, R16E
WALWORTH COUNTY, WISCONSIN.

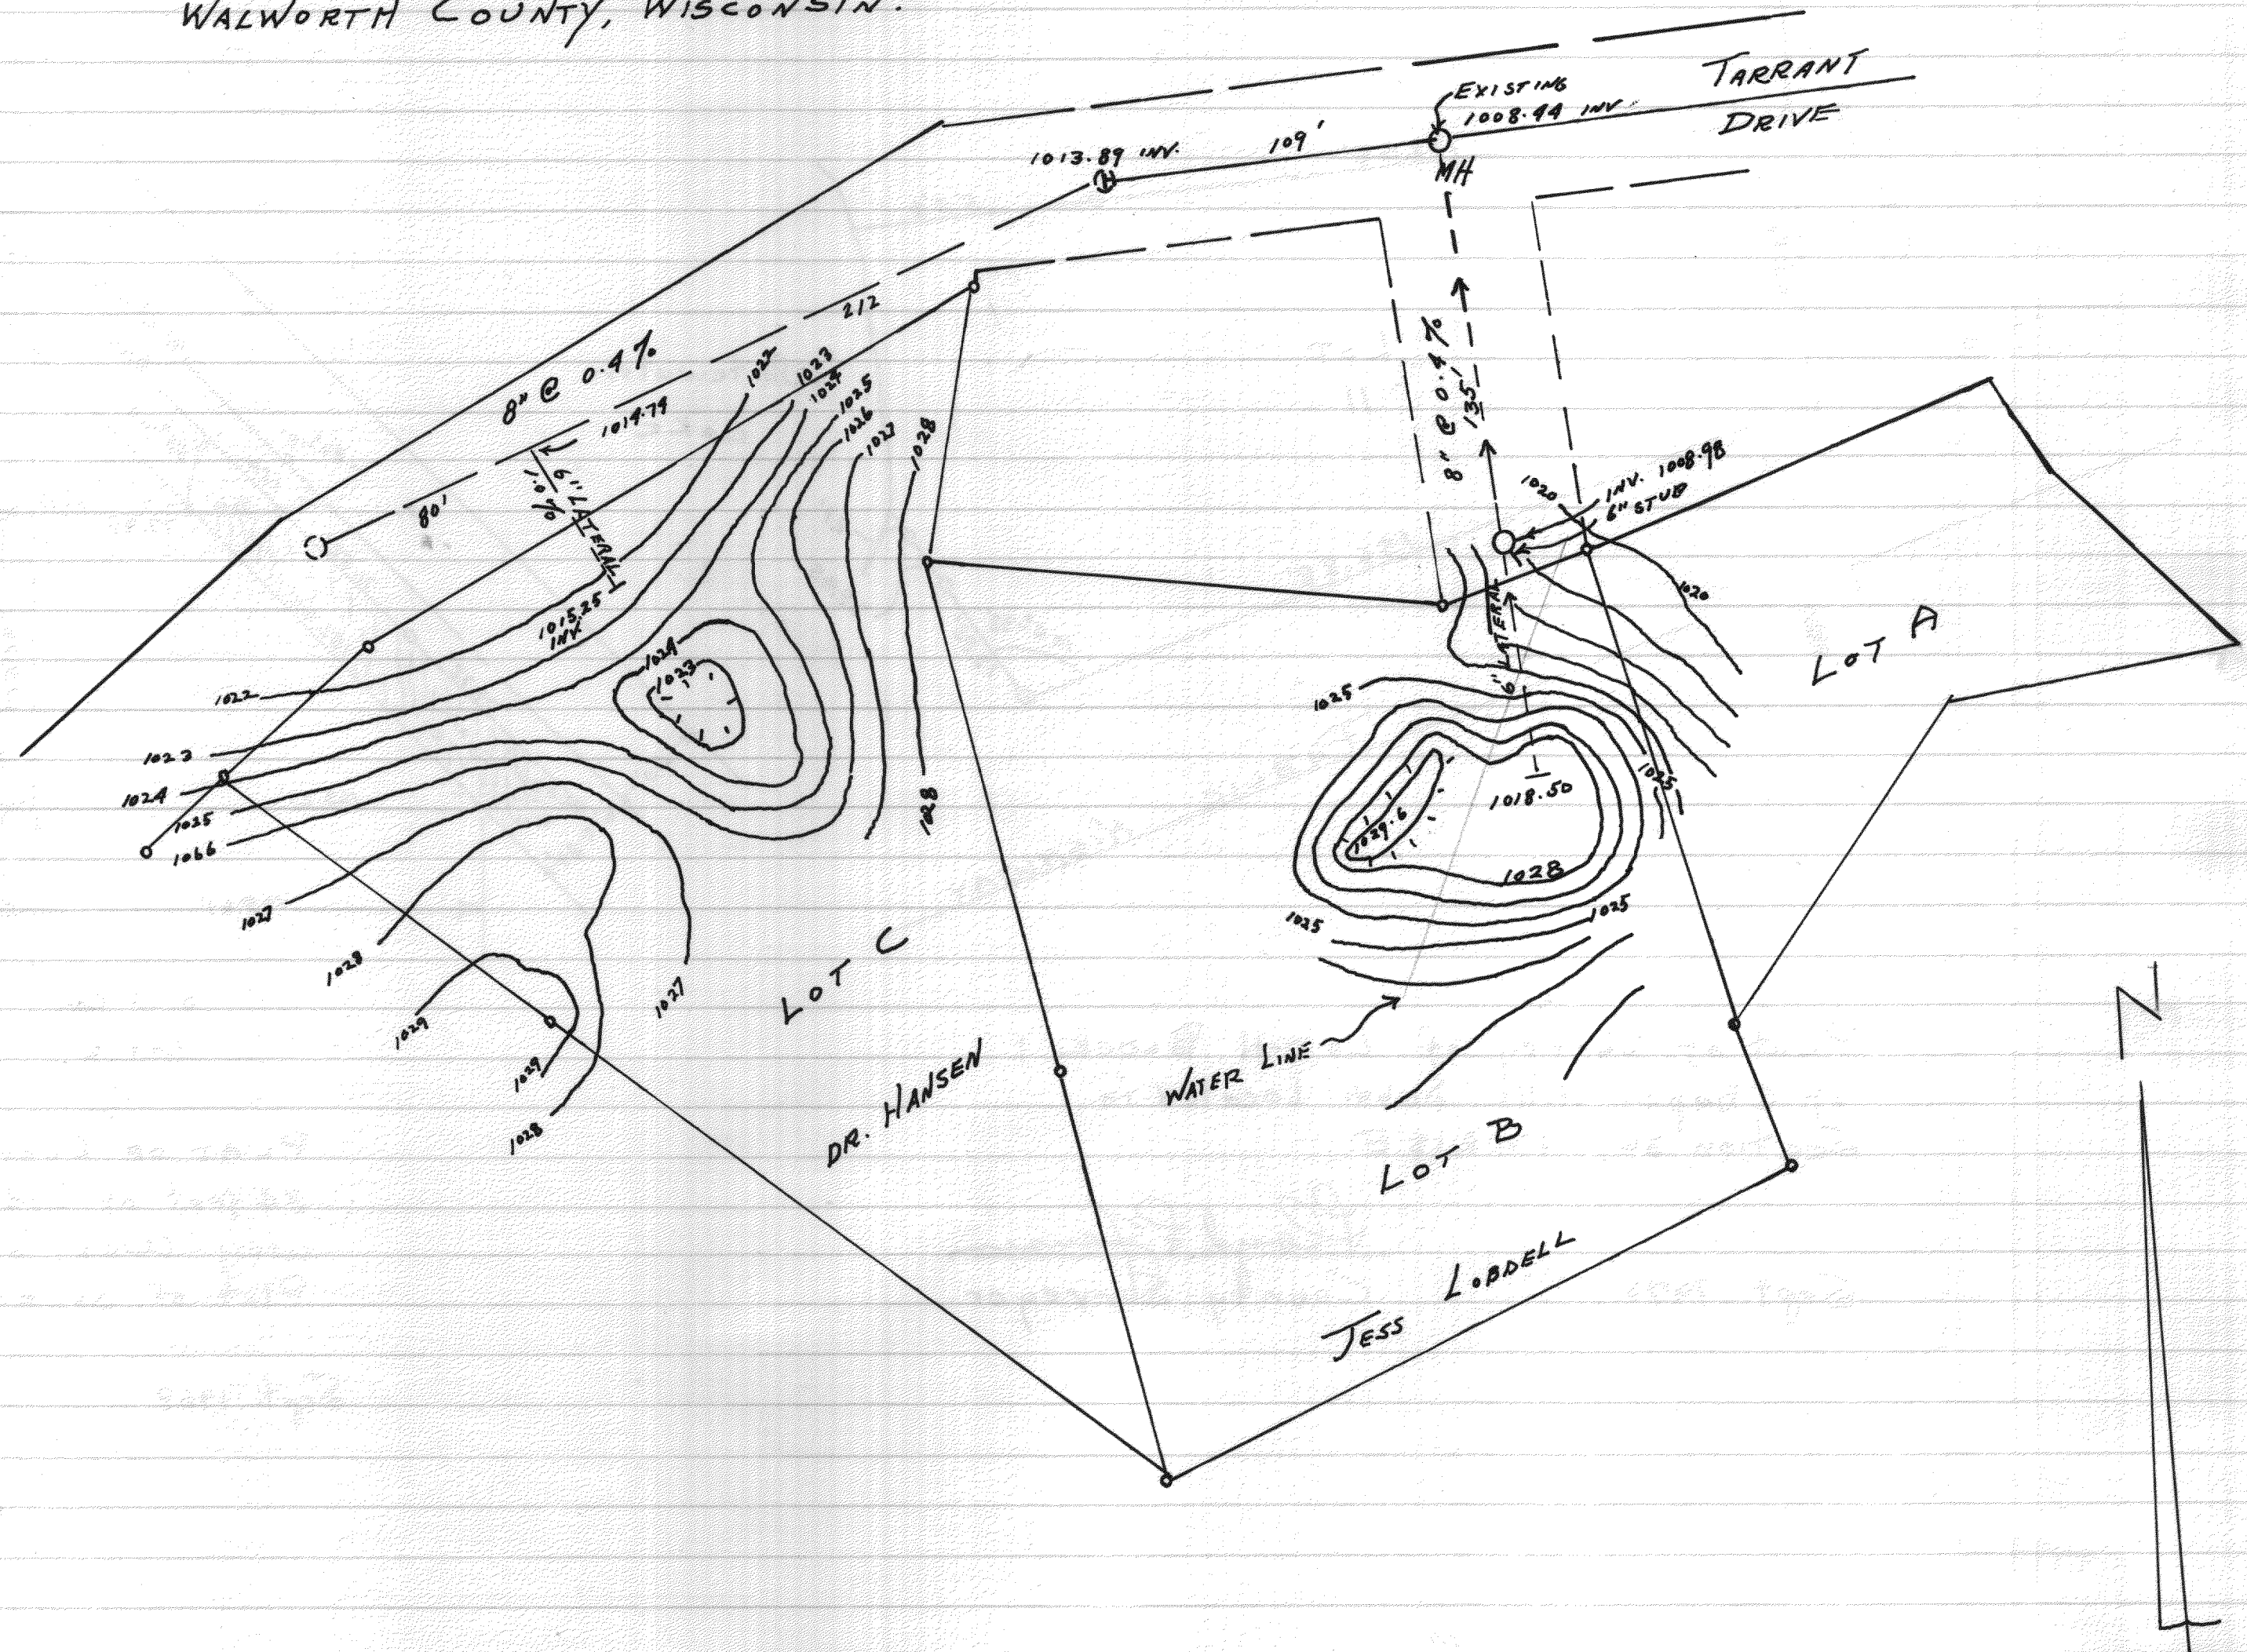

WATER LINE ±