


#4696

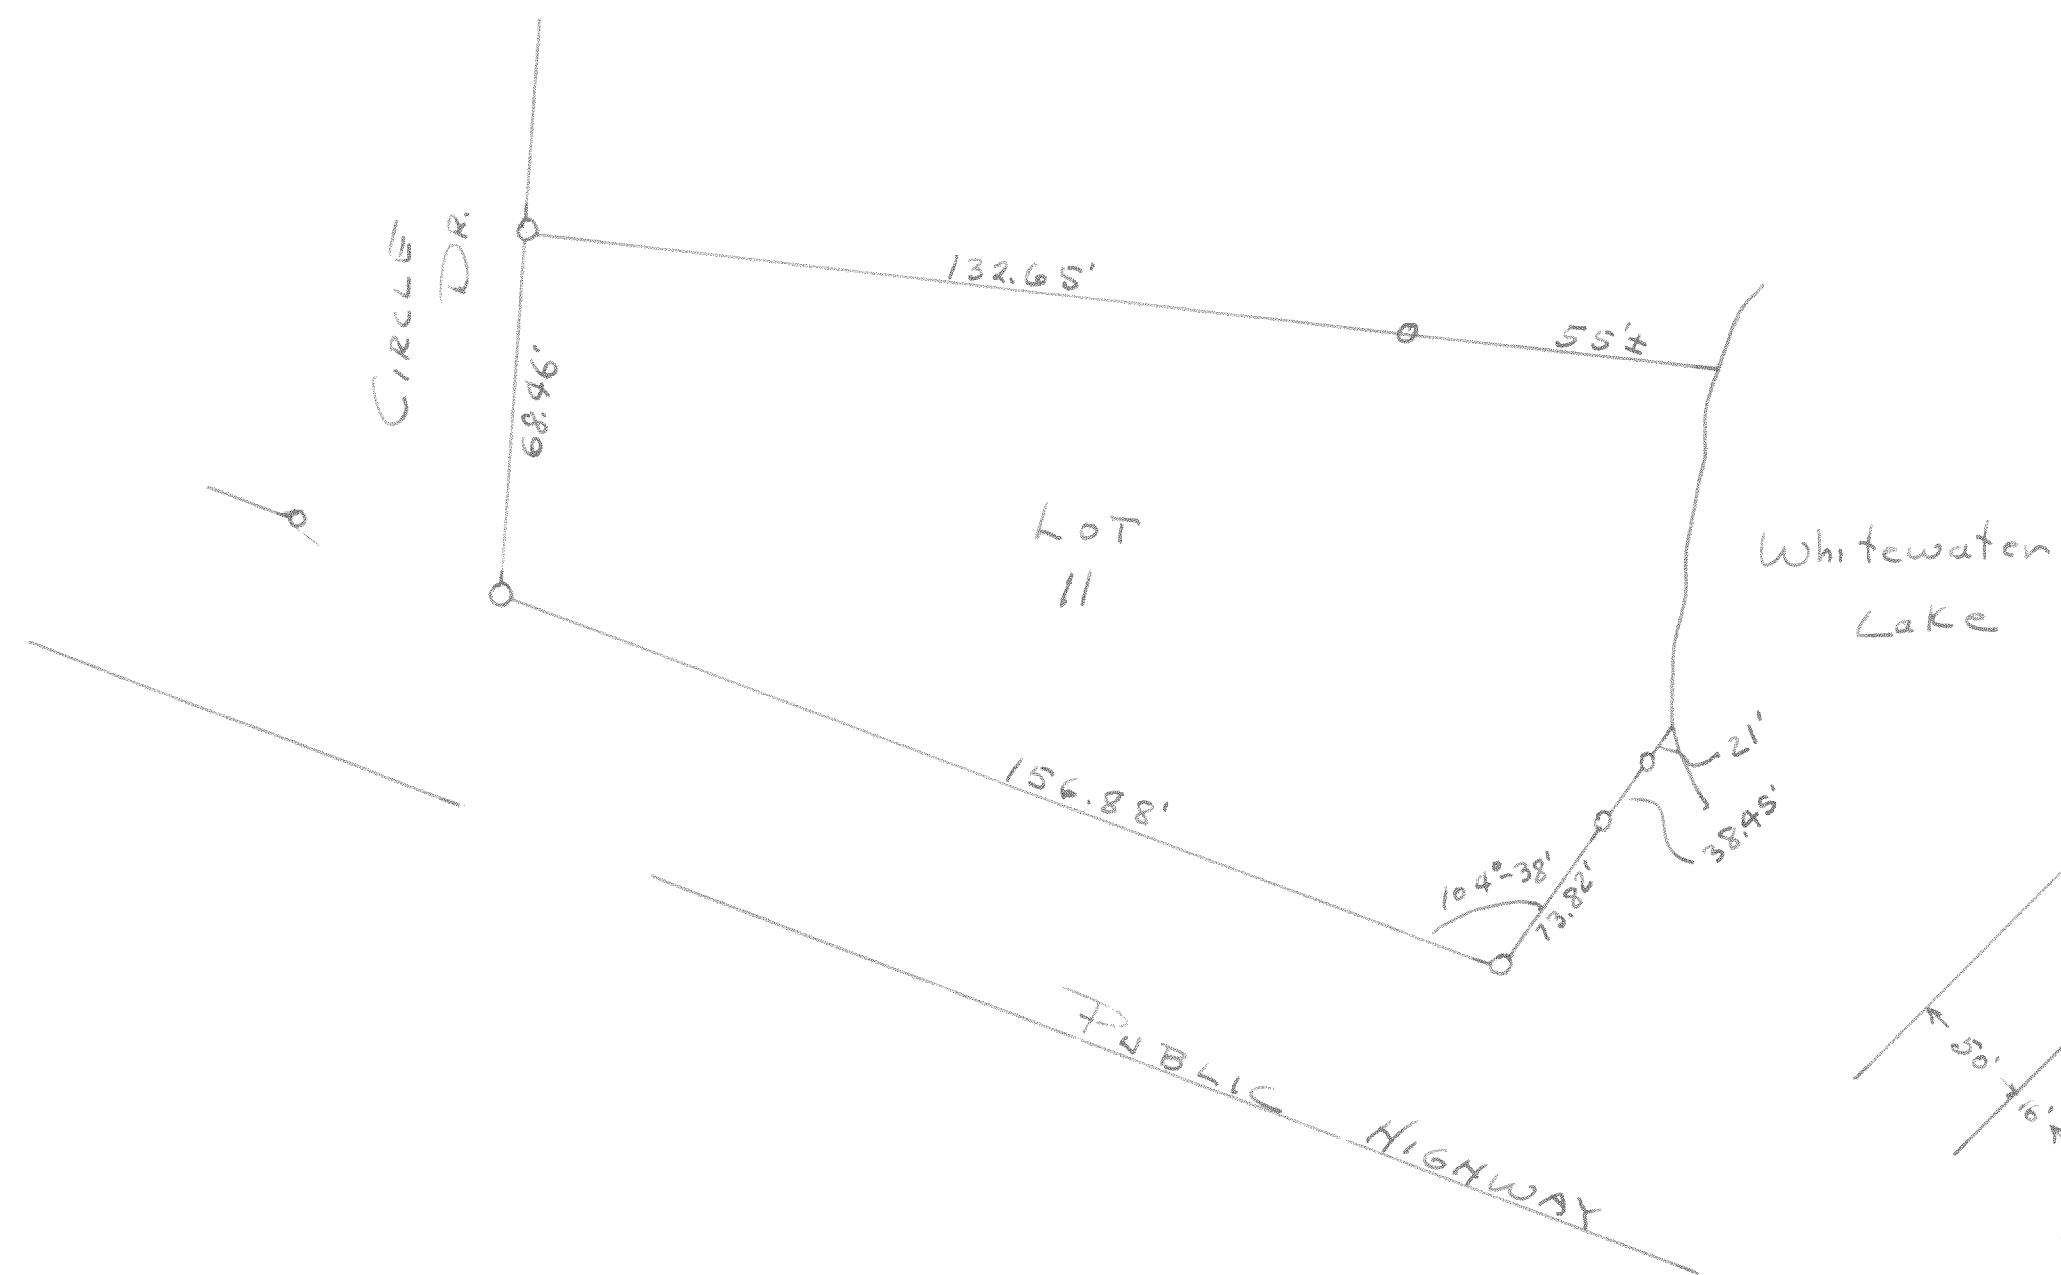


PLAT OF SURVEY OF LOT 11 BLOCK 1
of Chapel Hills Subd. Located in
Section 34, T4N R15E

Sept. 1973

Lloyd Pfensen
County Surveyor

#4797

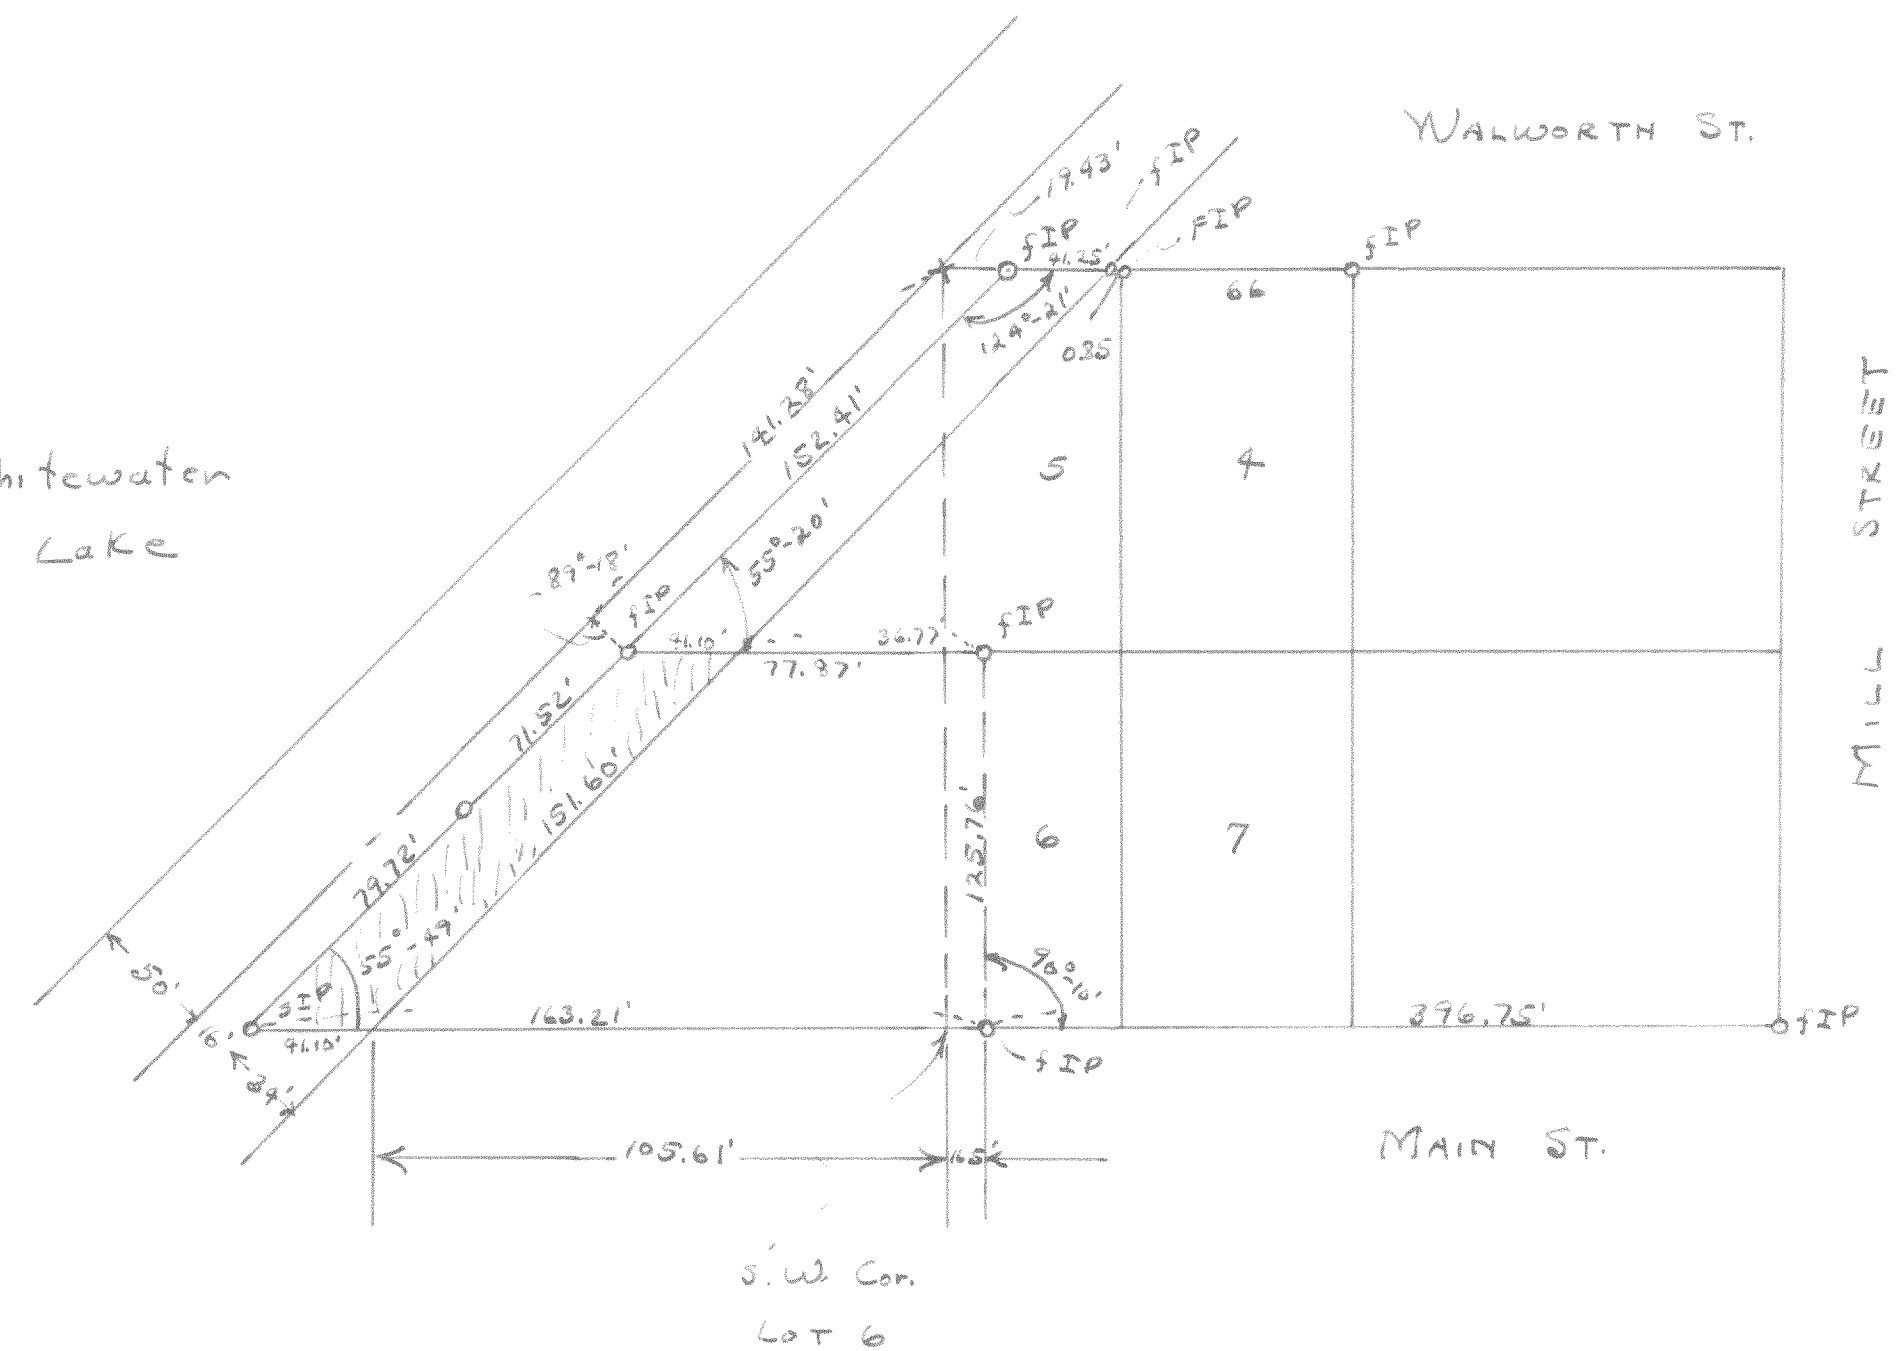

PLAT OF SURVEY OF THE EAST
34 feet of old Railroad right of
way West of Lot 6 of Original
Plat of Geneva City

Sept. 1968

Lloyd Pfensen
County Surveyor