


#4799

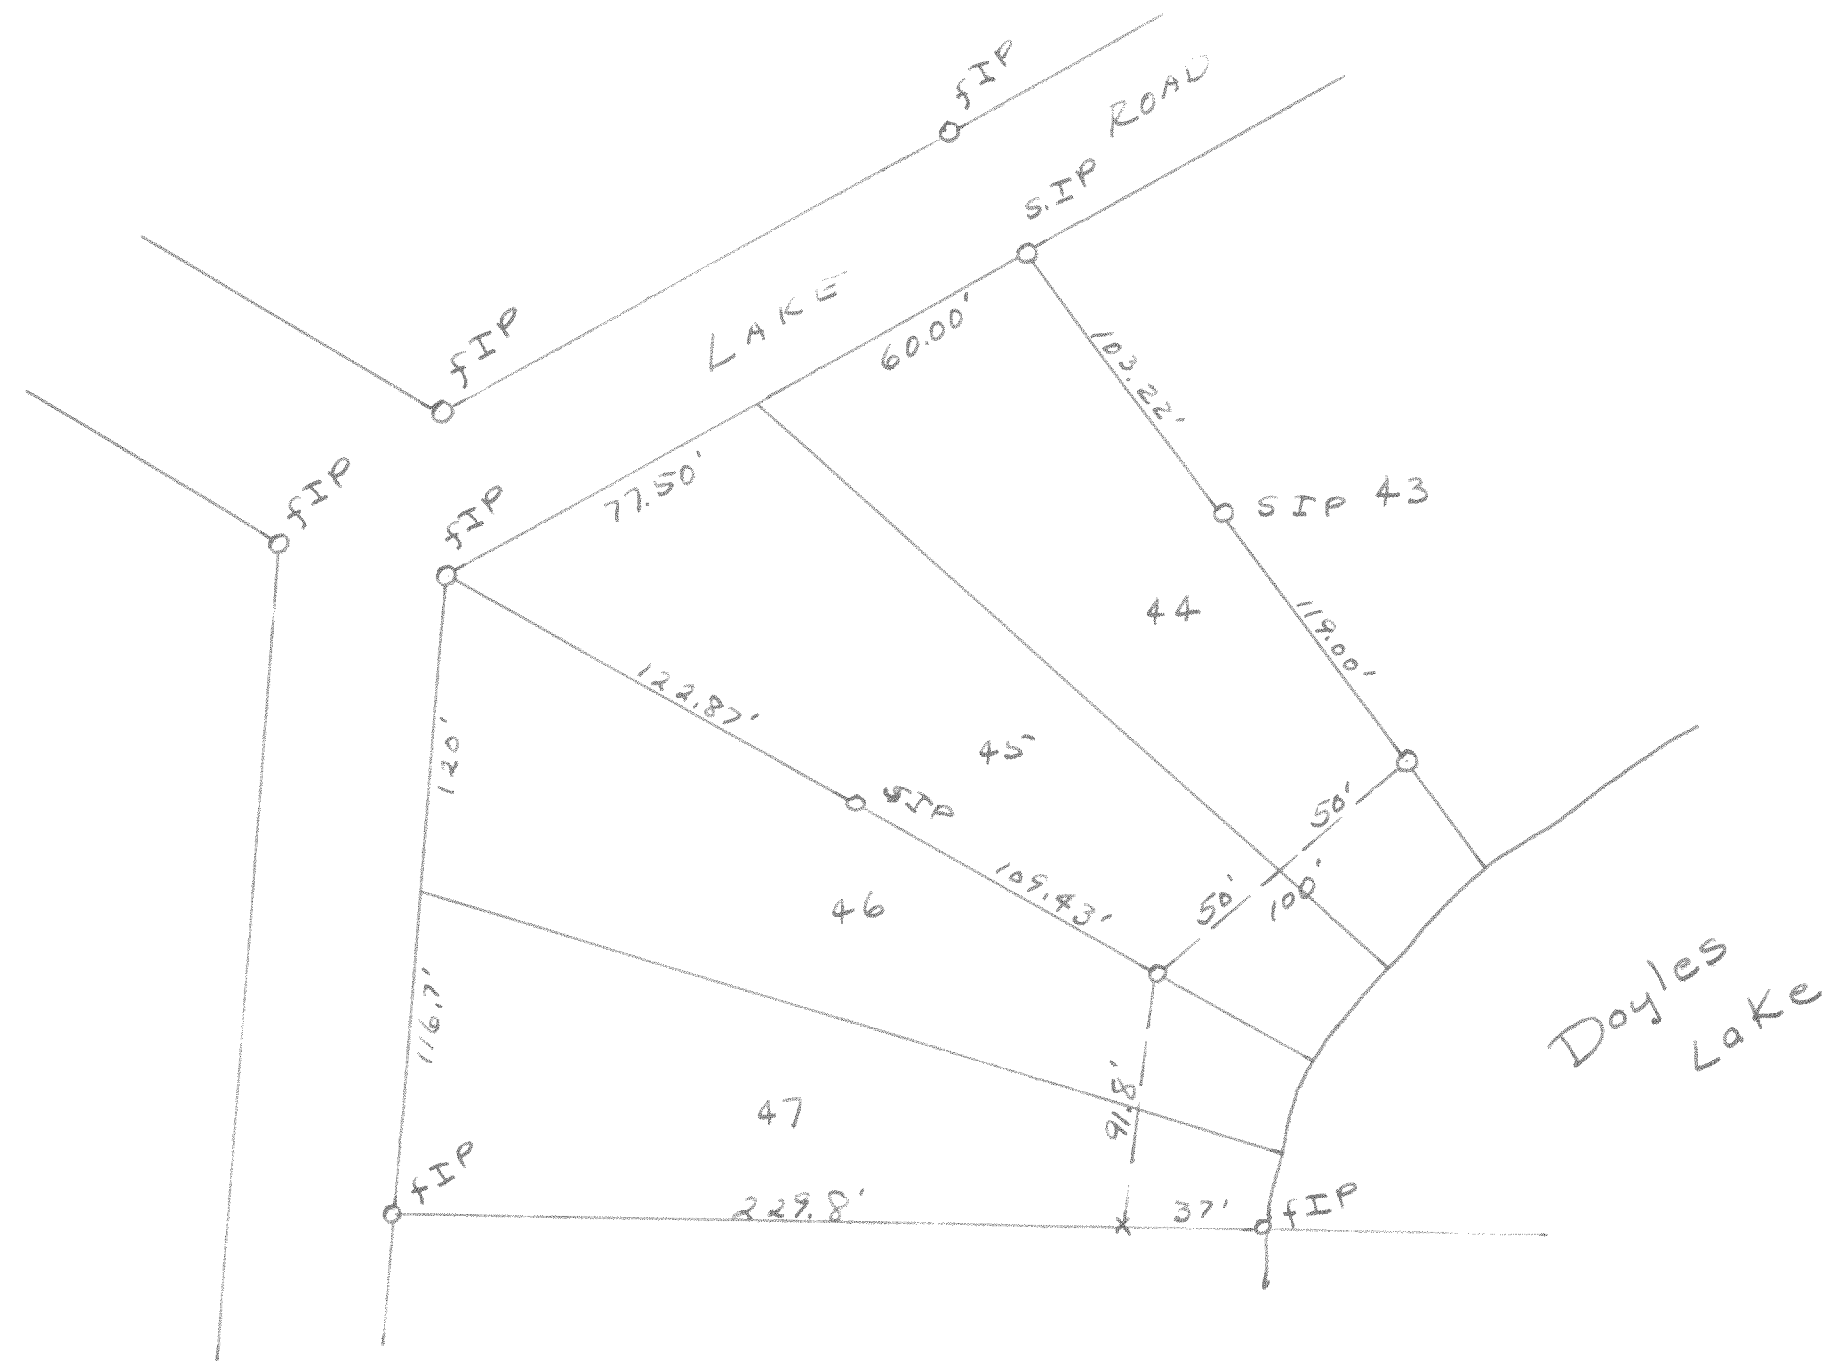

Plat of Survey of Lots
44 & 45 of Block I of
Swift Lake Subd.

July 1969 Flugh & Jensen
County Surveyor