


2642

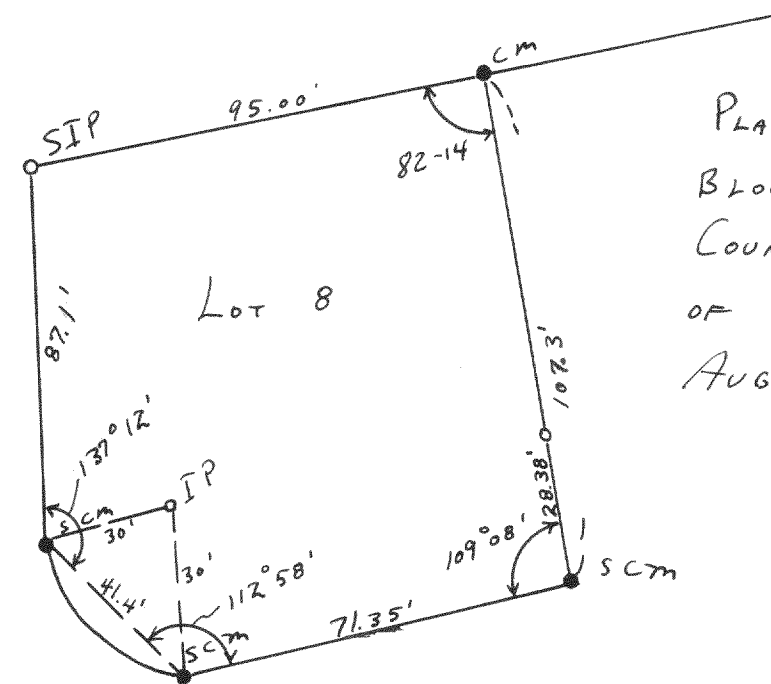

PLAT OF SURVEY OF LOT 8
BLOCK F OF UNIT 3 OF
COUNTRY CLUB ESTATES
OF FONTANA.

AUG 23, 1952


Lloyd L Jensen
County Surveyor CRS.

2642A ADDITION A TO COUNTRY CLUB ESTATES
CONSISTING OF 12 LOTS IS RECORDED ON
PAGE 55 OF VOLUME 12 OF PLATS FOR
WALWORTH COUNTY.

May 9, 1952

Lloyd L Jensen
County Surveyor CRS.

2644

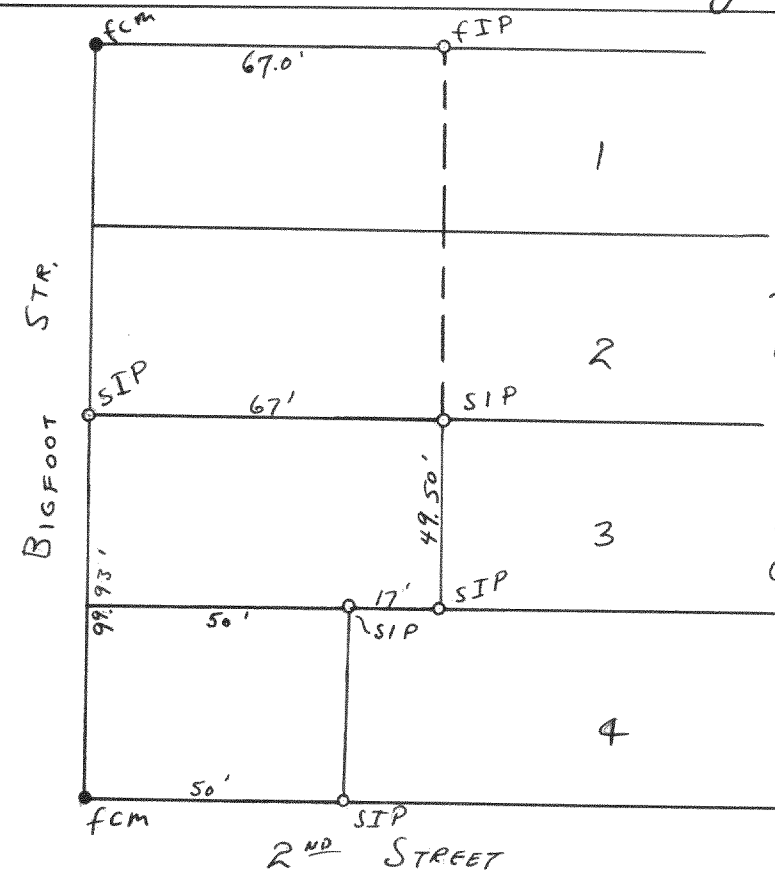


SURVEY OF THE WEST 50' OF
LOT 4 AND THE WEST
67' OF LOT 3 OF BLOCK 3
OF D.A. REED'S ADD TO
REED'S PARK.

June 19, 1952

Lloyd L Jensen
County Surveyor CRS.

2643

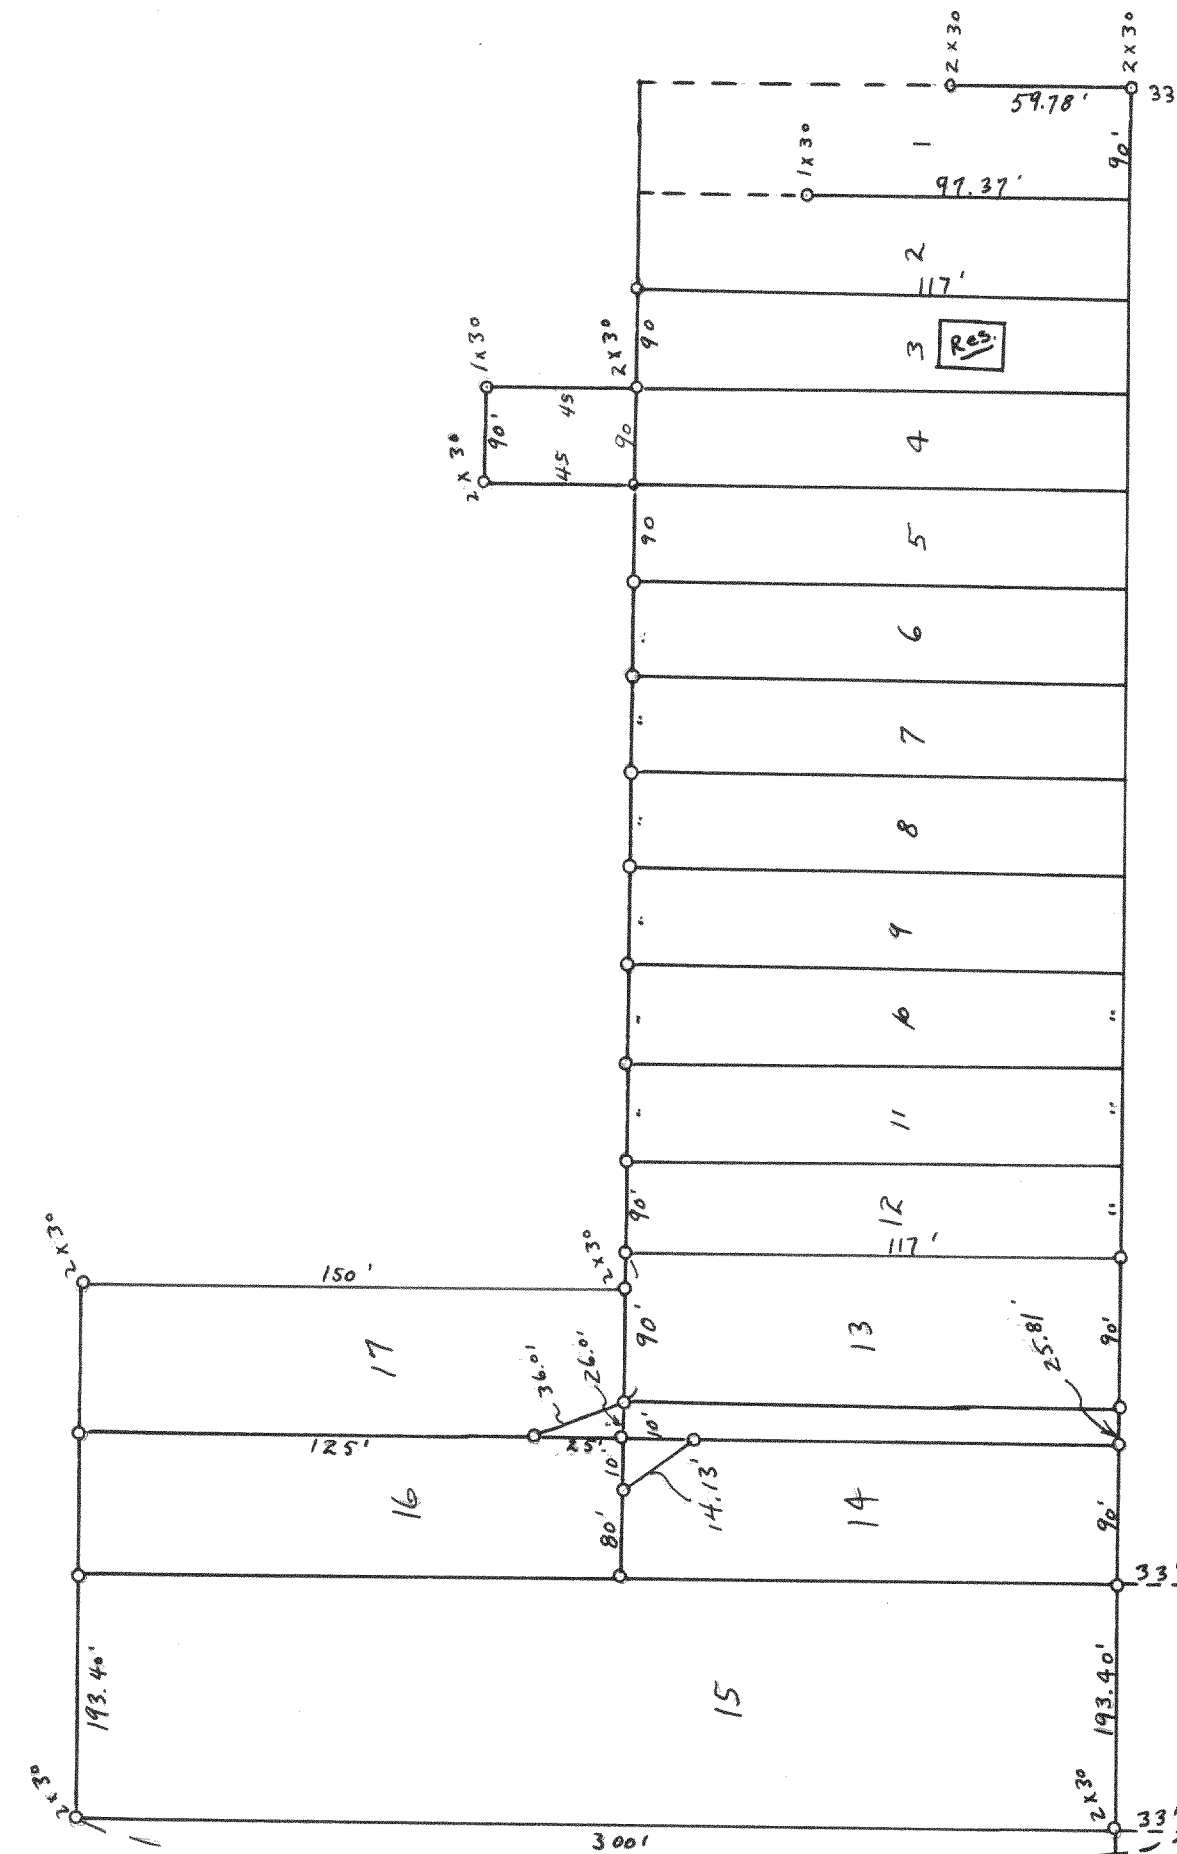

CROSS @ MIDDLE 1/4 SEC.
COR. OF SECTION 23, T1N R16E

CROSS at
SE COR. OF
SW 1/4 of NE 1/4 of
SECTION 23, T1N R16E