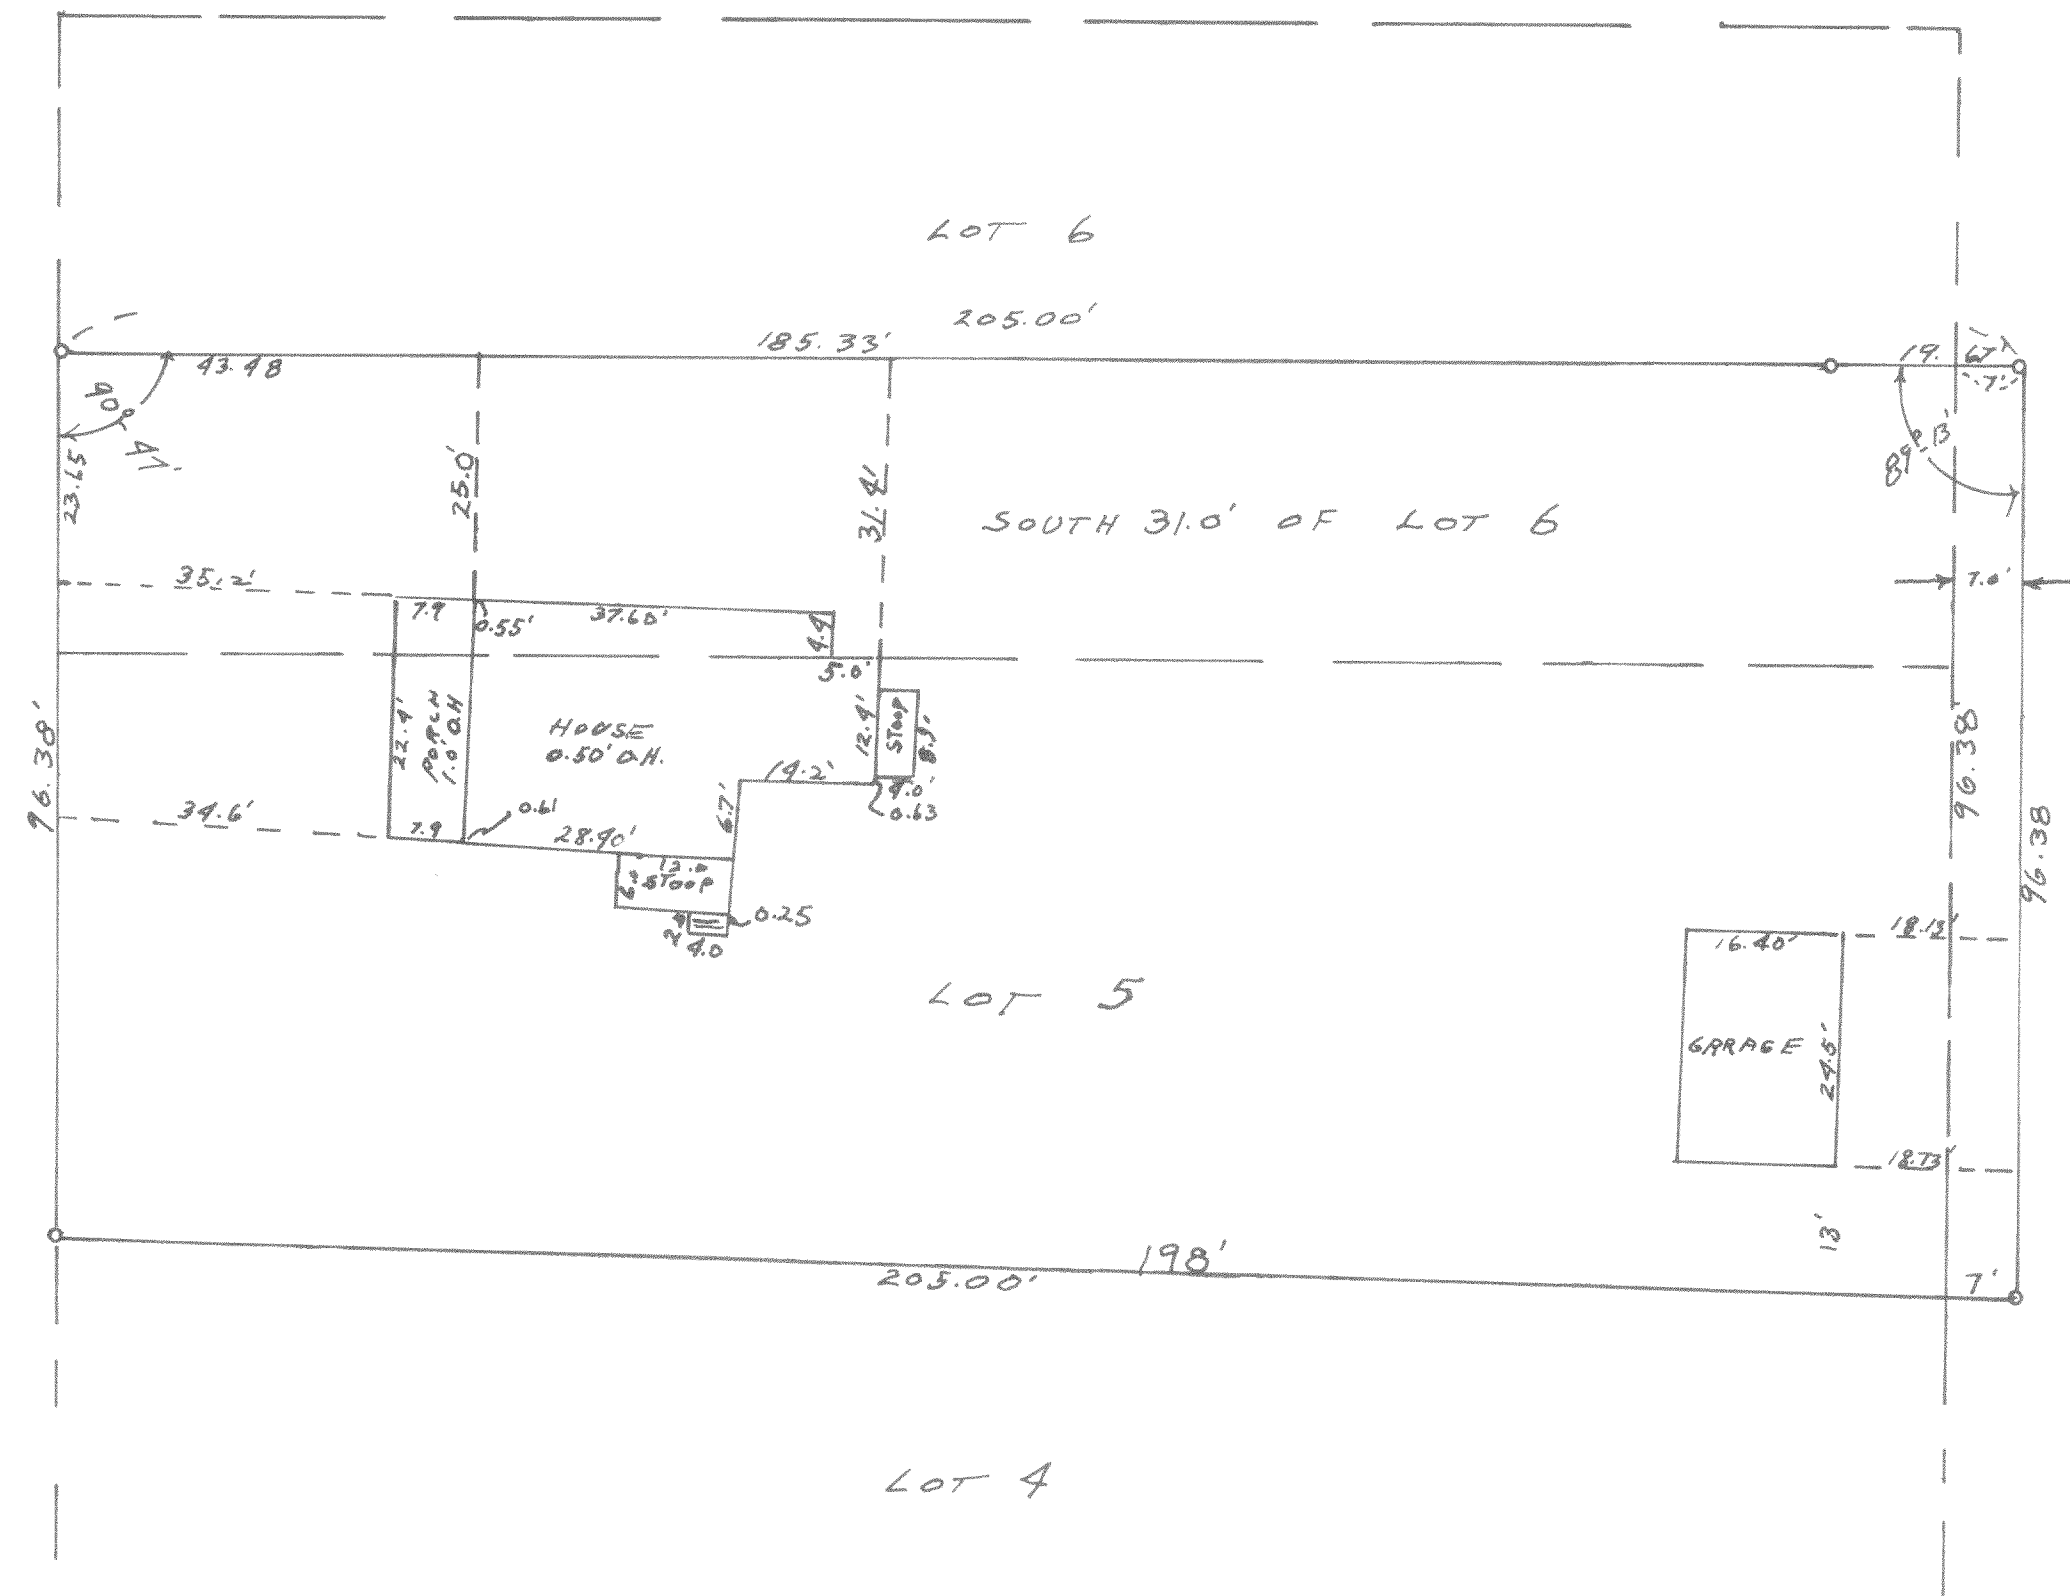


#4805

FREMONT STREET
66' WIDE

DESCRIPTION OF LAND SURVEYED

Lot 5 and the South 31.00 feet of Lot 6 of Block 1 of Edwards Addition to the Village of East Troy. Also begin at the Southeast corner of said Lot 5; thence East 7.0 feet; thence North 96.38 feet; thence West 7.00 feet to the East line of said Lot 6, 96.38 feet to the place of beginning.

PLAT OF SURVEY
OF

LAND IN THE VILLAGE
OF EAST TROY WISCONSIN.

SEPT. 1965

Floyd R. Jensen
C.O. SURVEYOR