


#4808 PLAT OF SURVEY
OF
TELEPHONE LINE LOCATION
FOR "THE ABBEY", FONTANA-
ON-GENEVA LAKE, WISCONSIN.

Lloyd L Jensen
CO. SURVEYOR

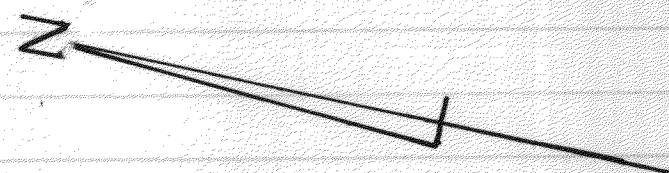

#4809 PLAT OF SURVEY

Floyd L. Jensen
CO. SURVEYOR

Hand-drawn site plan of Lot 13, showing a single-story dwelling and a garage. The plan includes dimensions for the building footprint, setbacks, and lot boundaries. A north arrow is present on the left. The lot is bounded by Lot 14 to the north, Lot 1 to the east, and Hilltop Drive to the south. The dwelling is a single-story structure with a garage attached to the east side. The plan shows various setbacks and dimensions for the building and its connection to the lot boundaries.

Lot 13 Dimensions and Features:

- North Boundary:** 118.69' (adjacent to Lot 14)
- East Boundary:** 118.69' (adjacent to Lot 1)
- South Boundary:** 85.00' (adjacent to Hilltop Drive)
- West Boundary:** 85.00' (adjacent to Hilltop Drive)
- Building Footprint:**
 - Single Story Dwelling:** 28.2' (width) x 24.3' (depth)
 - Garage:** 16.2' (width) x 22.2' (depth)
- Setbacks and Distances:**
 - From West Boundary to Dwelling: 30.0' (dashed line)
 - From West Boundary to Garage: 29.2' (dashed line)
 - From South Boundary to Dwelling: 29.4' (dashed line)
 - From South Boundary to Garage: 34.4' (dashed line)
 - From North Boundary to Dwelling: 11.7' (dashed line)
 - From North Boundary to Garage: 24.2' (dashed line)
 - From East Boundary to Dwelling: 25.3' (dashed line)
 - From East Boundary to Garage: 25.5' (dashed line)
- Other Dimensions:**
 - From West Boundary to Dwelling: 11.6' (dashed line)
 - From West Boundary to Garage: 23.8' (dashed line)
 - From South Boundary to Dwelling: 29.3' (dashed line)
 - From South Boundary to Garage: 34.4' (dashed line)
 - From North Boundary to Dwelling: 11.7' (dashed line)
 - From North Boundary to Garage: 24.2' (dashed line)
 - From East Boundary to Dwelling: 25.3' (dashed line)
 - From East Boundary to Garage: 25.5' (dashed line)

