


#2966

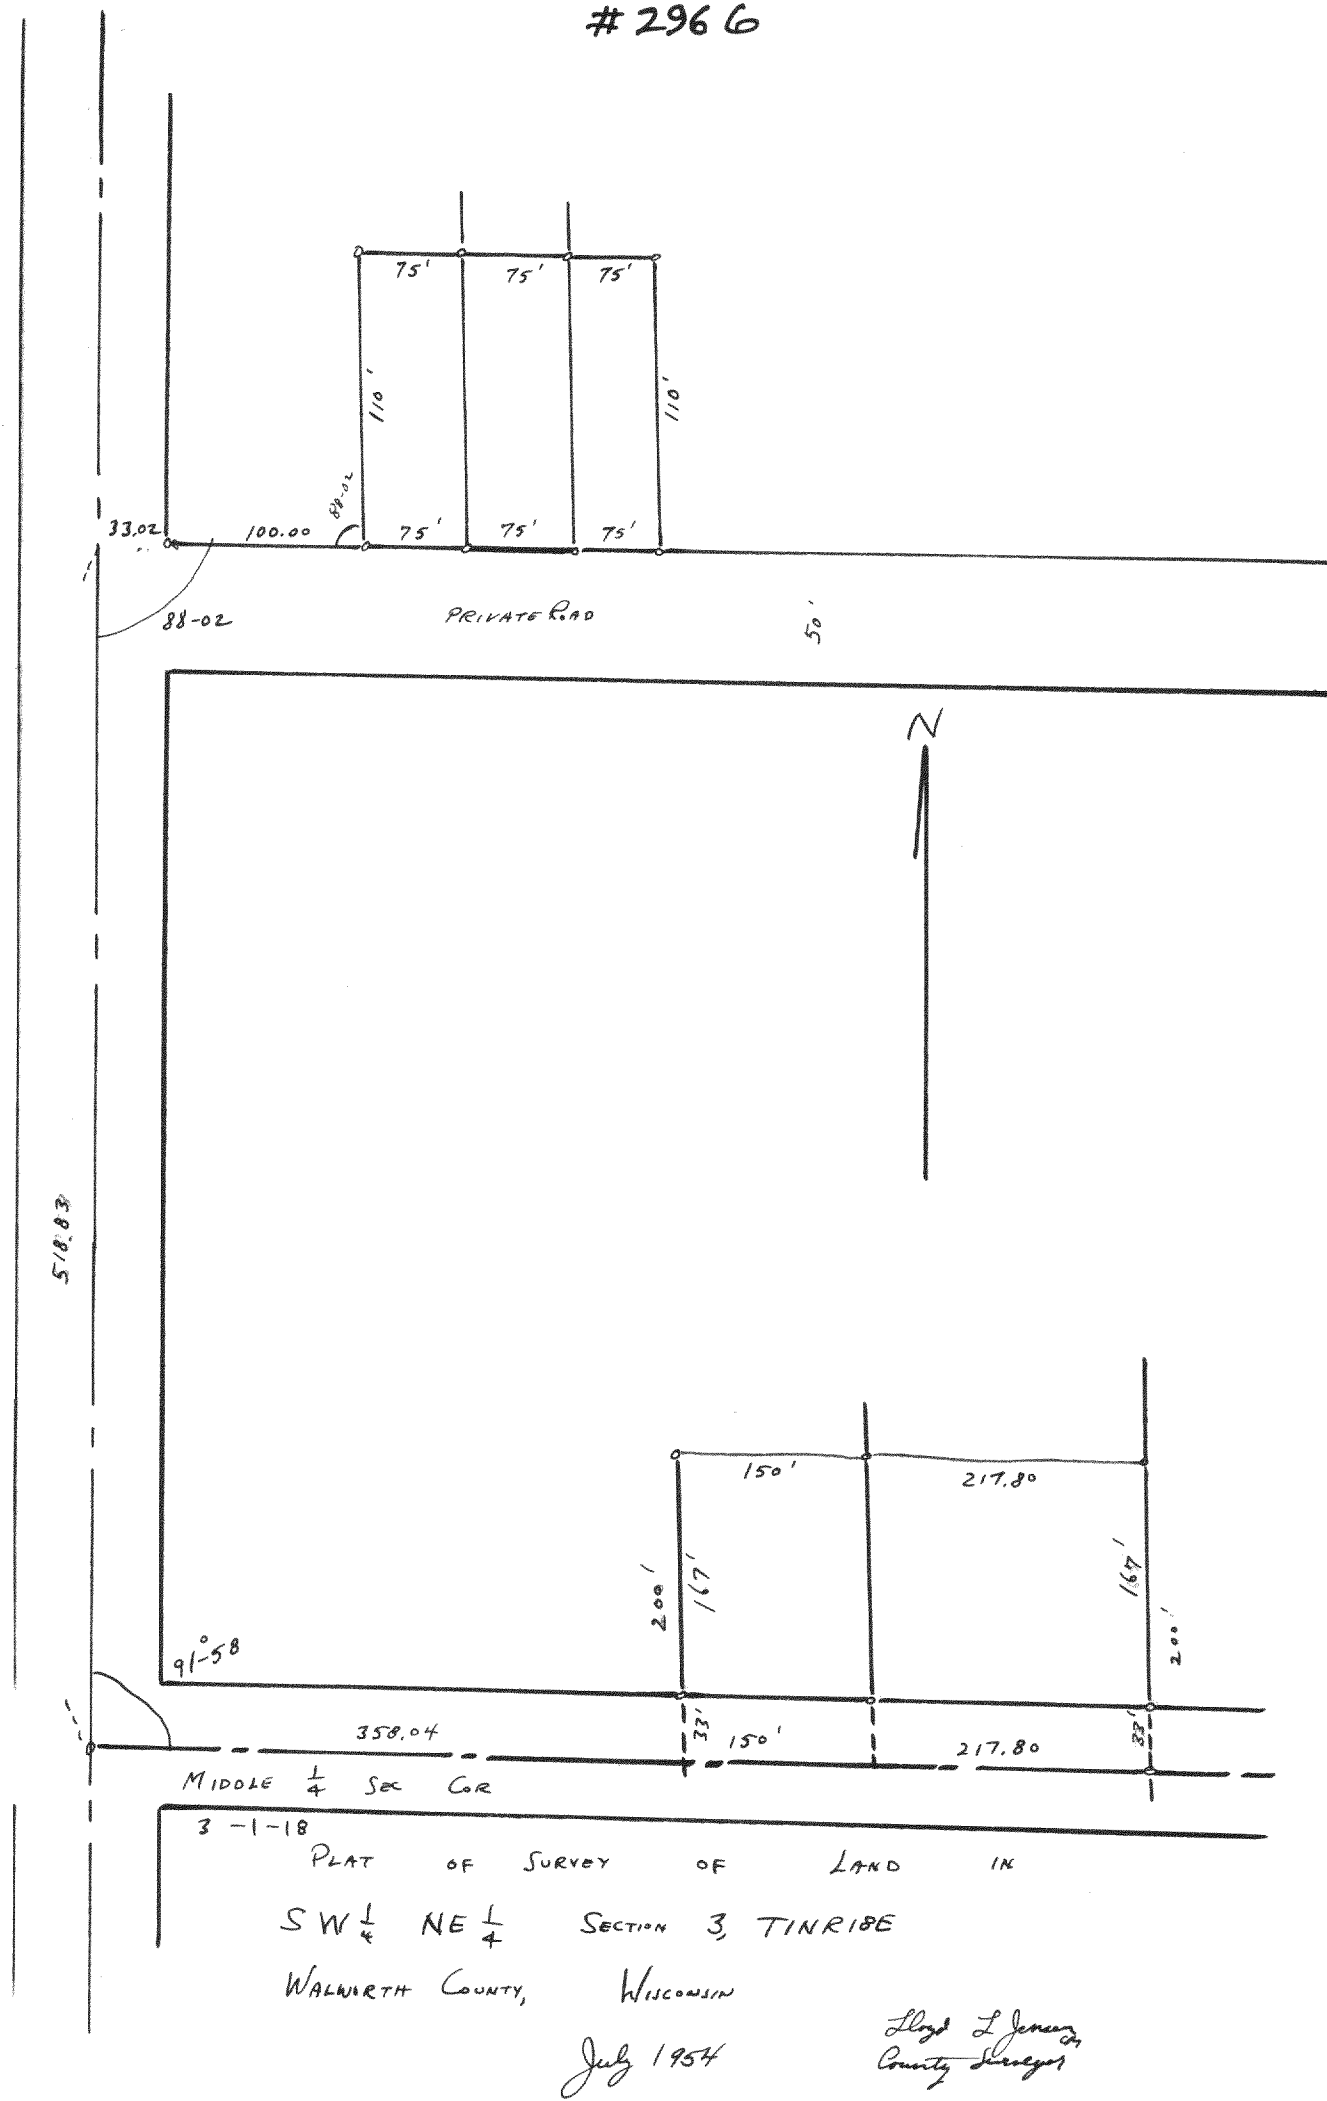

#2967

