



#2975

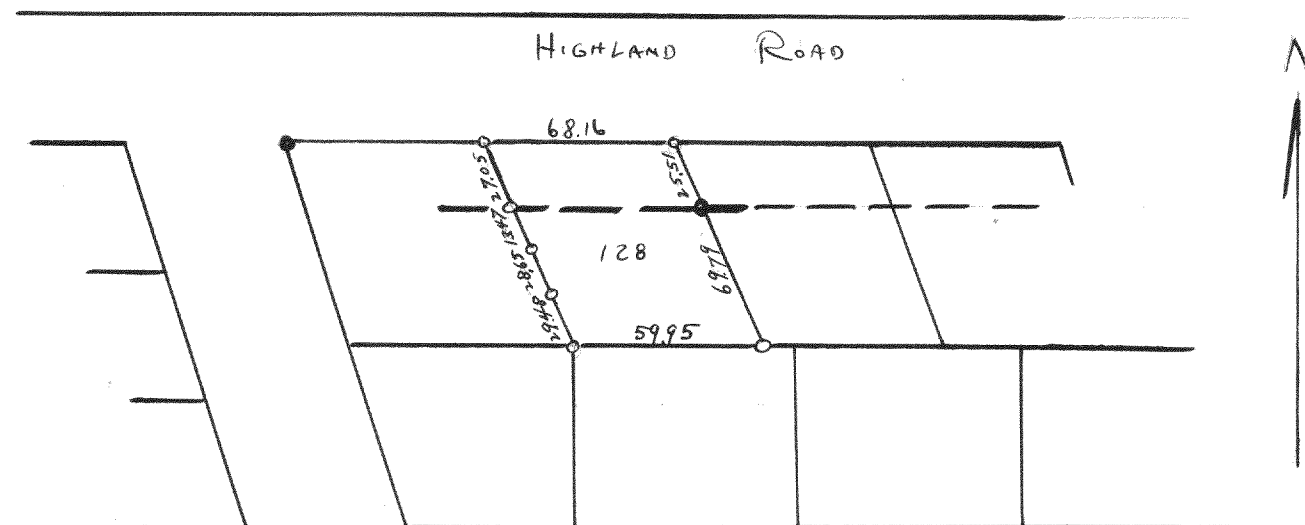

PLAT OF SURVEY OF LOT 128 CEDAR POINT PARK
2ND ADDN VILLAGE OF WILLIAMS BAY
WALWORTH COUNTY, WISCONSIN
September 1954

Lloyd L Jensen
County Surveyor

#2977

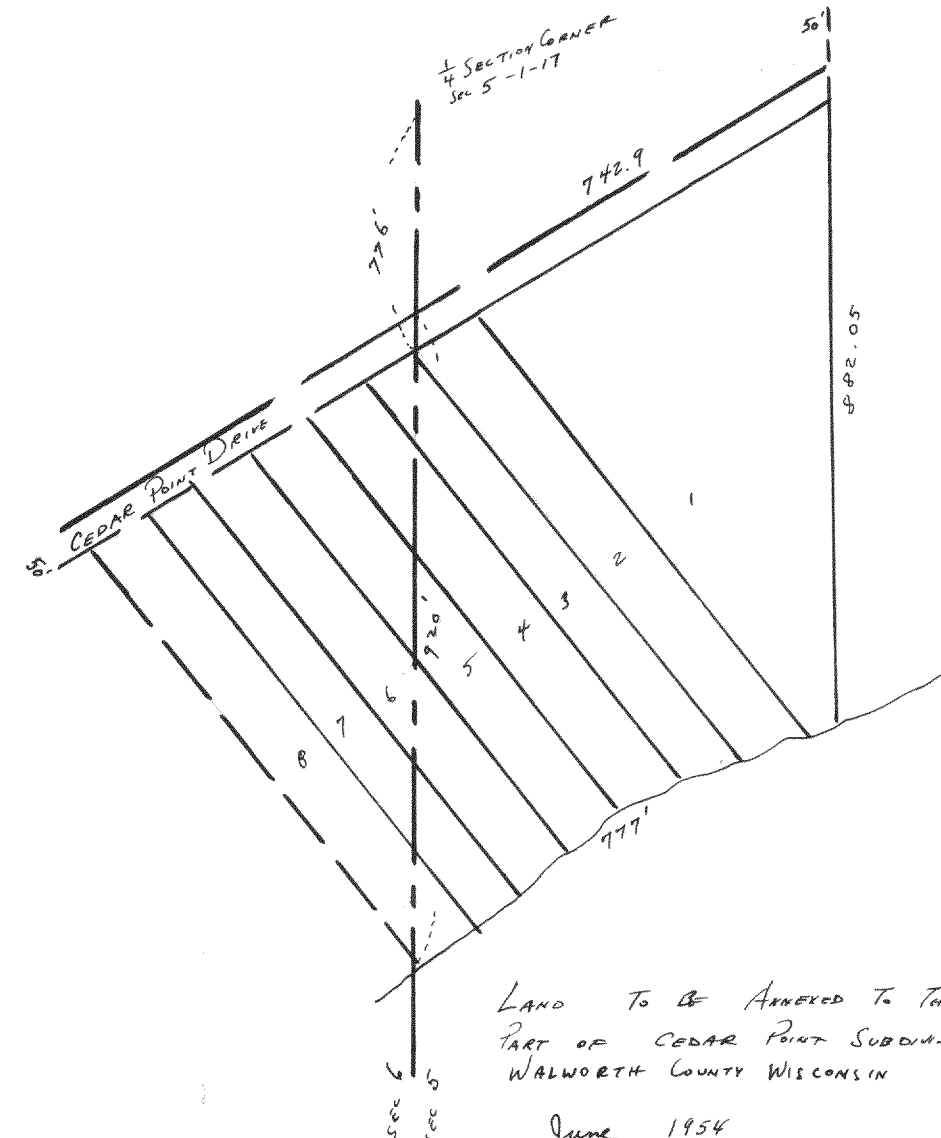


LAND TO BE ANNEXED TO THE VILLAGE OF WILLIAMS BAY
PART OF CEDAR POINT SUBDIVISION IN SEC 5 T14N R17E
WALWORTH COUNTY, WISCONSIN

June 1954

Lloyd L Jensen
County Surveyor


#2976

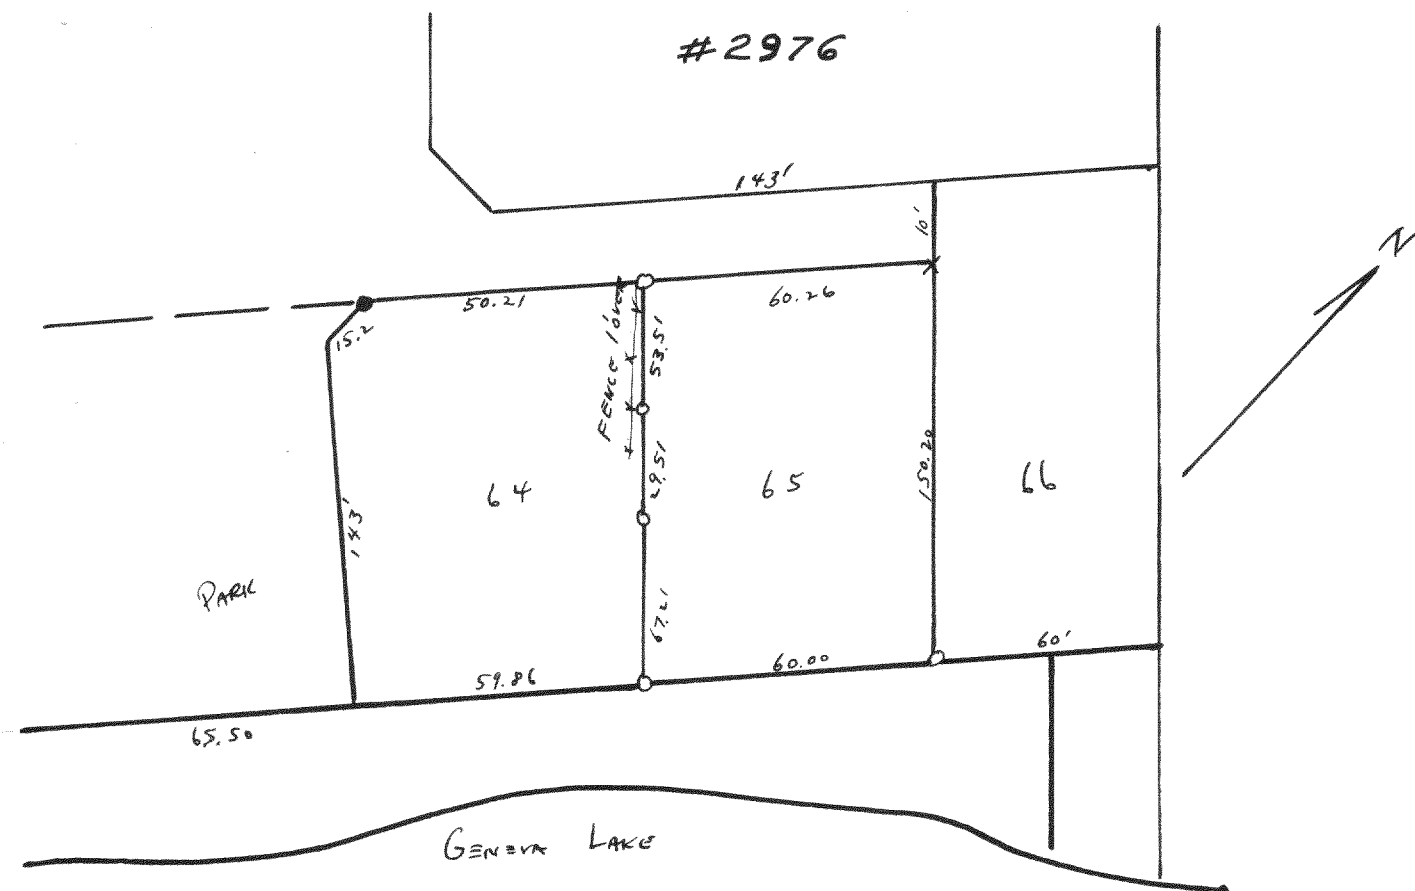

PLAT OF SURVEY OF LOT 65 ORIGINAL CEDAR POINT PARK
VILLAGE OF WILLIAMS BAY, WALWORTH COUNTY, WISCONSIN
September 1954

Lloyd L Jensen
County Surveyor

#2978

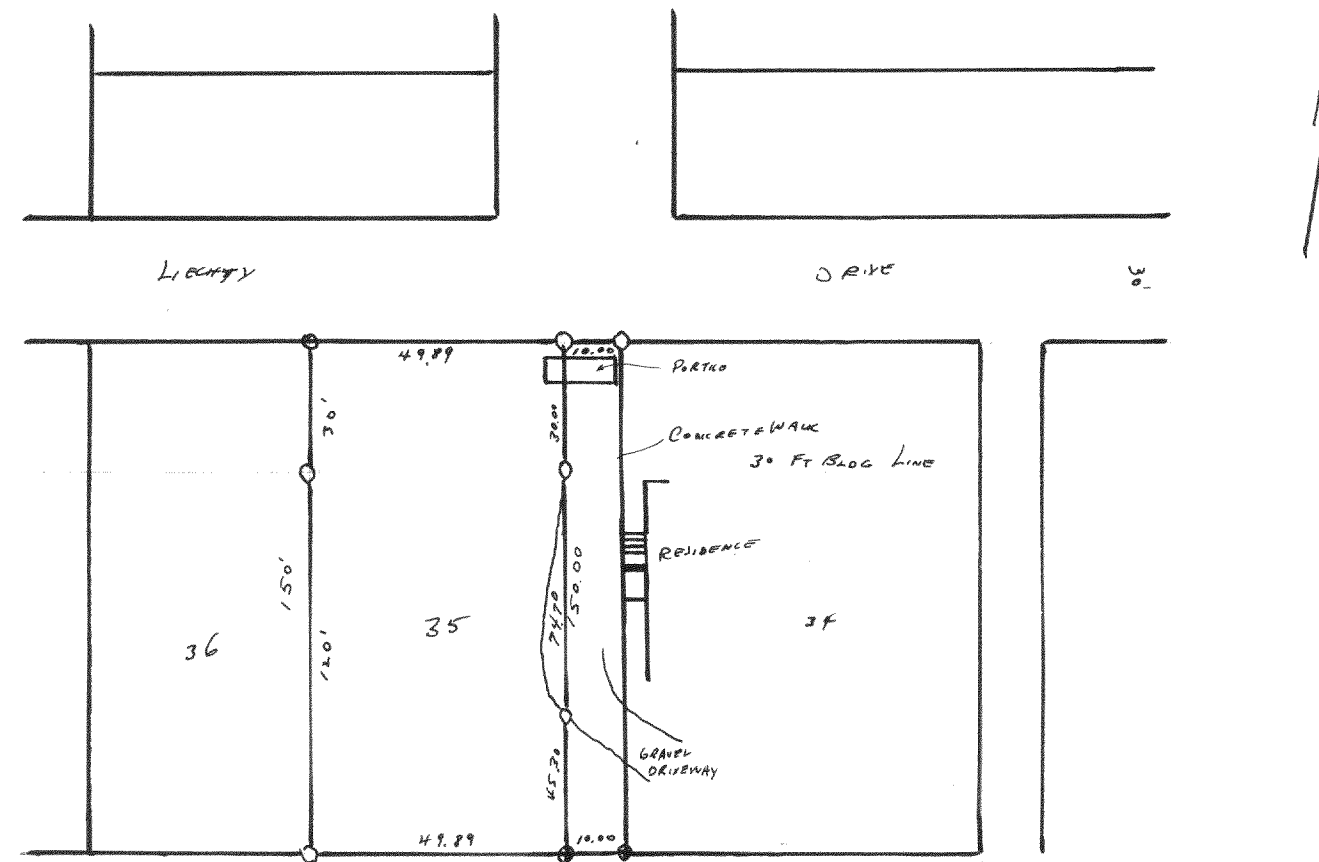

PLAT OF SURVEY OF WEST 50' OF LOT 35 OF SUMMERHAVEN IN THE VILLAGE
OF WILLIAMS BAY, WALWORTH COUNTY, WISCONSIN

February 1954

Lloyd L Jensen
County Surveyor