



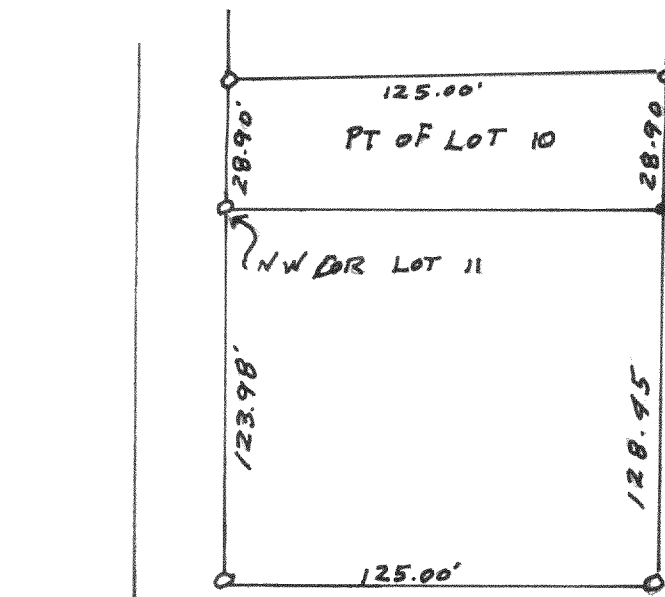

#4850

PLAT OF SURVEY
OF
Part of LOT 10 & LOT 11 of
Sylvan TIZAC Subd. TIN RITE
Wal. Co. Wis.
1967


Lloyd L. Jensen
LLOYD L. JENSEN
COUNTY SURVEYOR

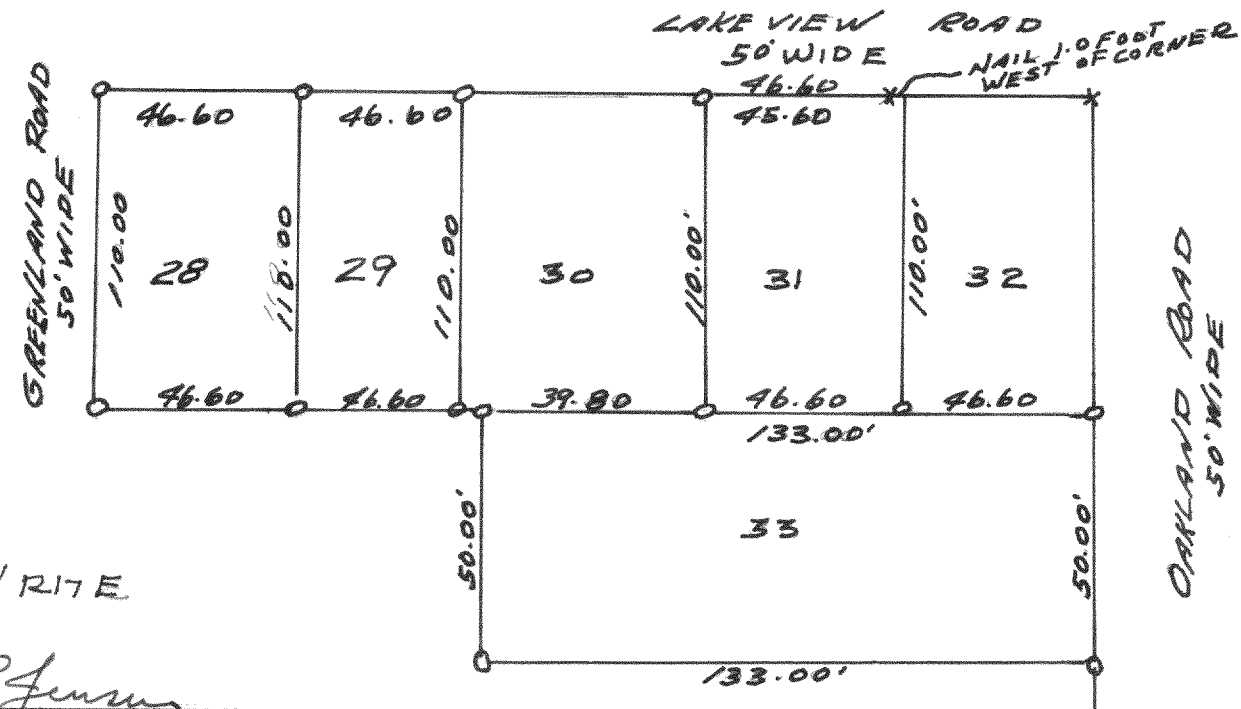

#4851

PLAT OF SURVEY
OF
LOTS 28, 29, 31 and 32, LAKE GENEVA
HIGHLANDS LOCATED IN THE
SE 1/4 SECTION 8, TIN RITE WAL. CO. WIS.
SEPT. 9, 1967

Lloyd L. Jensen
LLOYD L. JENSEN
COUNTY SURVEYOR

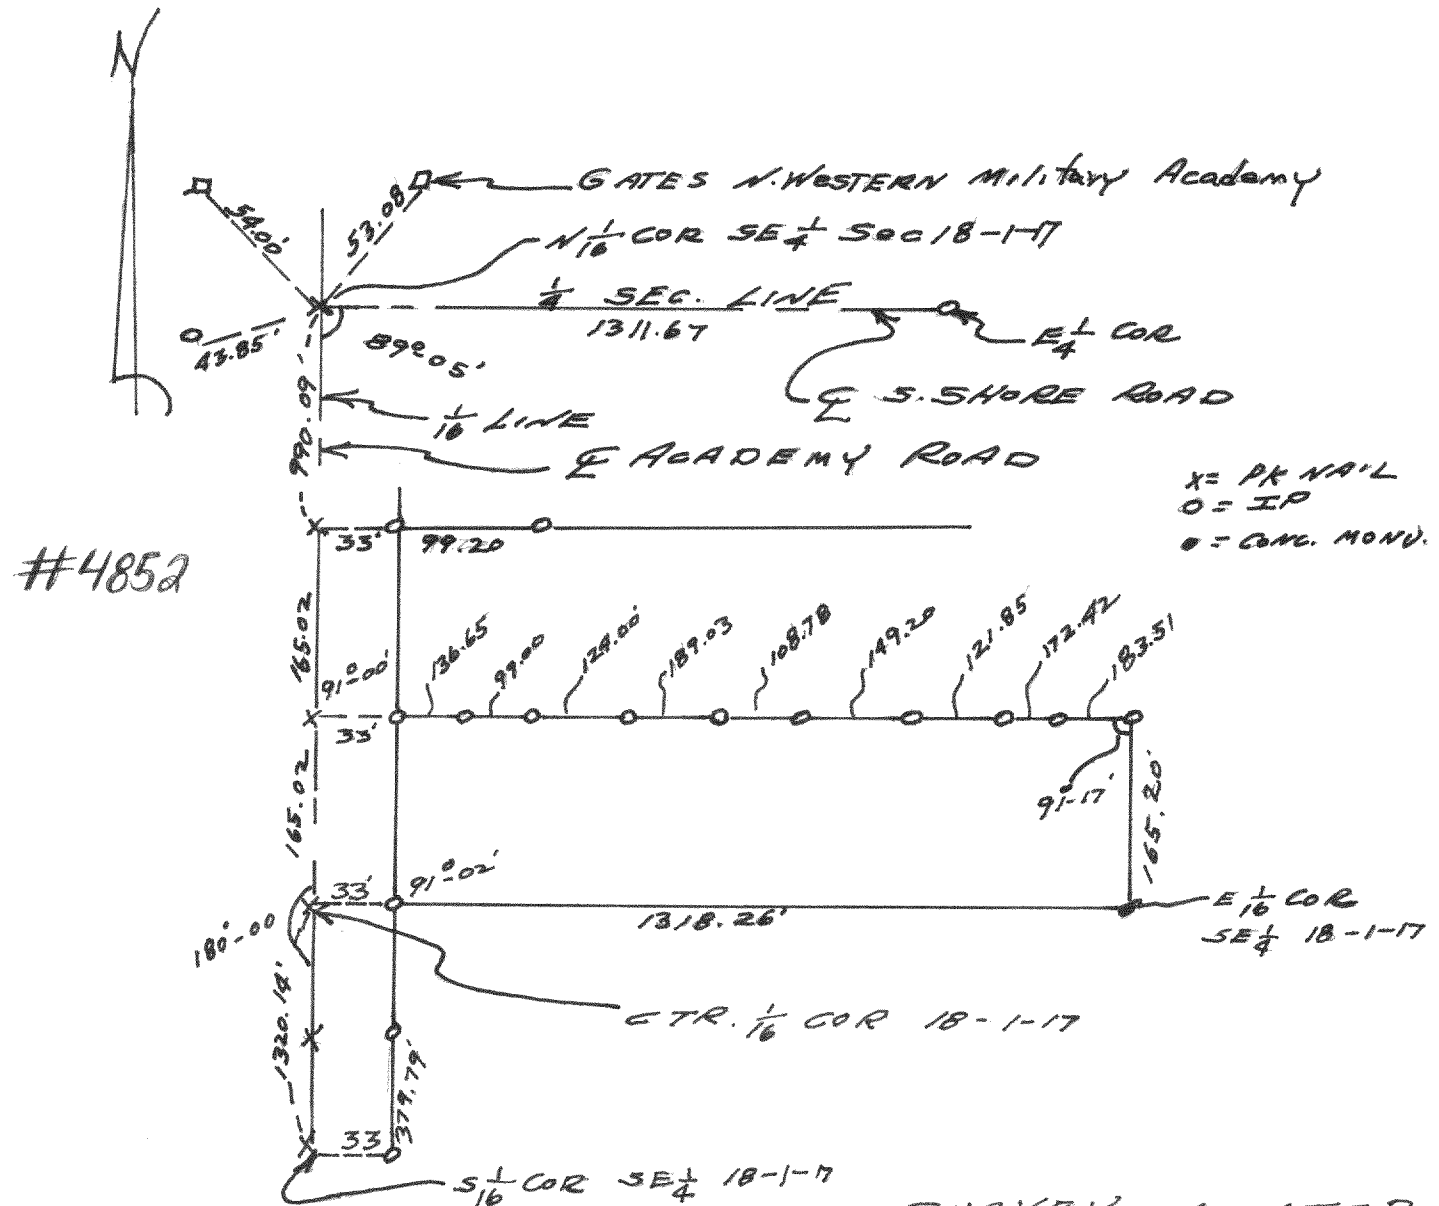


#4852

SURVEY LOCATED IN THE
SE 1/4 SECTION 18, TIN RITE WAL. CO. WIS.
1967

Lloyd L. Jensen
LLOYD L. JENSEN
COUNTY SURVEYOR

#4853

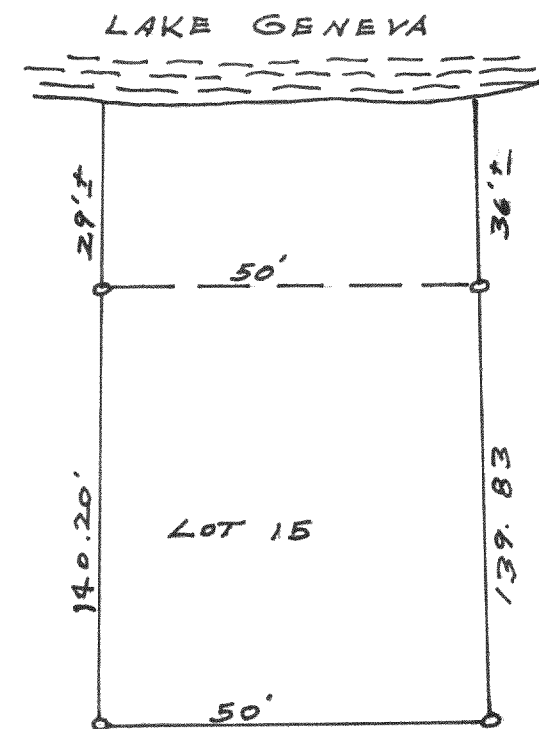

PLAT OF SURVEY
OF
LOT 15 LAKE GENEVA
HIGHLANDS SEC. 18
TIN RITE, WAL. CO. WIS.
OCT 6, 1966

Lloyd L. Jensen
LLOYD L. JENSEN
COUNTY SURVEYOR