

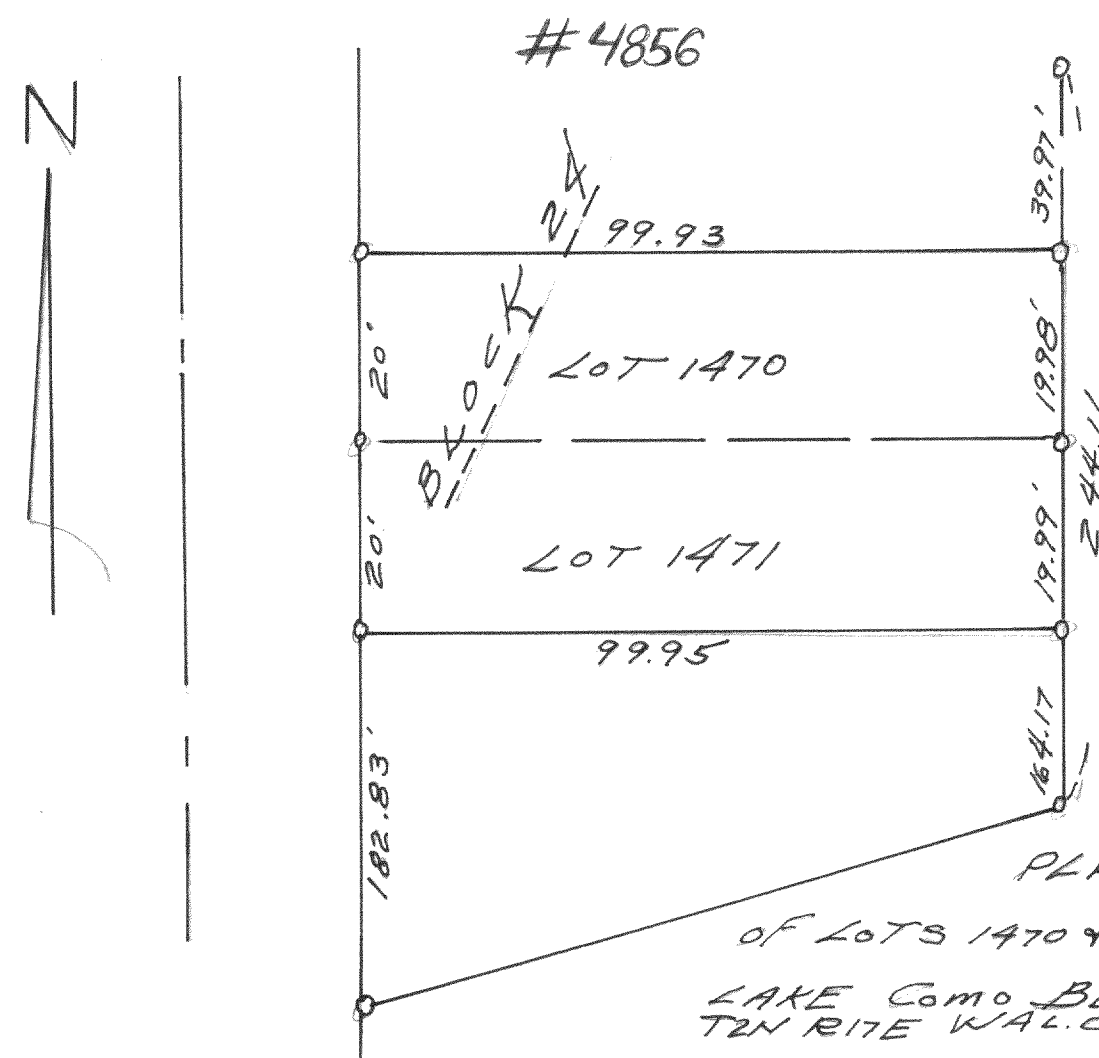


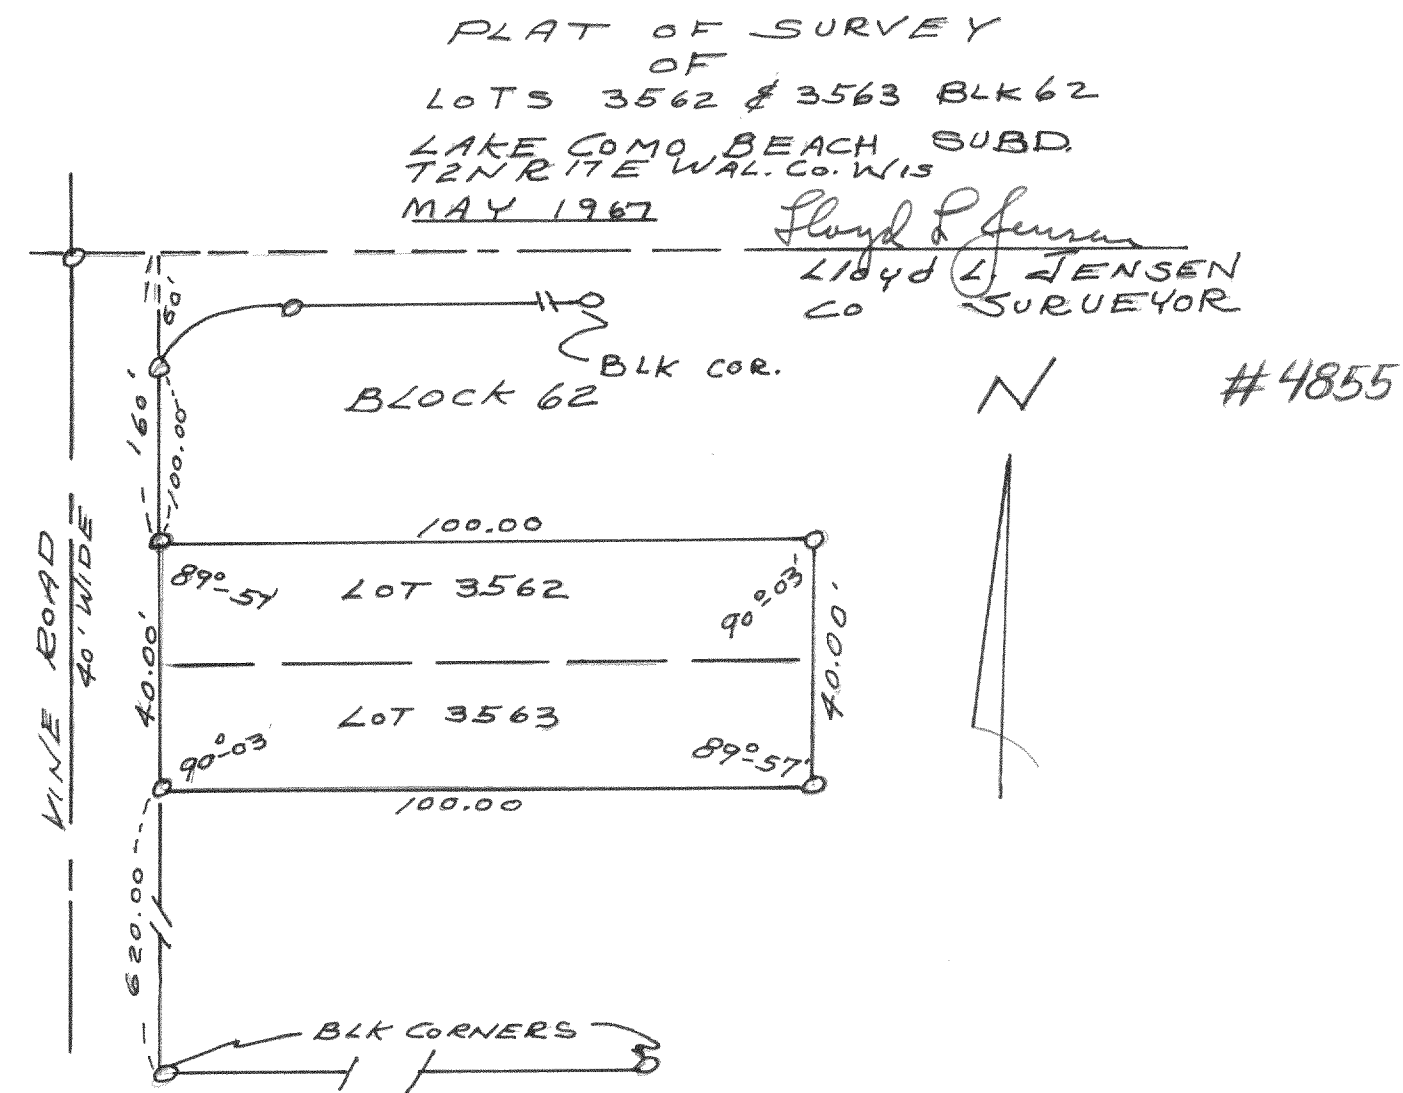

PLAT OF SURVEY
OF LOTS 1470 & 1471 BLOCK 24
LAKE Como BEACH SUBD.
TEN RITE WAL. CO. WIS.

APRIL 1967 Lloyd L. Jensen
LLOYD L. JENSEN
COUNTY SURVEYOR

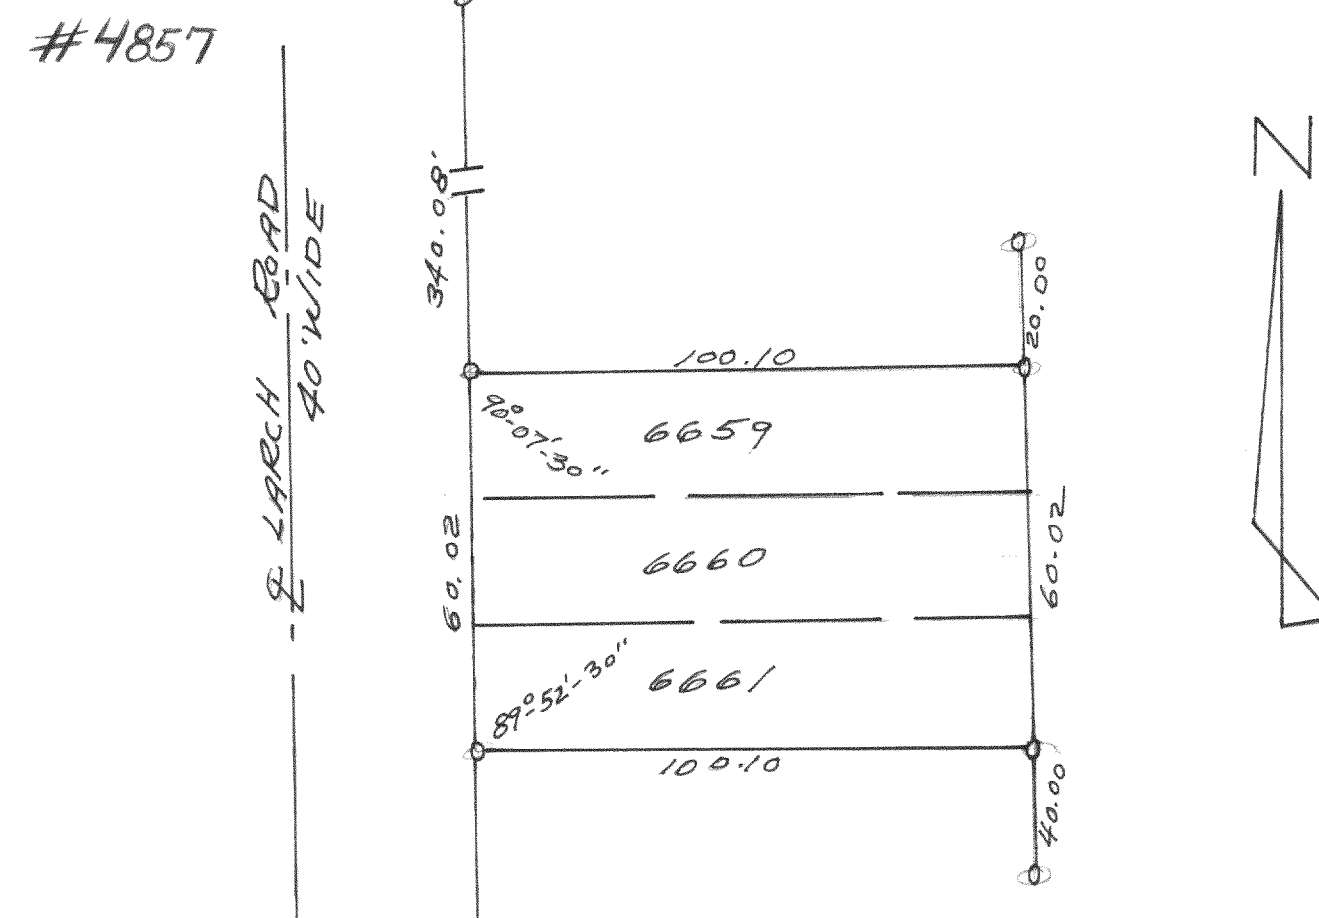

PLAT OF SURVEY
OF
LOTS 6659-6661 BLK 114
LAKE COMO BEACH SUBD. T2N R17E
WIAL. CO. WIS
JULY 5, 1966
Lloyd L. Jensen
LLOYD L. JENSEN
CO. SURVEYOR