



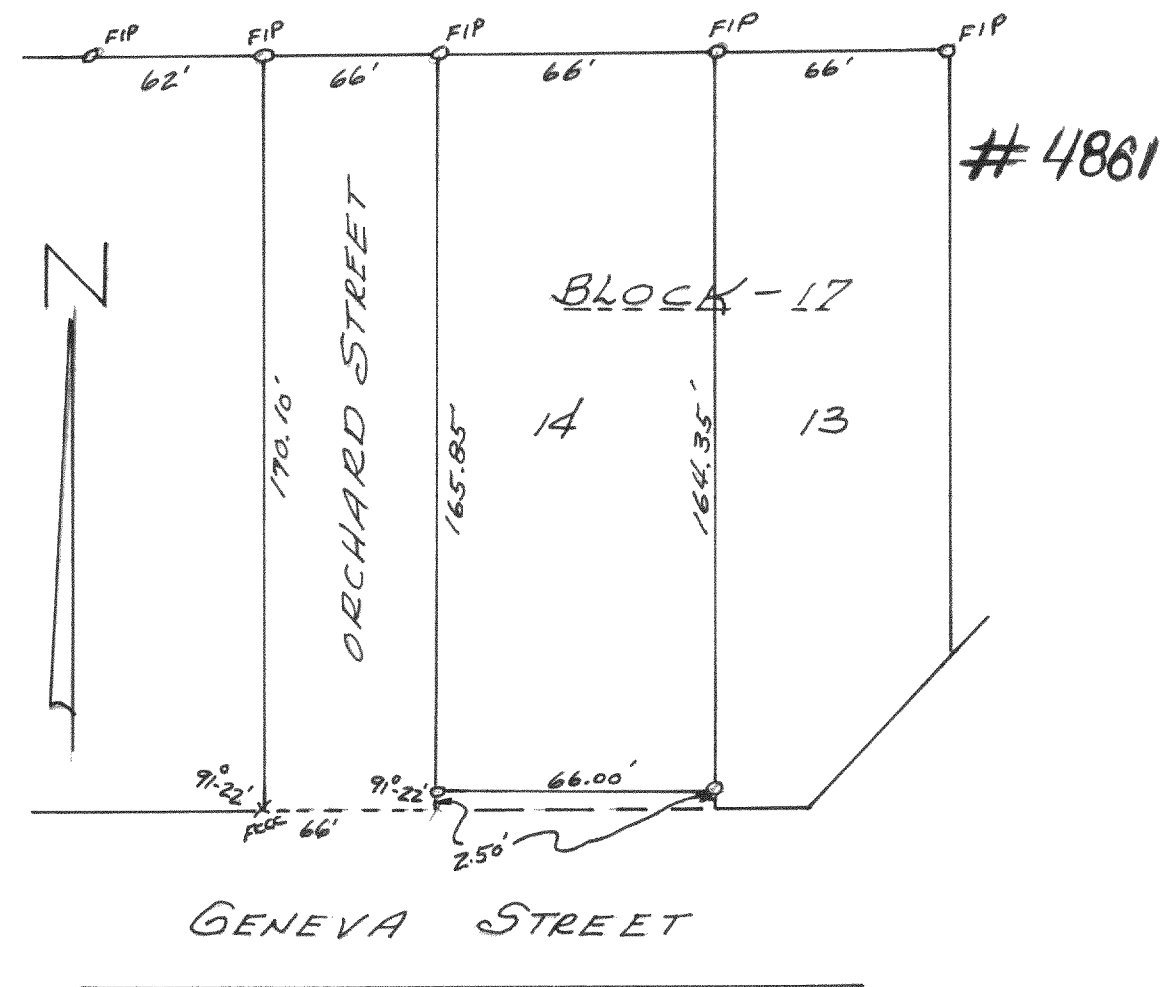

PLAT OF SURVEY OF LOT 14, BLOCK 17
WILLIAMS 2nd Addition, WILLIAMS BAY, WIS.

JULY 1966


#4863

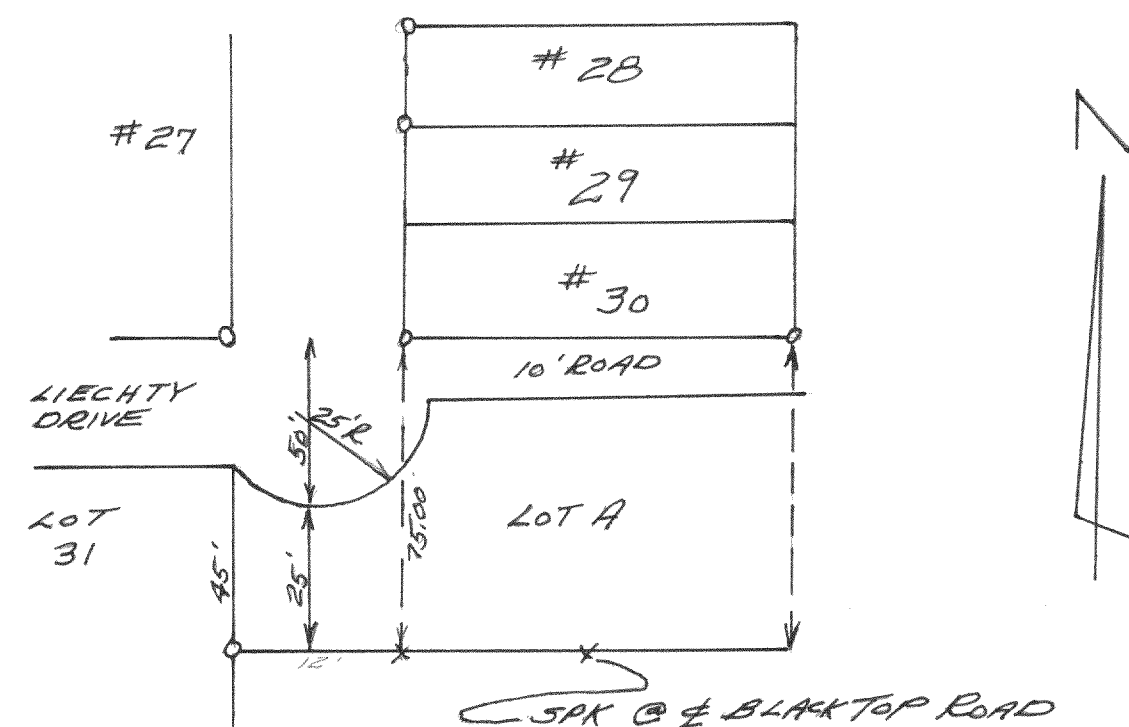


SURVEY OF 25' SETBACK FOR BUILDING
LOT A SUMMER HAVEN, WILLIAMS BAY, WIS.
DEC 1966

Lloyd L. Jensen
COUNTY SURVEYOR

#4862

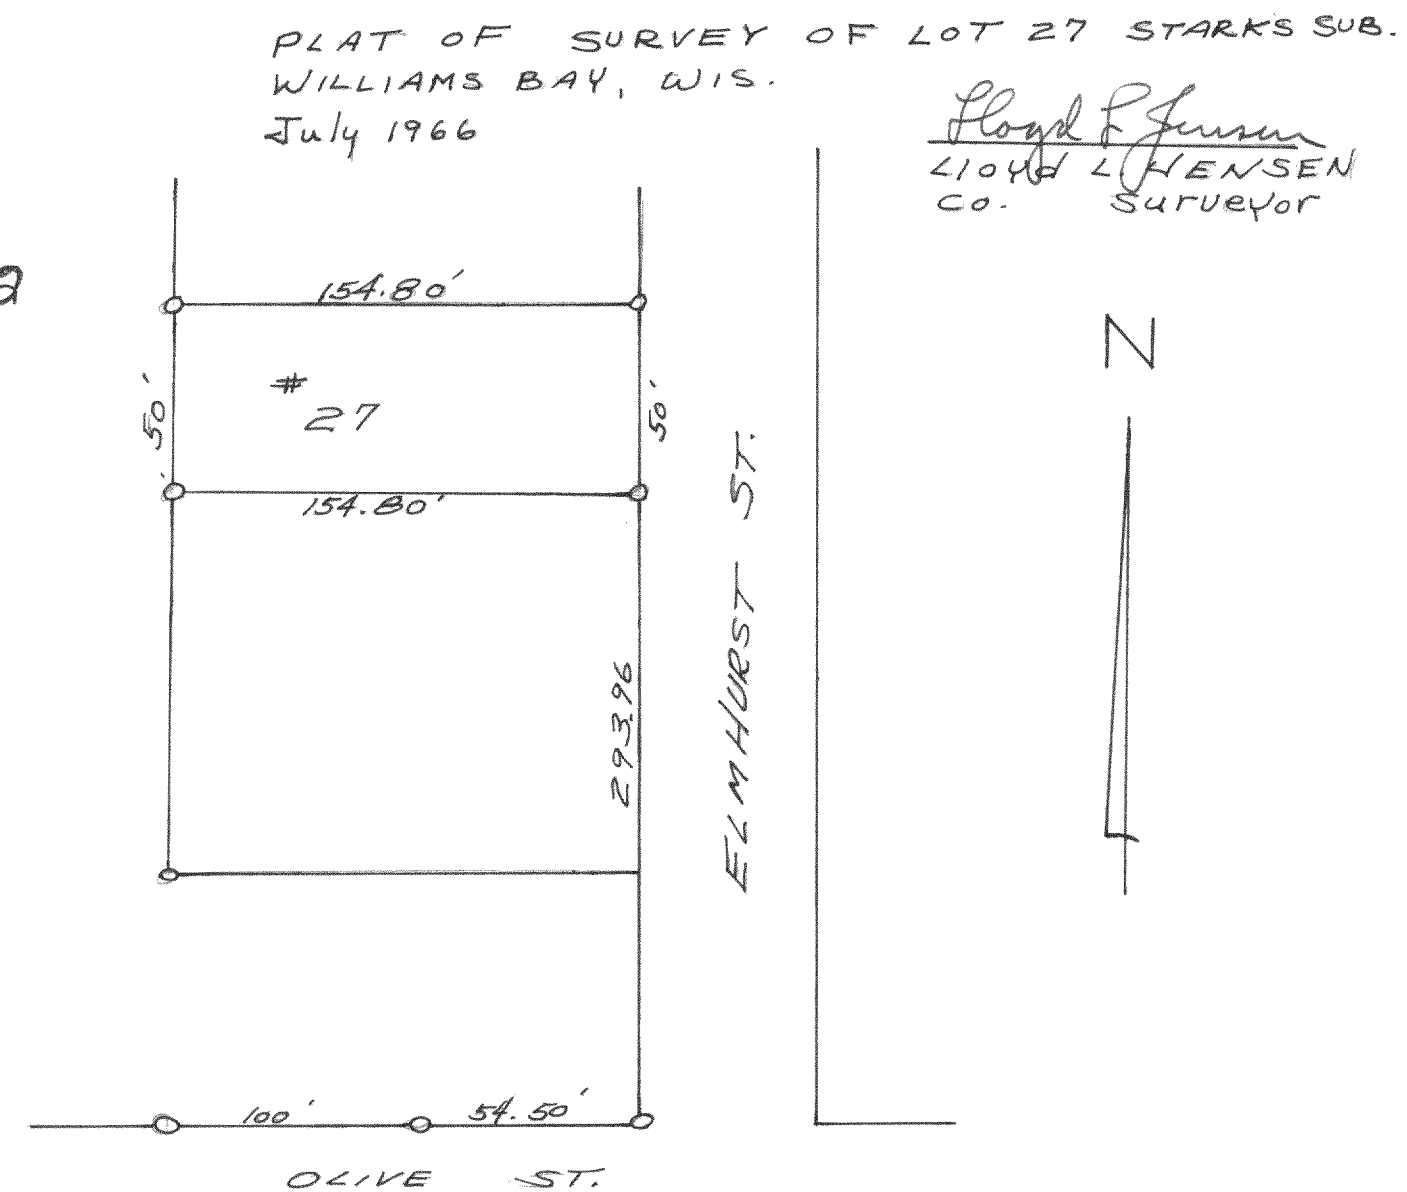

#4864

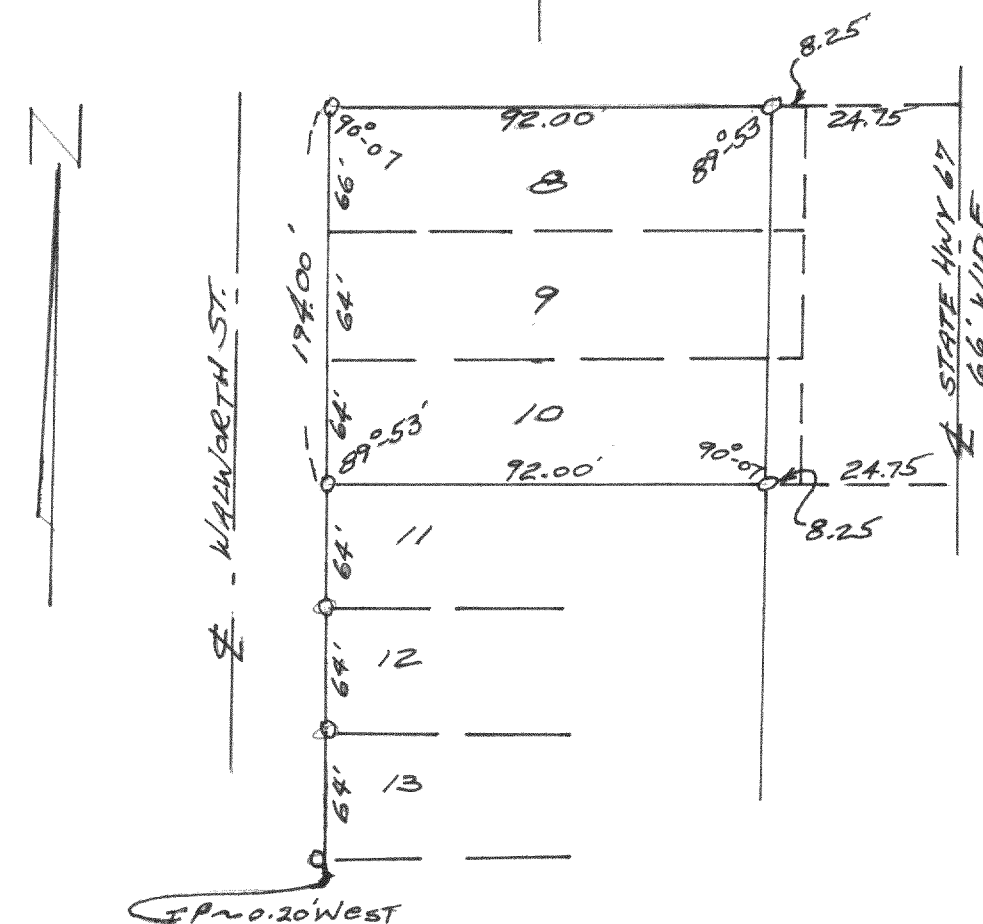

PLAT OF SURVEY OF THE WEST 92'
OF LOTS 8, 9, 10 Wm. H. FRANCIS SUBD.

WILLIAMS BAY, WIS.

AUG 1967

Lloyd L. Jensen
COUNTY SURVEYOR