


PLAT OF SURVEY
OF

#4869

LOT 11 BLOCK B CISCO BEACH
SUBDIVISION LOCATED IN THE NW 1/4
SECTION 5, TIN-RITE, WALWORTH
COUNTY, WISCONSIN.

AUG. 1967

Lloyd L Jensen
COUNTY SURVEYOR

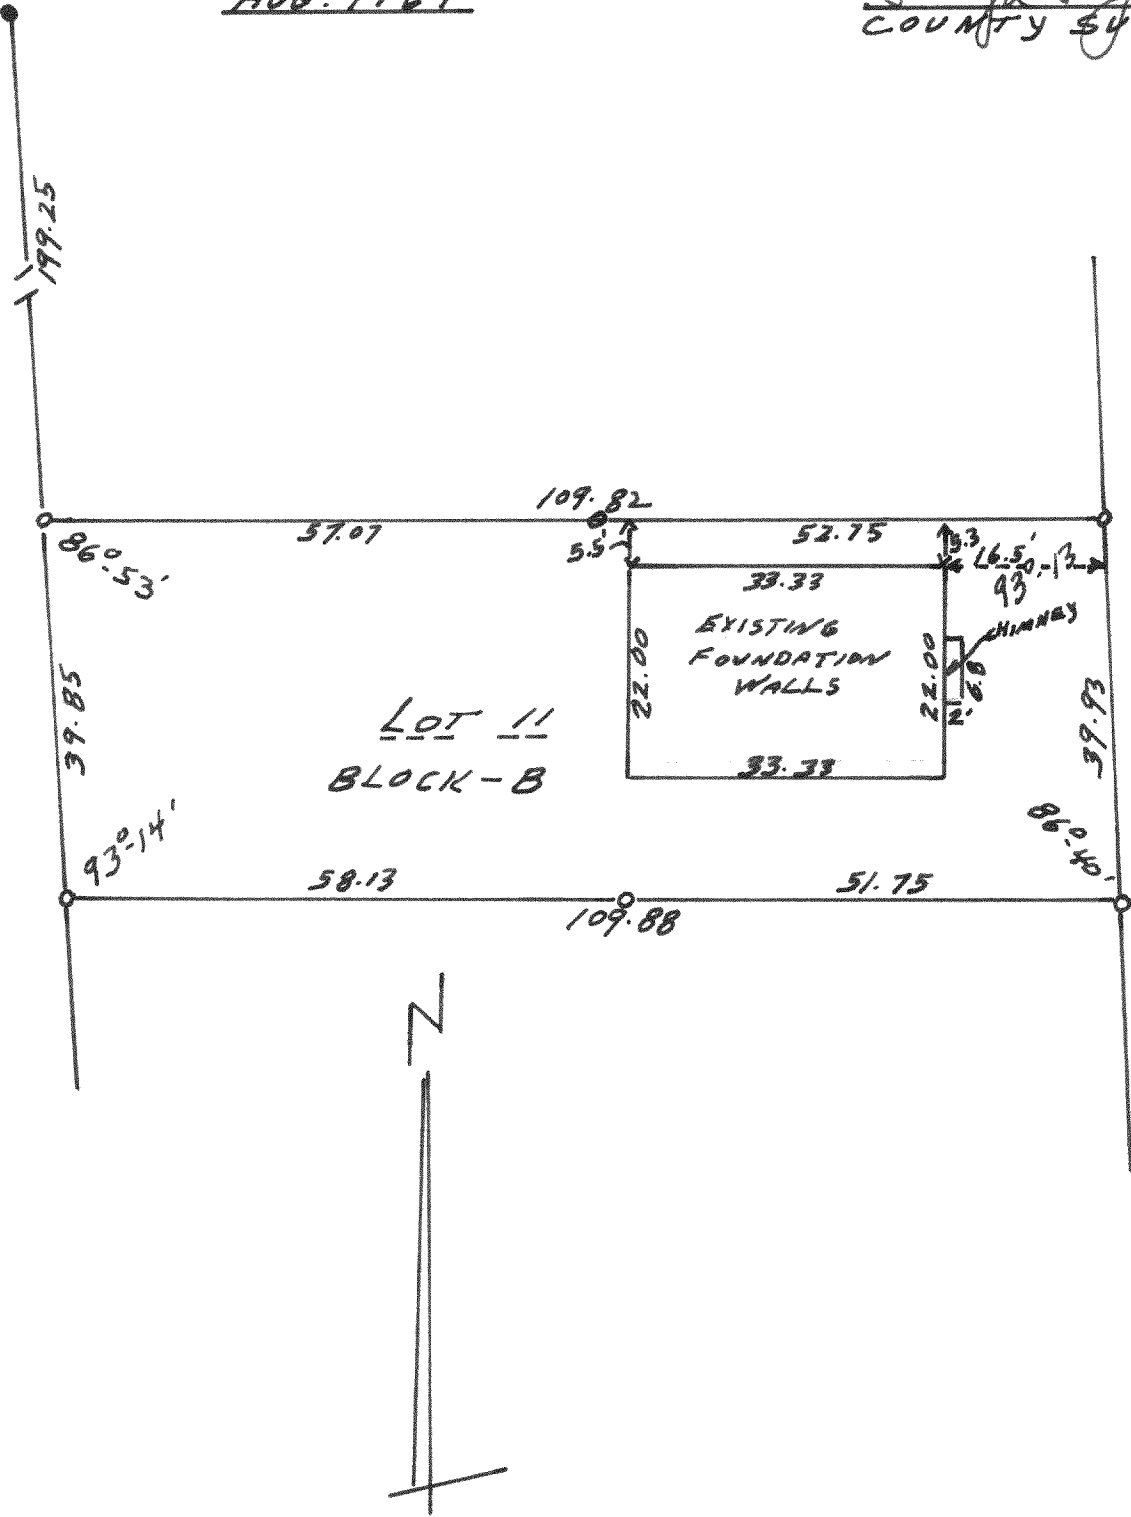

E KNOLLWOOD DRIVE
(50' WIDE)

PLAT OF SURVEY
OF

#4870

LOT 45 CEDAR POINT PARK SUBDIVISION
SE 1/4 SEC. 6, TIN-RITE, WALWORTH CO.
WISCONSIN.

AUG. 1967

Lloyd L Jensen
COUNTY SURVEYOR

