



#2979

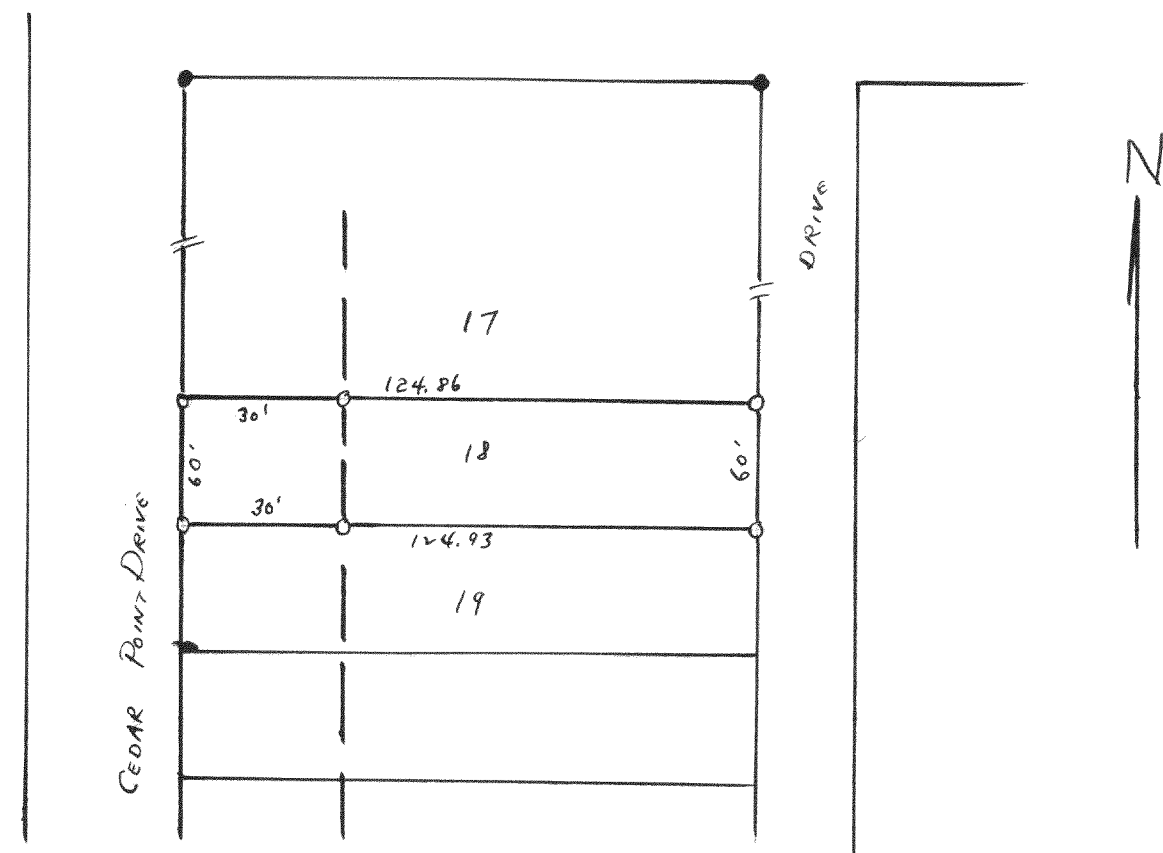


PLAT OF SURVEY OF LOT 18 CEDAR POINT PARK SUBD
VILLAGE OF WILLIAMS BAY WALWORTH COUNTY WISCONSIN
February 1954 Lloyd L Jersey
County Surveyor

#2980

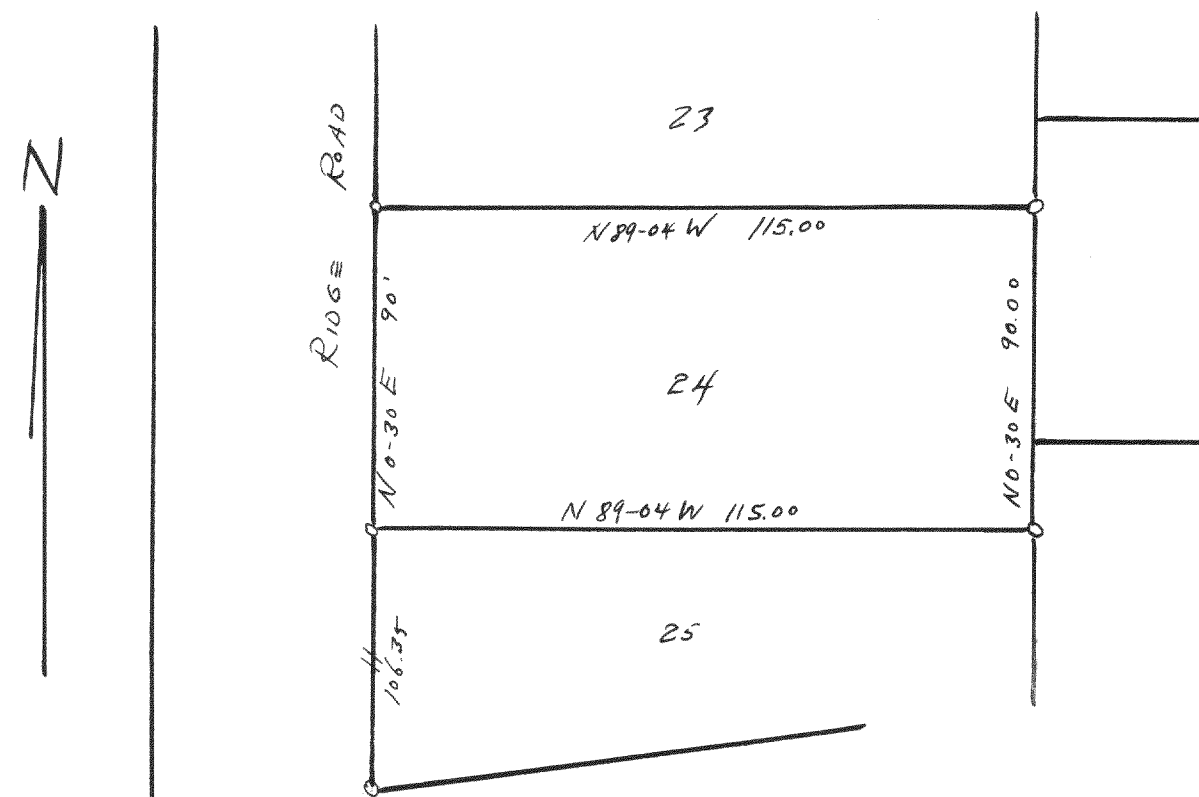


PLAT OF SURVEY OF LOT 24 STURWOOD ADDITION
TO THE CITY OF LAKE GENEVA
WALWORTH COUNTY WISCONSIN
March 1954 Lloyd L Jersey
County Surveyor

#2981

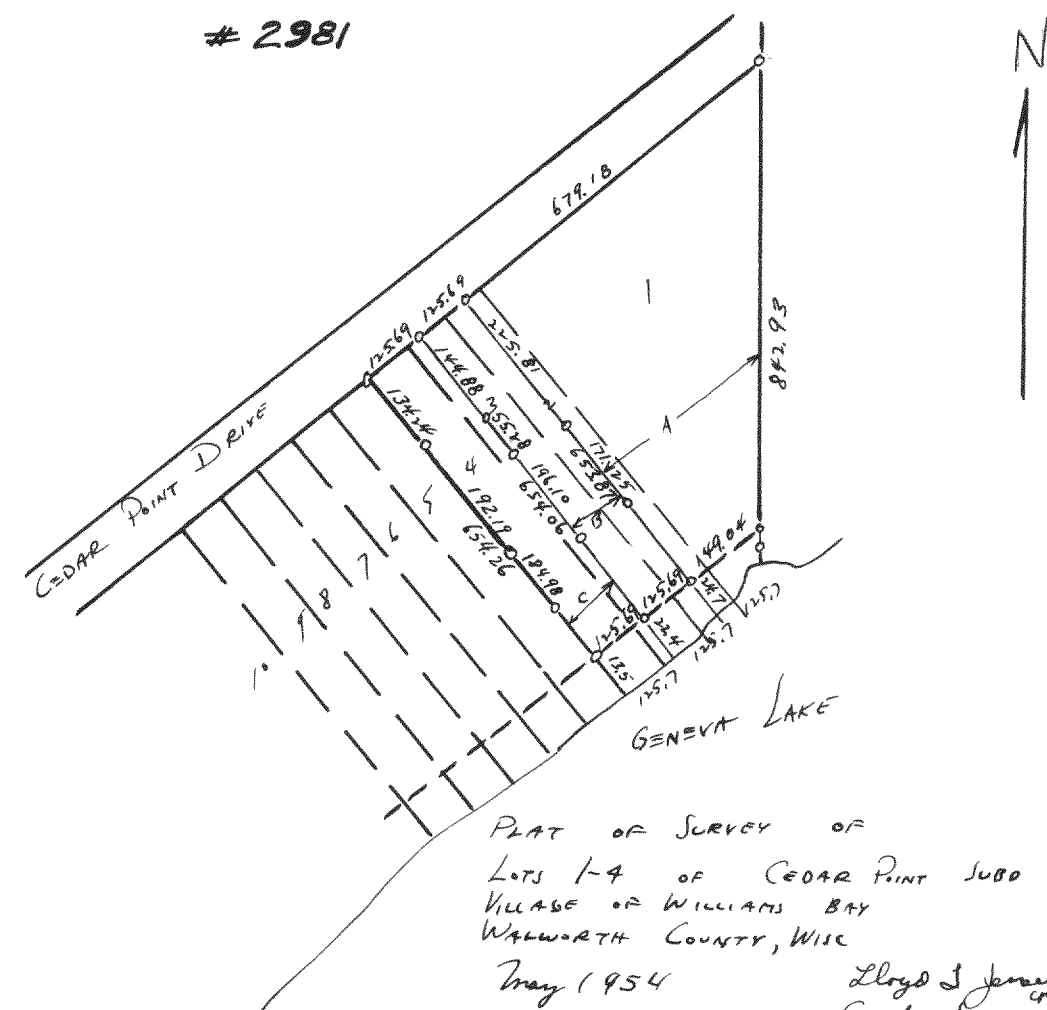

PLAT OF SURVEY OF
LOTS 1-4 OF CEDAR POINT SUBD
VILLAGE OF WILLIAMS BAY
WALWORTH COUNTY, WISC
May 1954 Lloyd L Jersey
County Surveyor

#2982

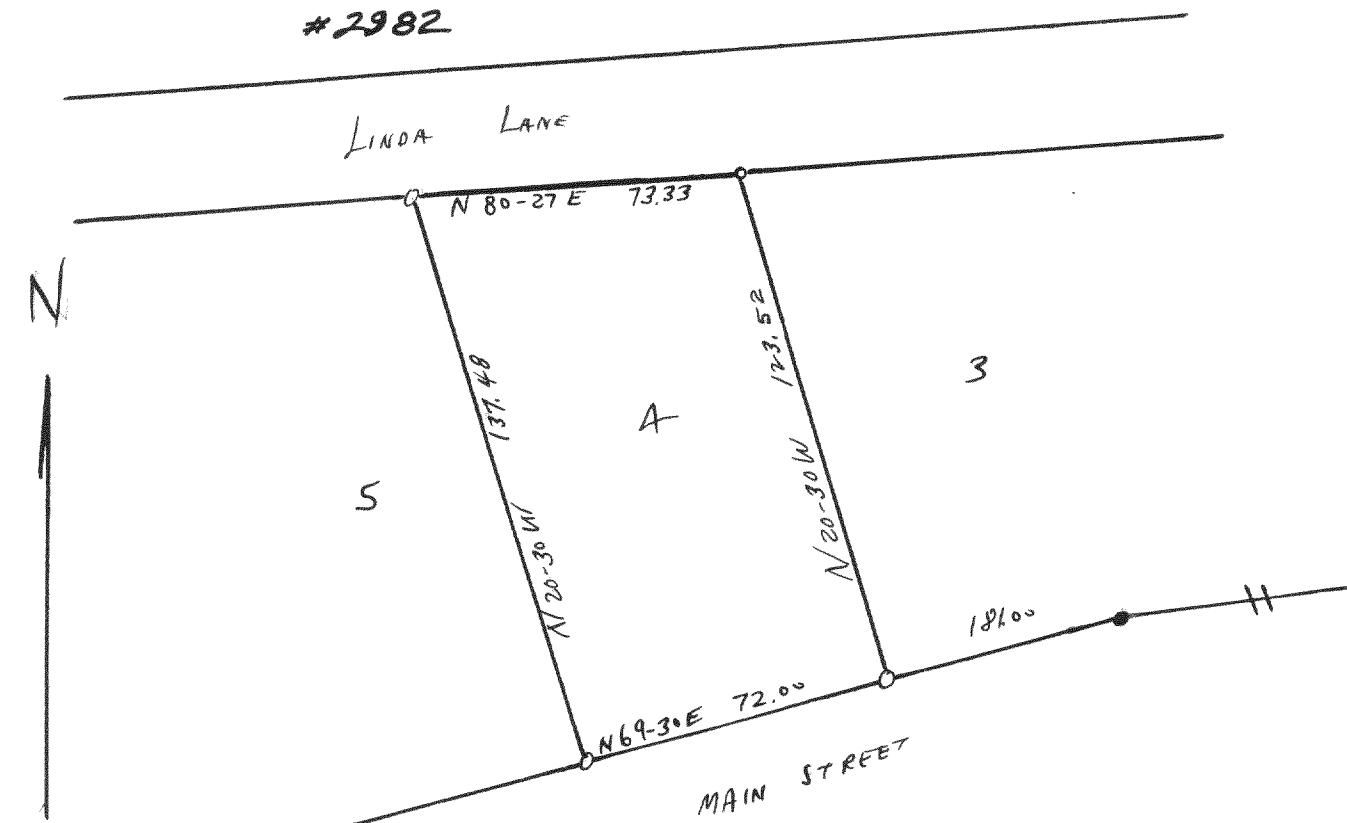

PLAT OF SURVEY OF LOT 4 STURWOOD ADDITION
TO THE CITY OF LAKE GENEVA,
WALWORTH COUNTY, WISCONSIN.
March 1954 Lloyd L Jersey
County Surveyor