


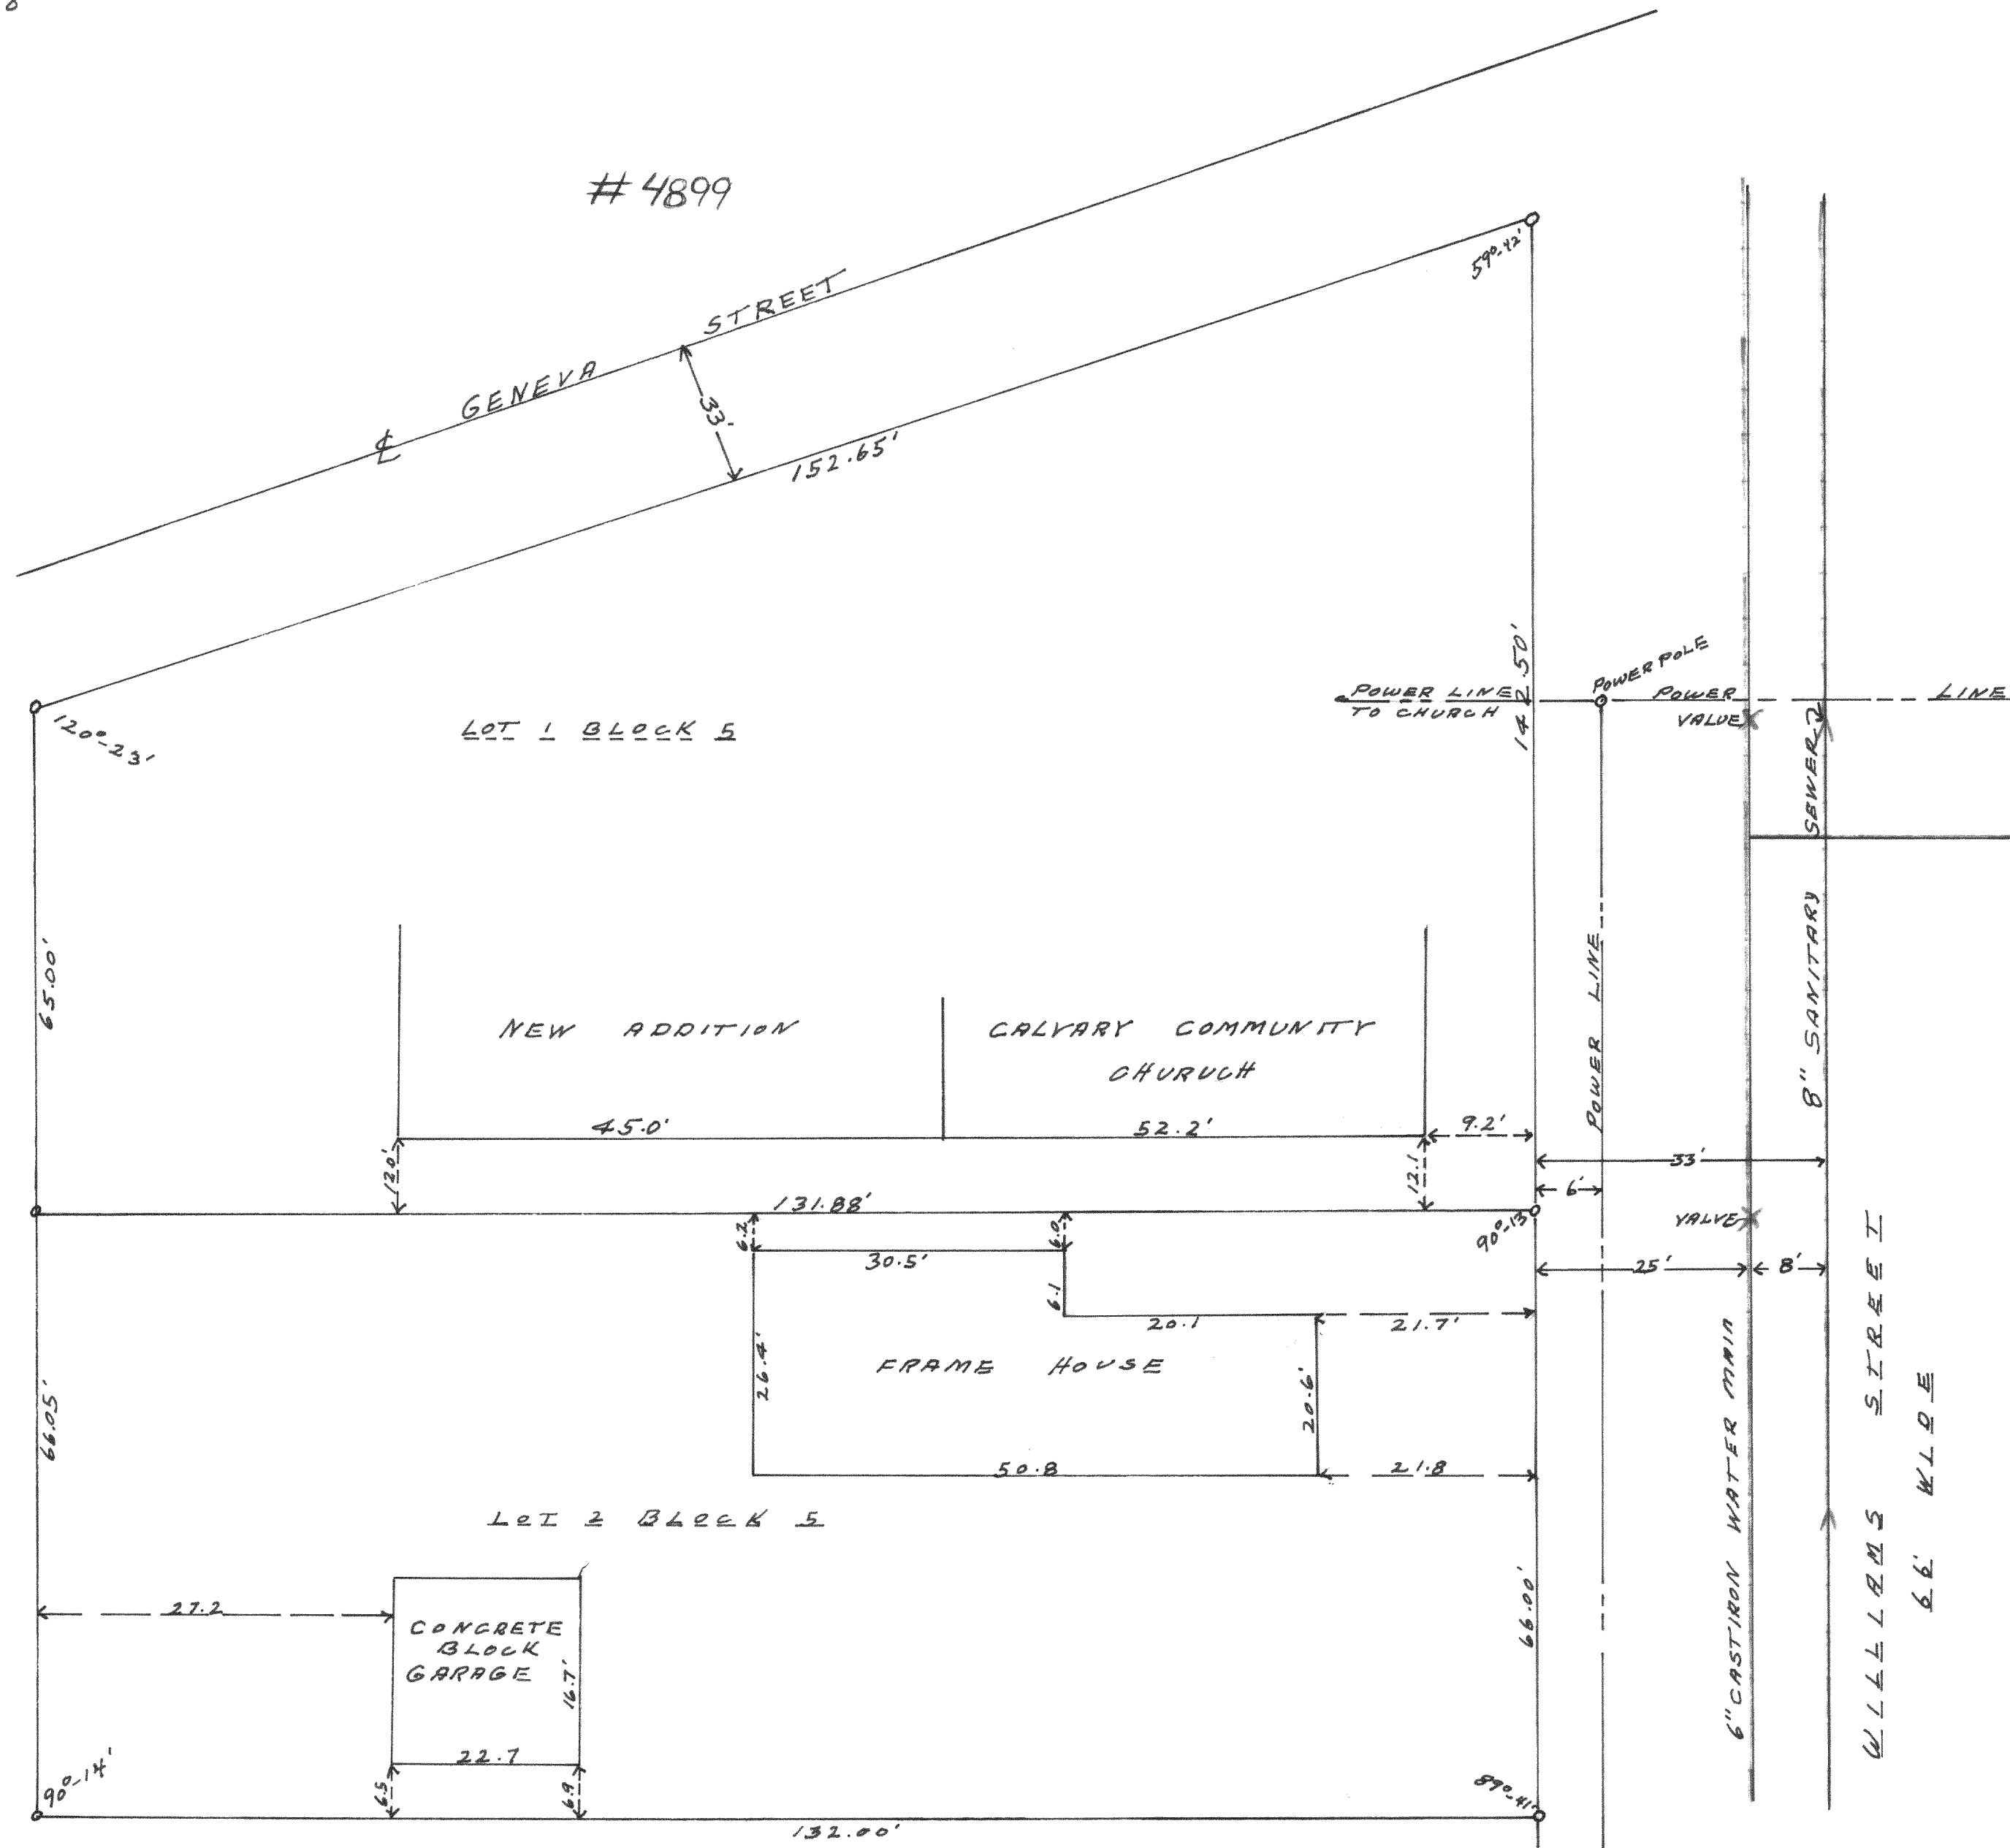

PLAT OF SURVEY

LOTS 1 AND 2 BLOCK 5 ORIGINAL PLAT
OF WILLIAMS BAY WILMOUTH COUNTY
WISCONSIN.

APRIL 15, 1967

Lloyd J. Jensen
COUNTY SURVEYOR