
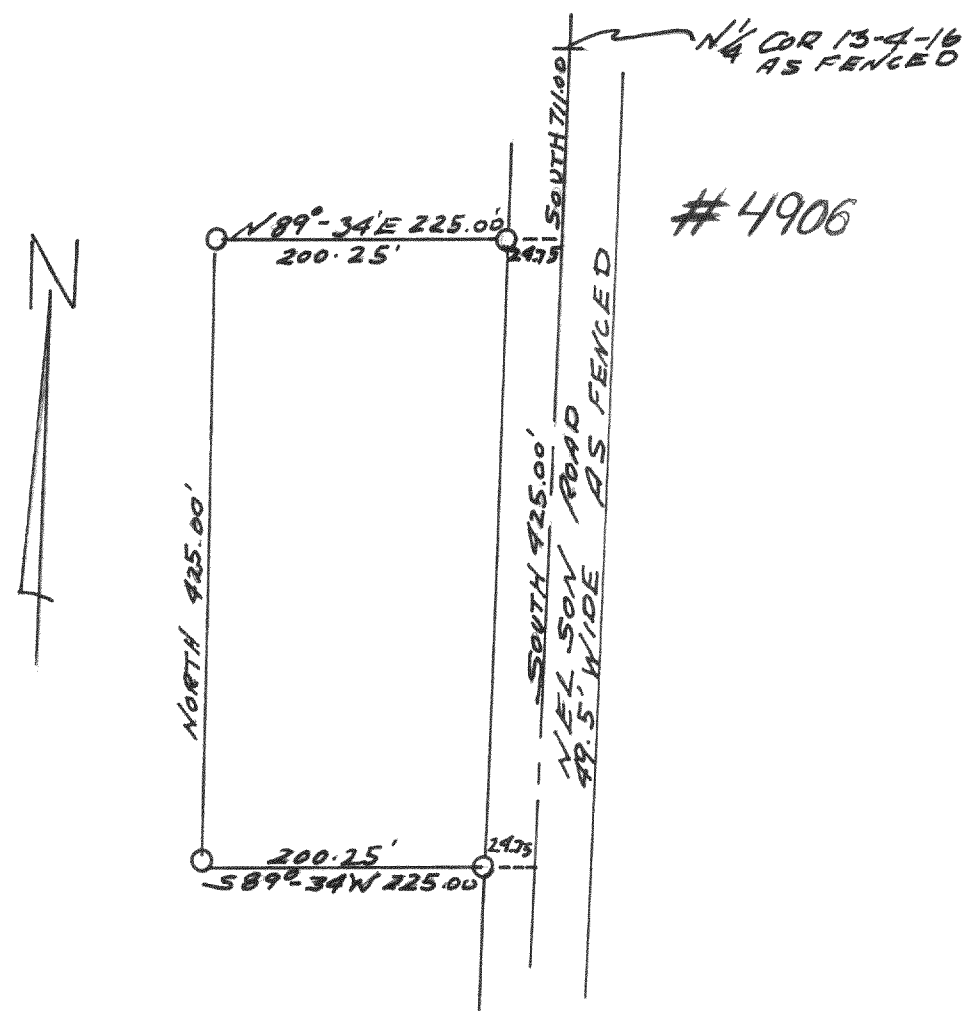
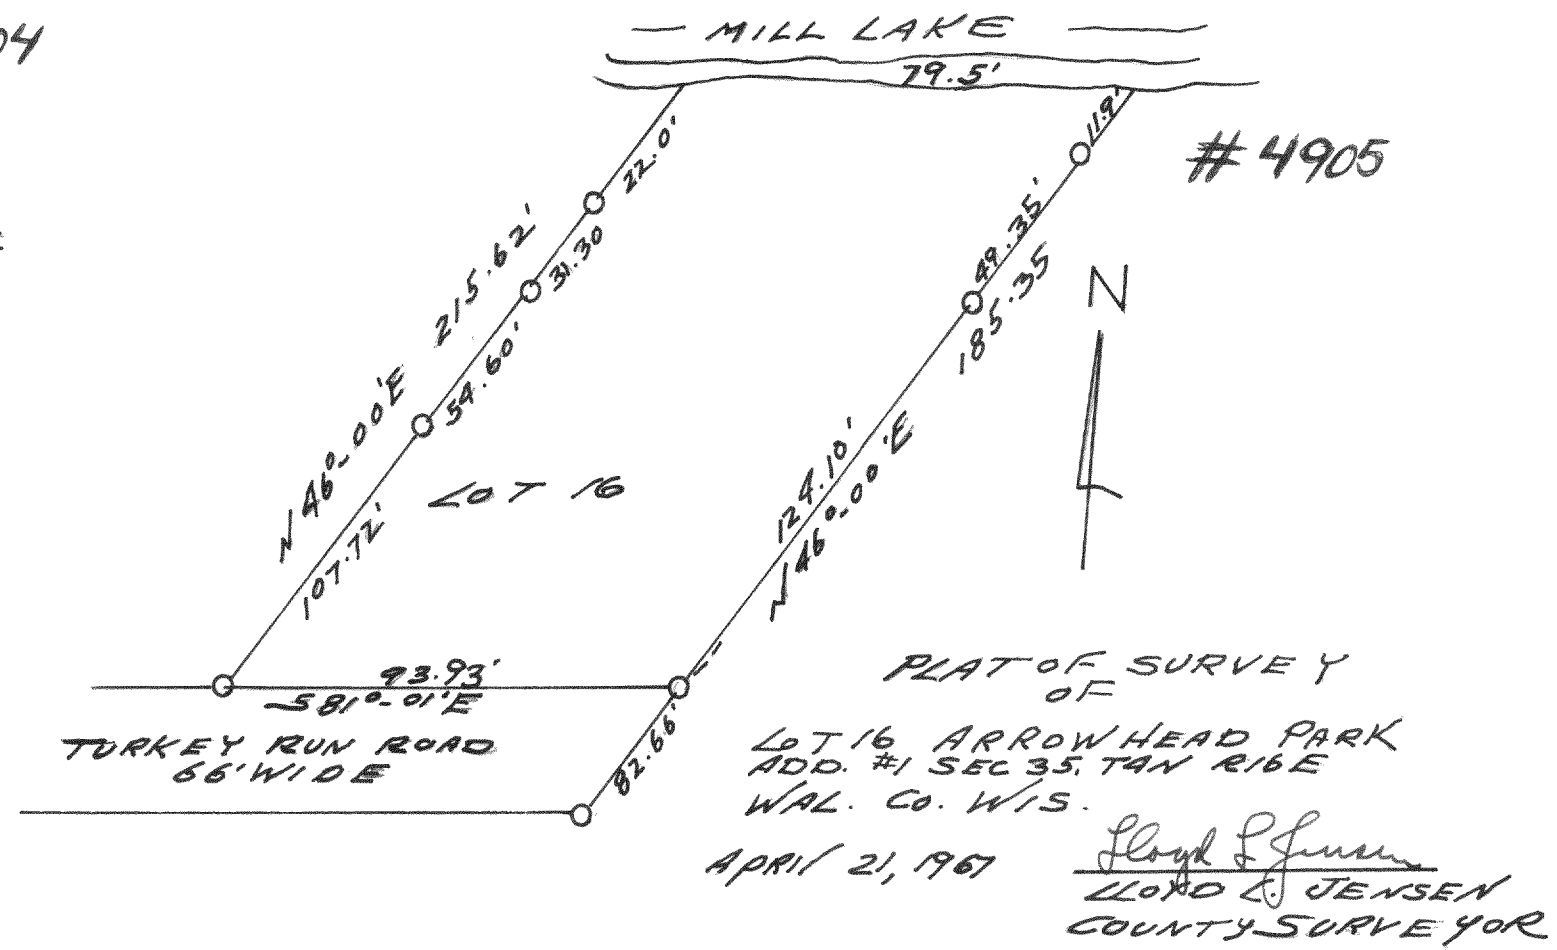


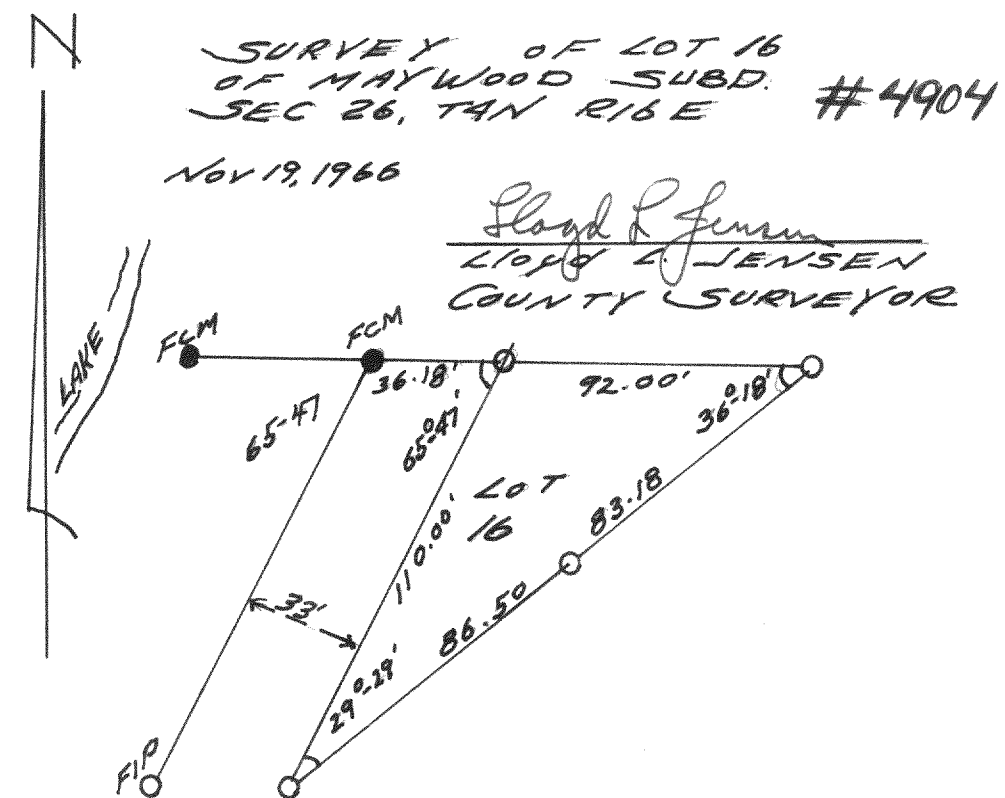

PLAT OF SURVEY
OF

PARCEL LOCATED IN THE
NW 1/4 SEC 13, TAN R16E WAL. CO. WIS.

FEB 9, 1967

Lloyd L. Jensen
COUNTY SURVEYOR

