


#4911

MARCH, 1967

Clayton L Jensen
COUNTY SURVEYOR

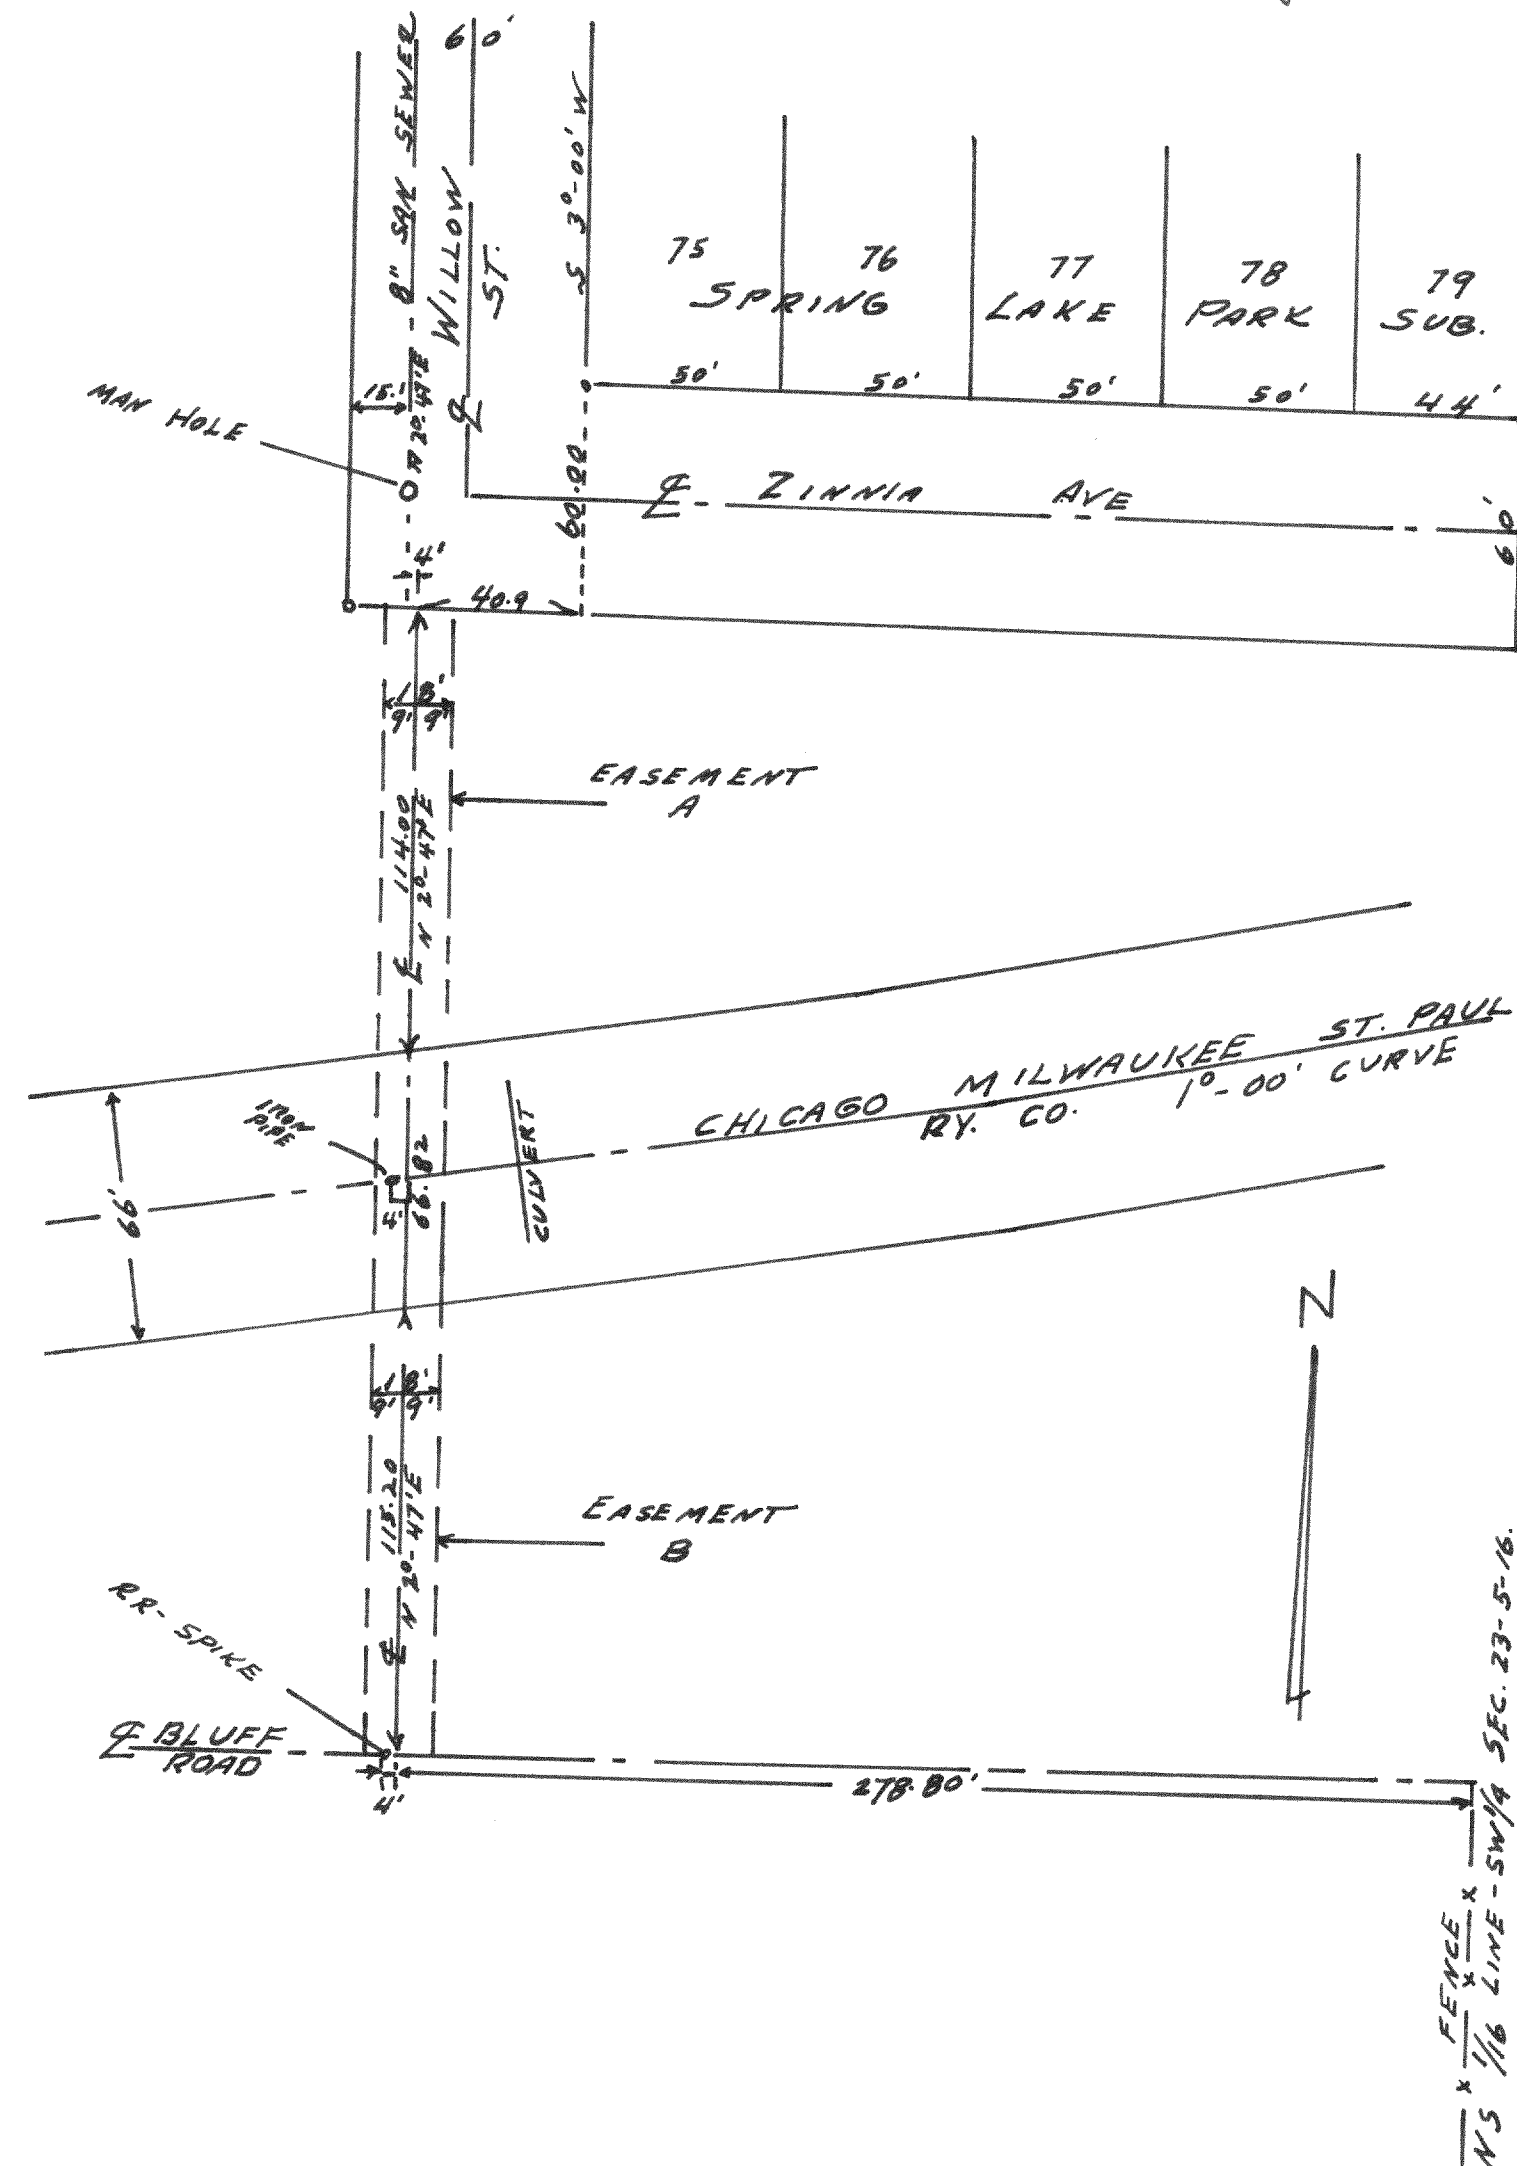

OCT. 2, 1967

Lloyd L. Jensen
COUNTY SURVEYOR

4912

