


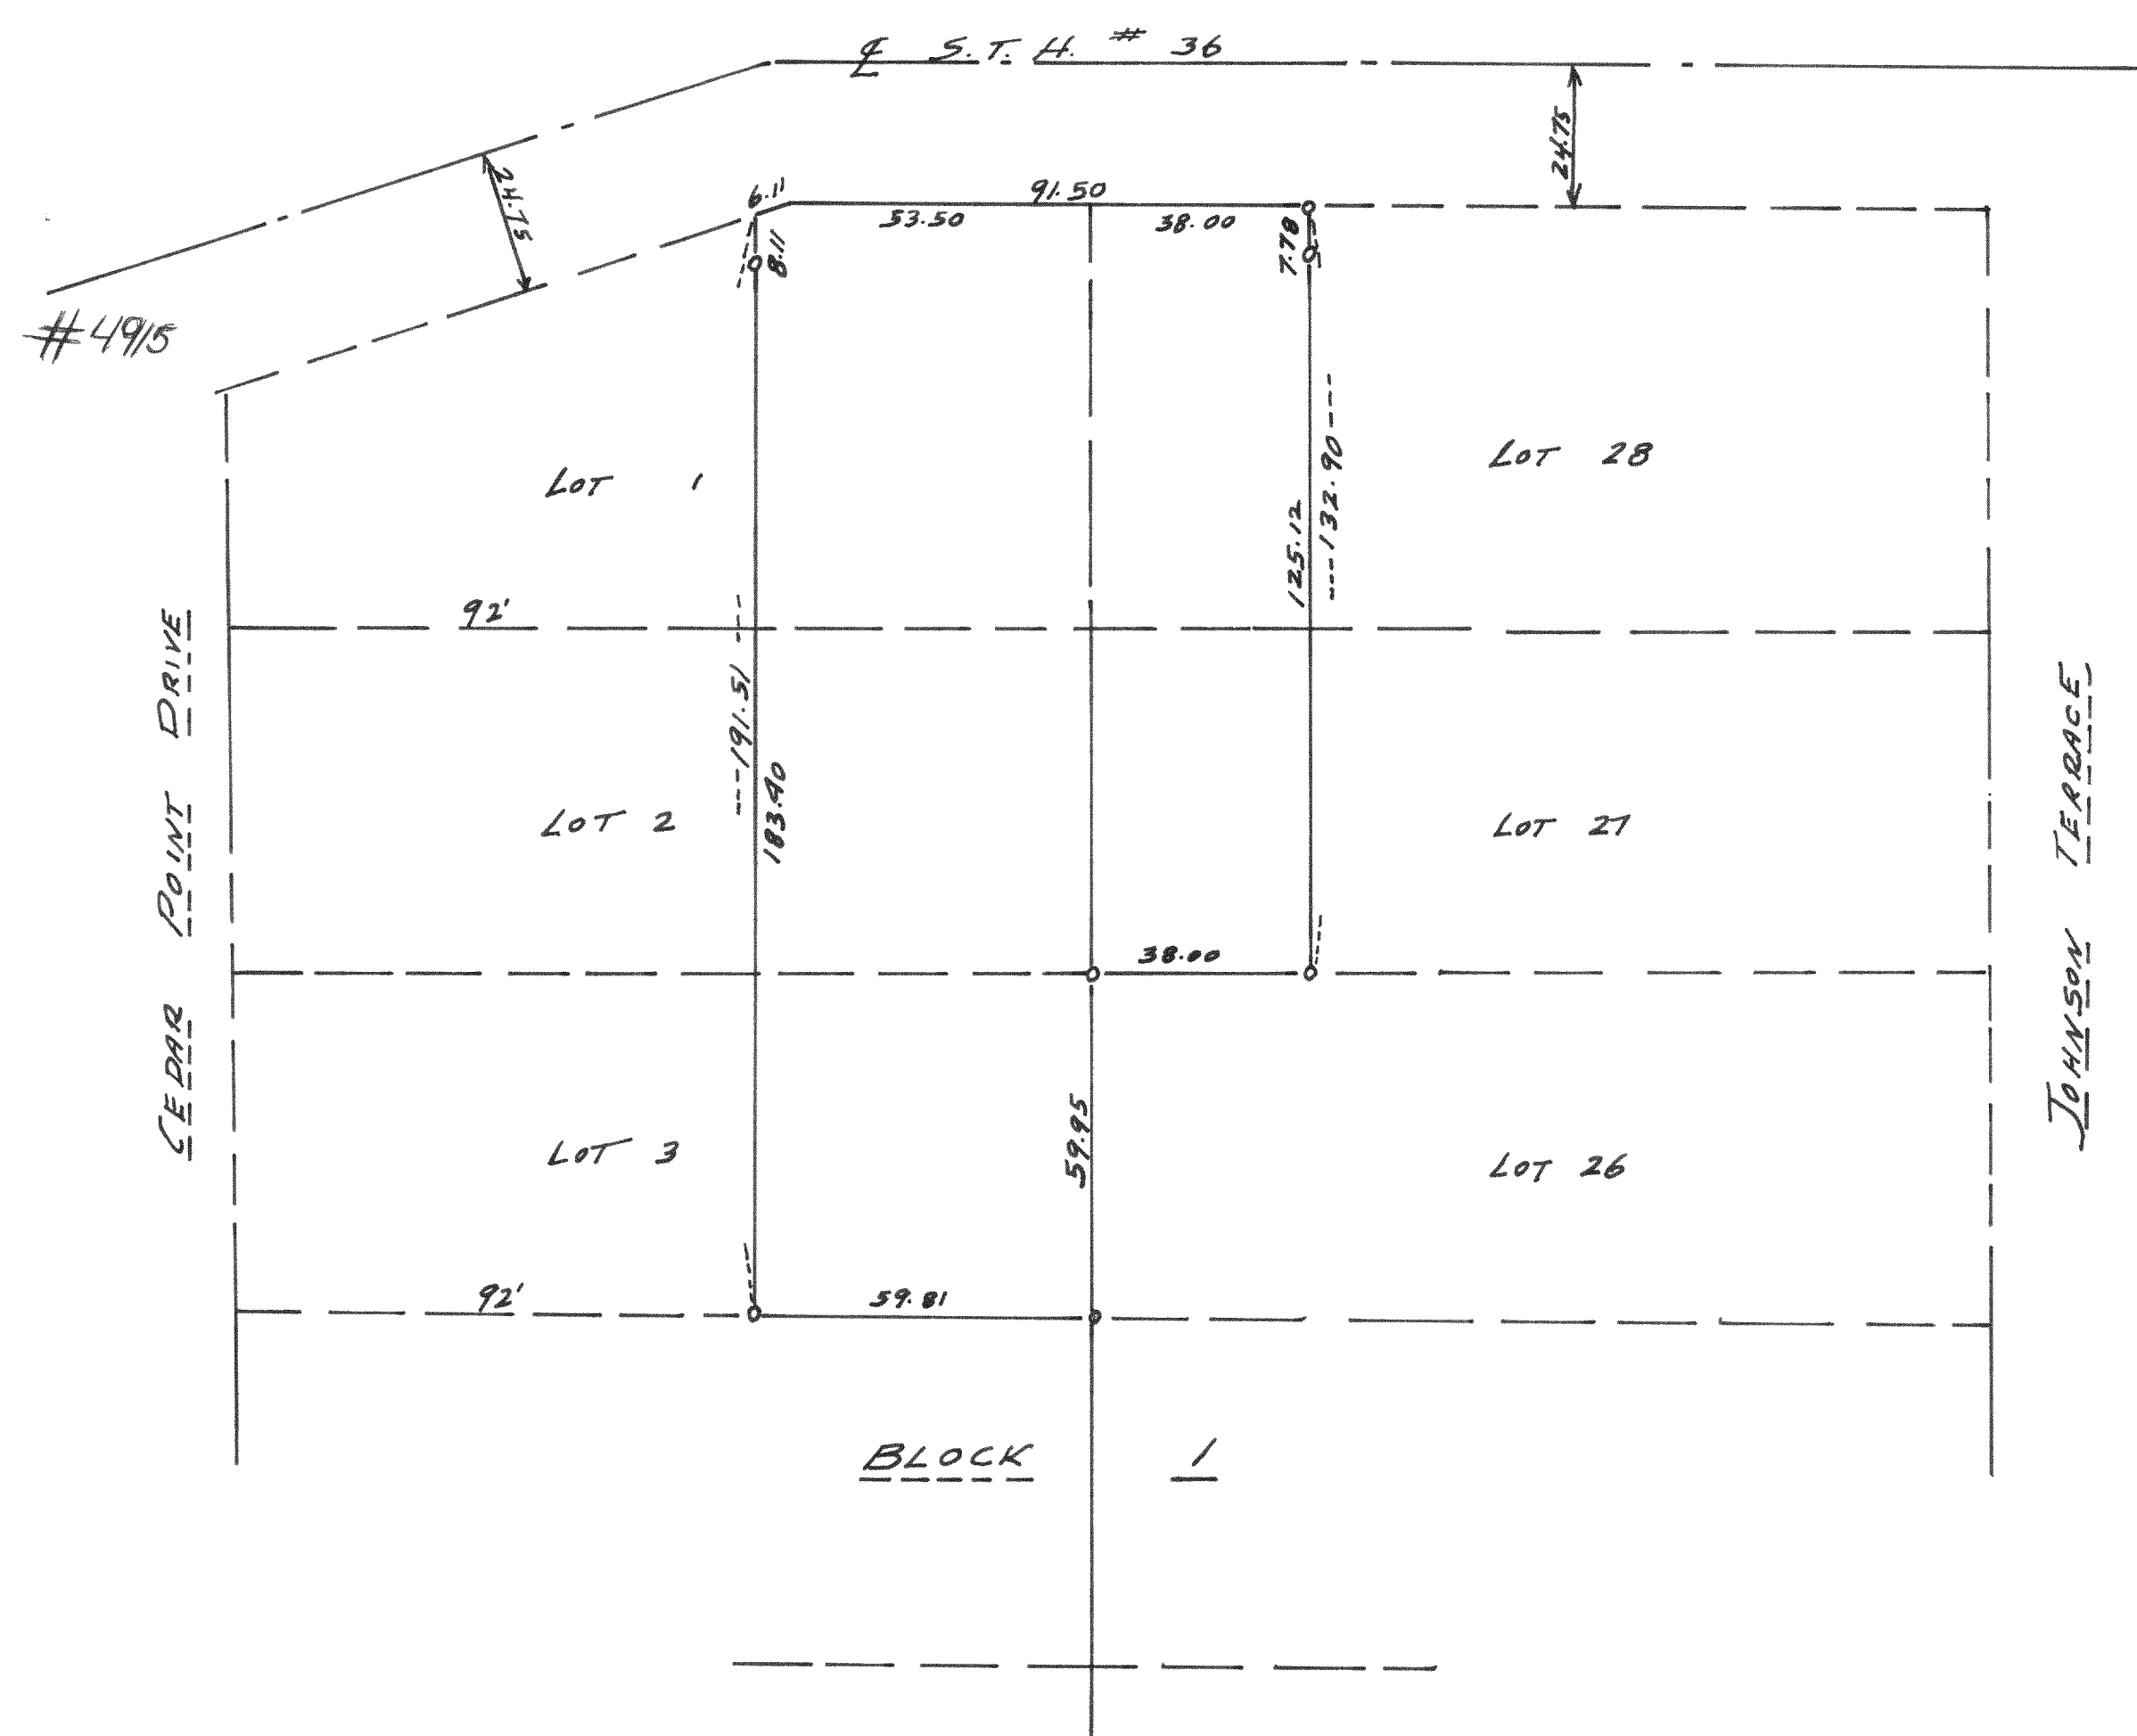

LOTS 1-2-3 EXCEPT THE WEST 92'  
AND THE WEST 38' LOTS 27-28  
BLOCK 1 - HARBOR VIEW SUBDIVISION  
WILLIAMS BAY, WISCONSIN.  
AUG. 1967 Clayton L. Jensen

Lloyd L Jensen  
COUNTY SURVEYOR