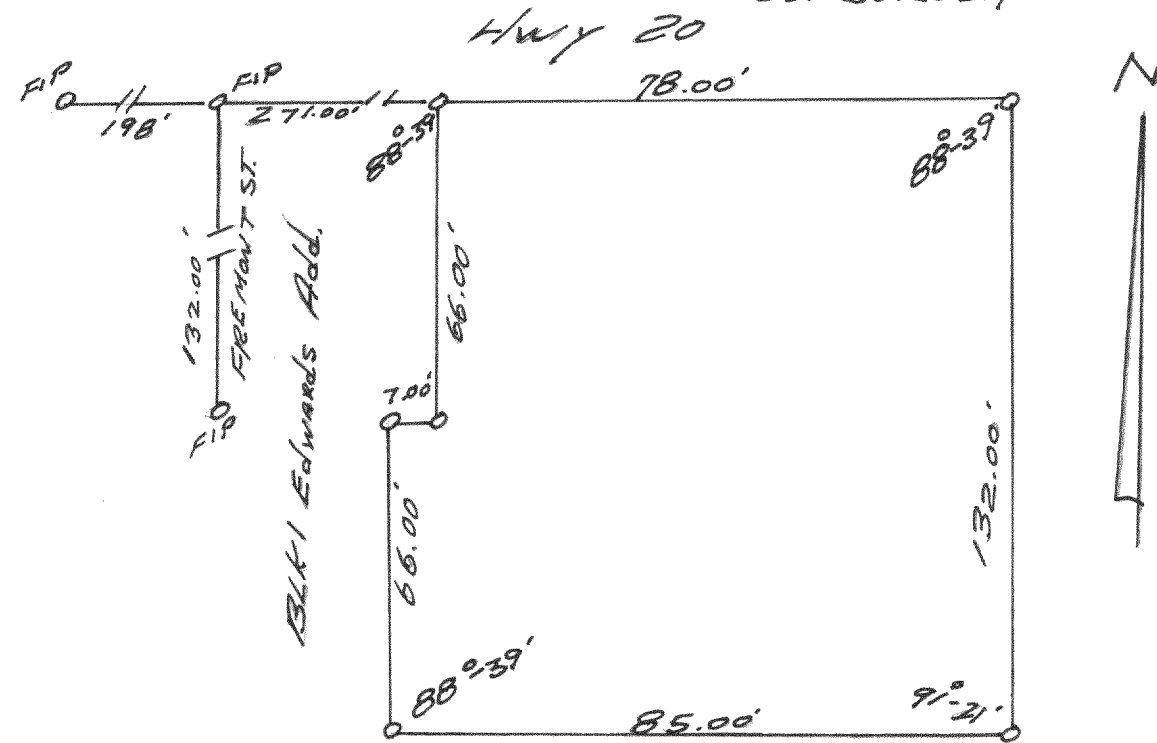


SURVEY OF A PARCEL
IN THE SW $\frac{1}{4}$ SEC. 20
T4N R18E EAST TROY, WIS.
OCT 1966 PL 1 PL 1

Lloyd L. Jensen
LLOYD L. JENSEN
CO. SURVEYOR

#4933

[illegible]


PLAT OF SURVEY OF LOT IN SW $\frac{1}{4}$
SEC. 20, T4N R18E, EAST TROY, WIS.
JUNE 5, 1967

Lloyd Jensen
Lloyd Jensen
County Surveyor


SURVEY OF NORTH LINE LOT 9 BLK 35
DAVIS Add. ELKHORN, WISCONSIN.
April 1967 Land L 4

Lloyd L. Jensen
LLOYD L. JENSEN
COUNTY SURVEYOR

#4934

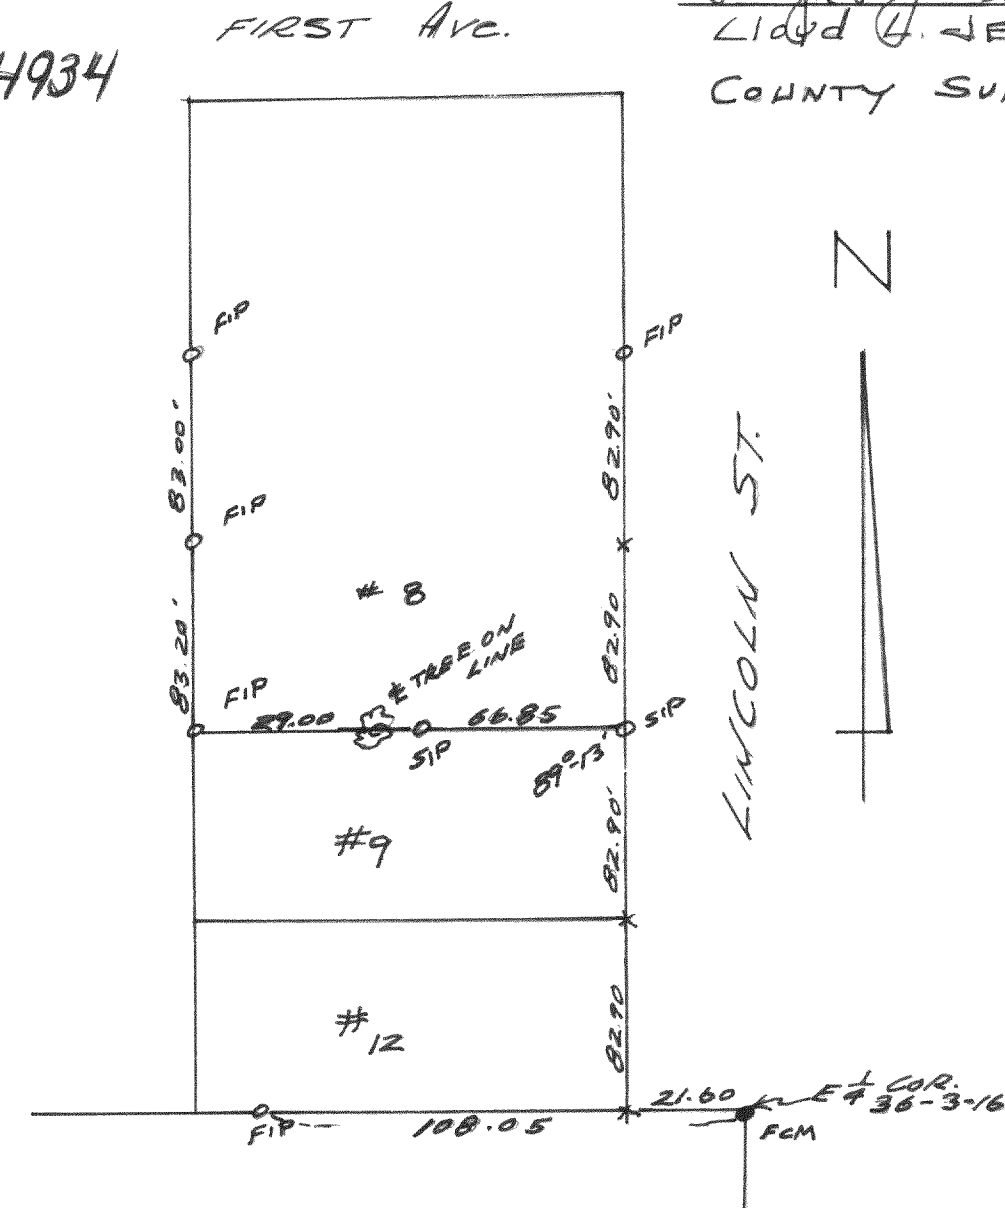

4936

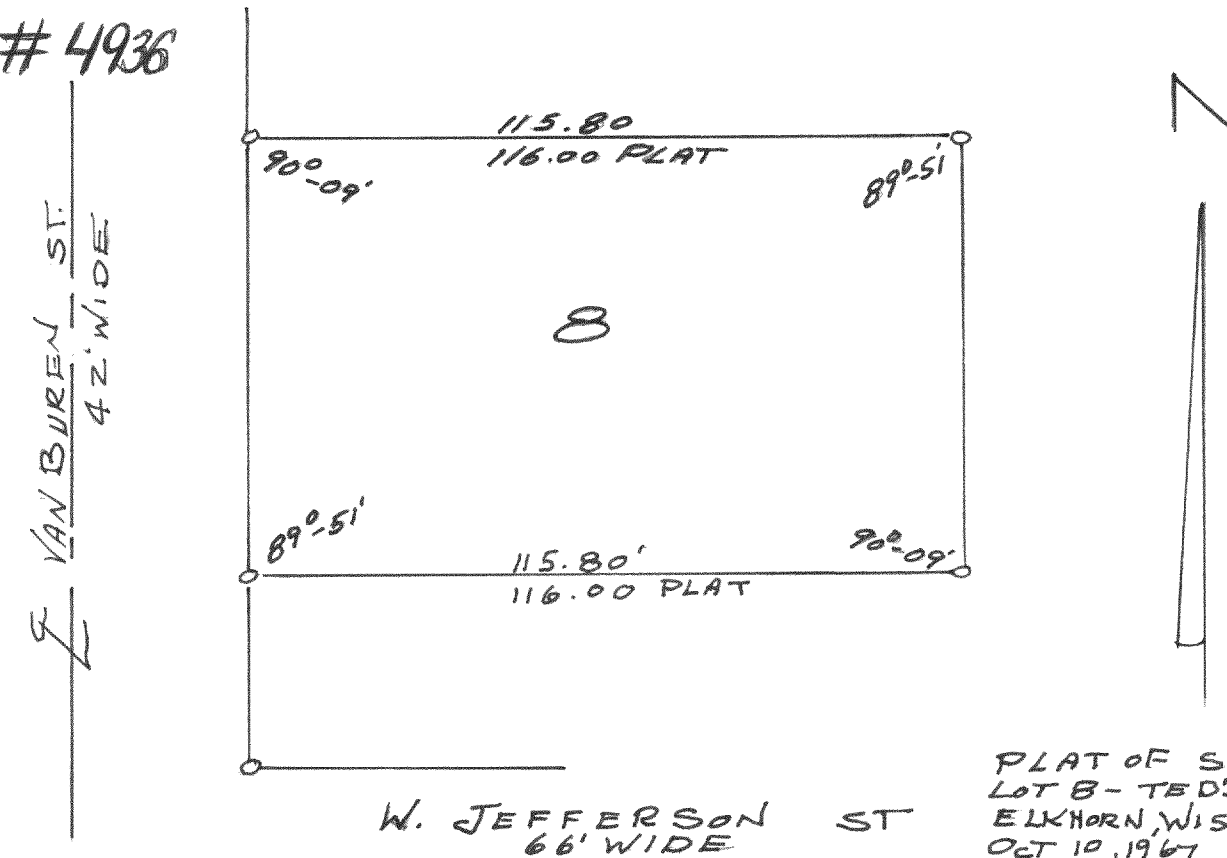

PLAT OF SURVEY OF
LOT B - TED'S ADD. CITY OF
ELKHORN, WIS.
OCT 10, 1967

Lloyd G. Jensen
Lloyd G. JENSEN
COUNTY SURVEYOR