


PLAT OF SURVEY OF  
LOTS 17, 18 AND PART OF LOTS 16 & 19  
CLEAR VIEW ESTATES, SECTION 33  
TAN RIBE WAL. CO. WIS.  
JAN. 1968

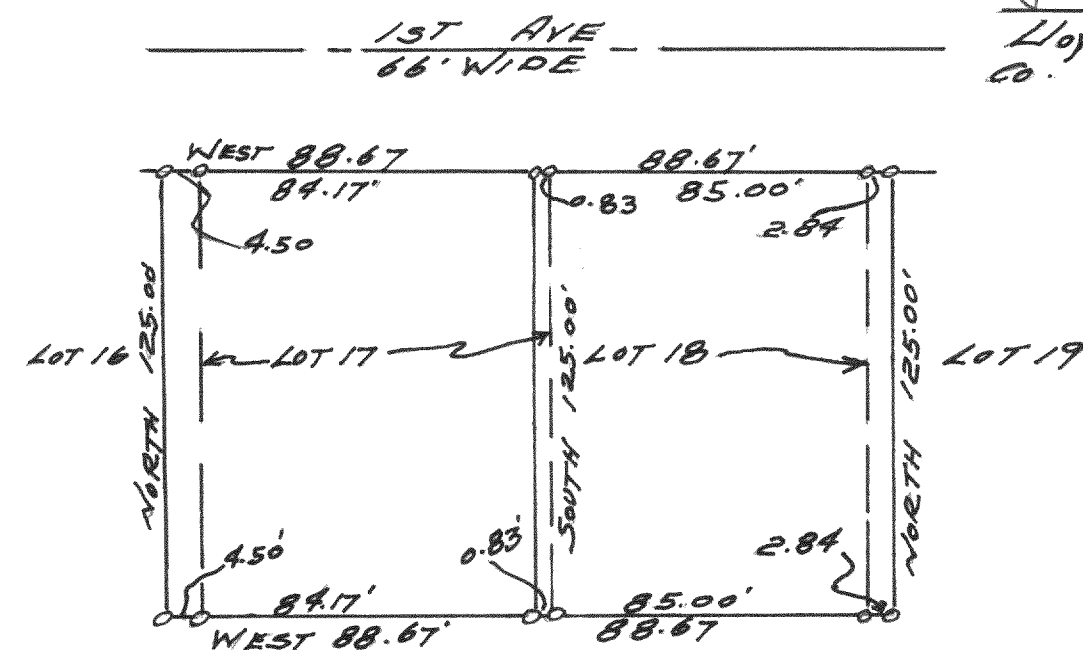


Lloyd L. Jensen  
LLOYD L. JENSEN  
CO. SURVEYOR

#4938



PLAT OF SURVEY OF LOTS 3 & 4 OF  
MILL SITE SUBD IN SEC 4, TAN RIBE  
JULY 1963

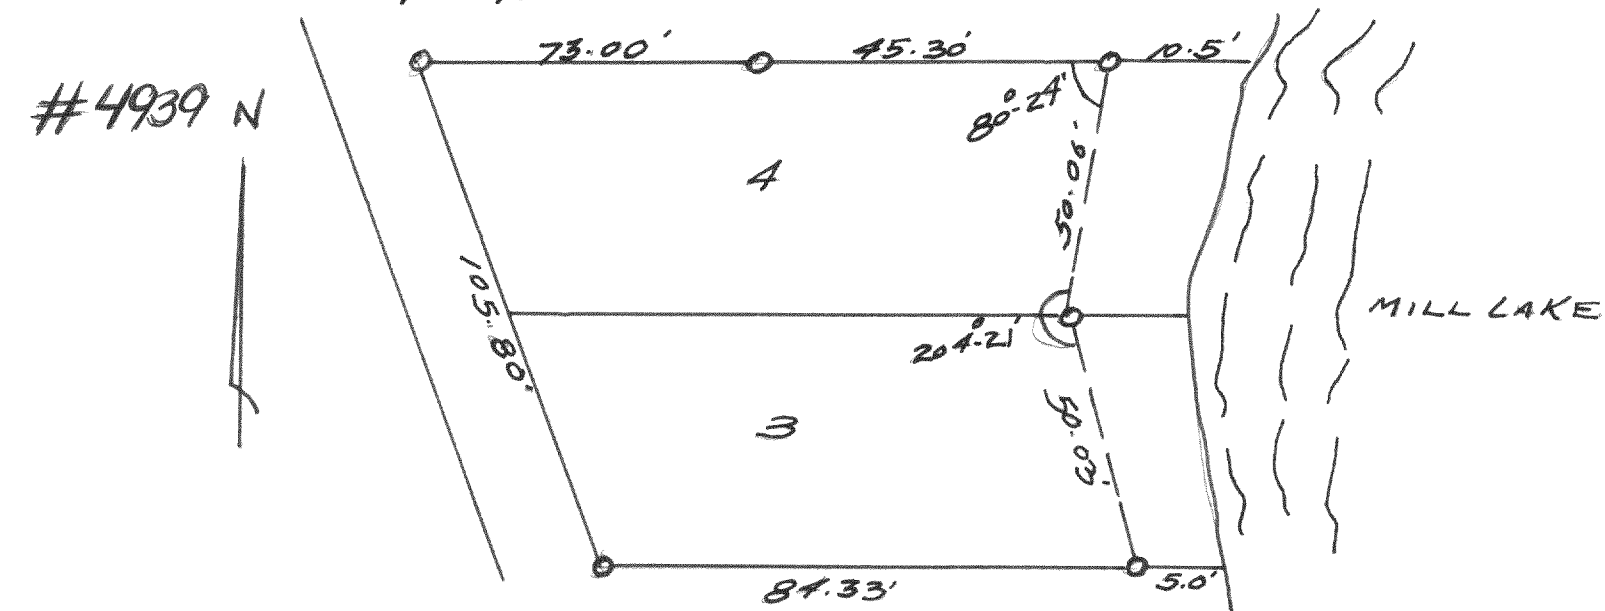

Lloyd L. Jensen  
LLOYD L. JENSEN  
COUNTY SURVEYOR

#4939 N




PLAT OF SURVEY OF  
LAND LOCATED IN THE  
NW 1/4 OF SECTION 2, TAN RIBE,  
WAL. CO. WIS.


AUG. 1967

Lloyd L. Jensen  
LLOYD L. JENSEN  
COUNTY SURVEYOR

#4940

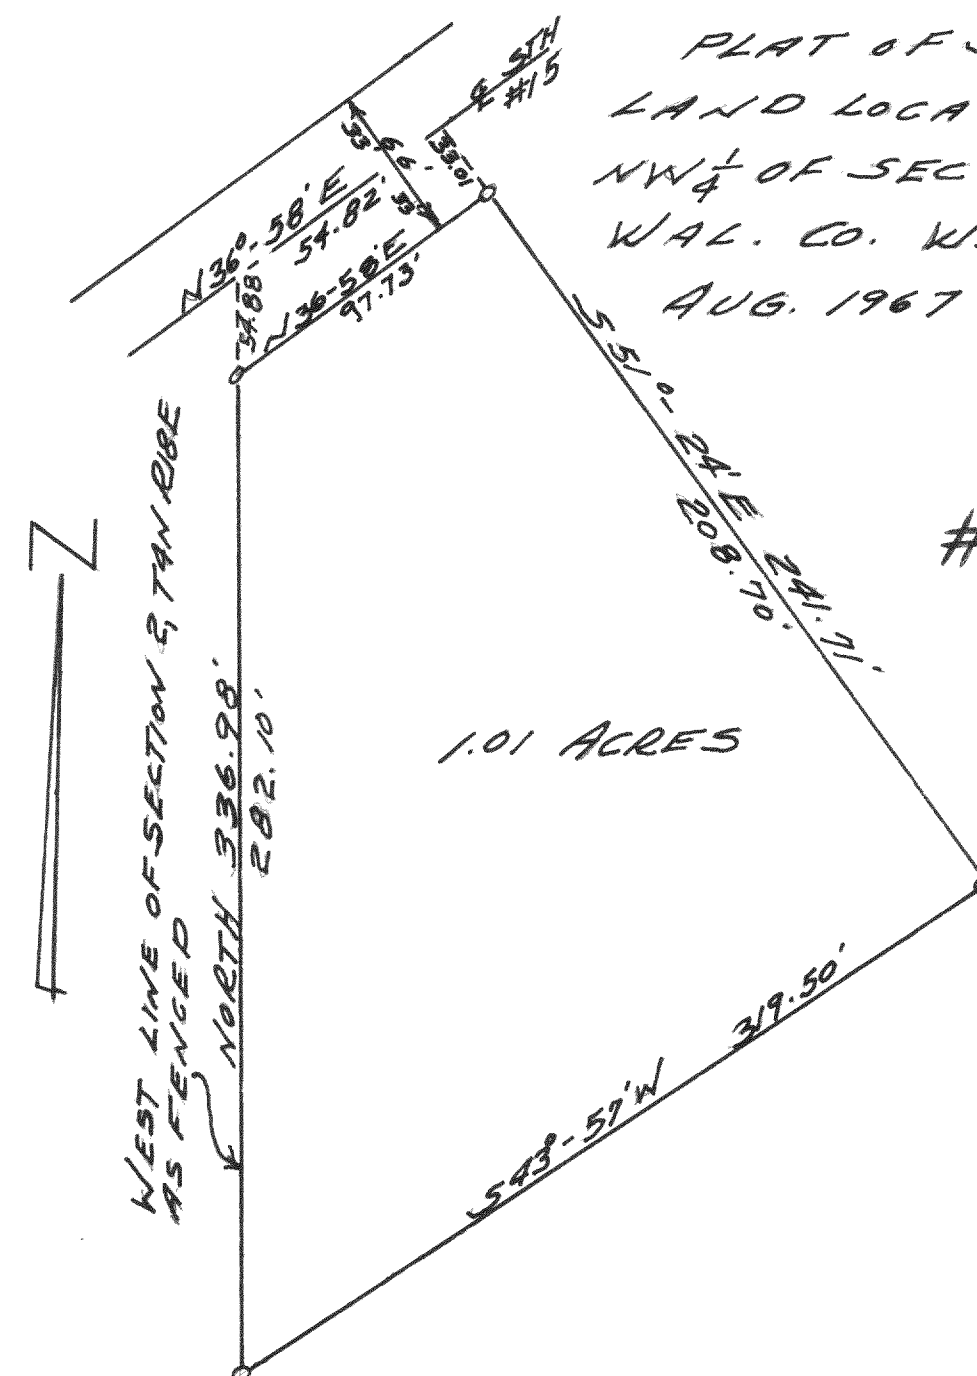

#4941

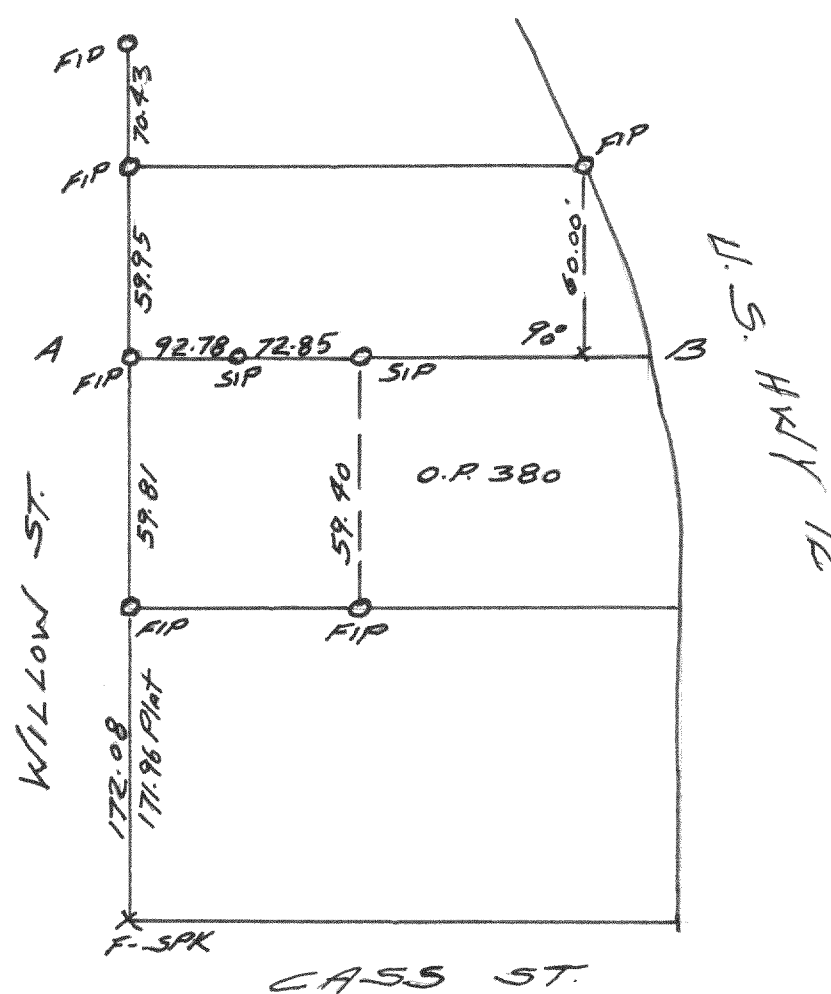

LINE AB - STRAIGHT LINE  
SURVEY OF NORTH LINE OF PART OF LOT 380  
ORIGINAL PLAT, CITY OF LAKE GENEVA, WIS  
OCTOBER 1966

Lloyd L. Jensen  
LLOYD L. JENSEN  
CO. SURVEYOR