
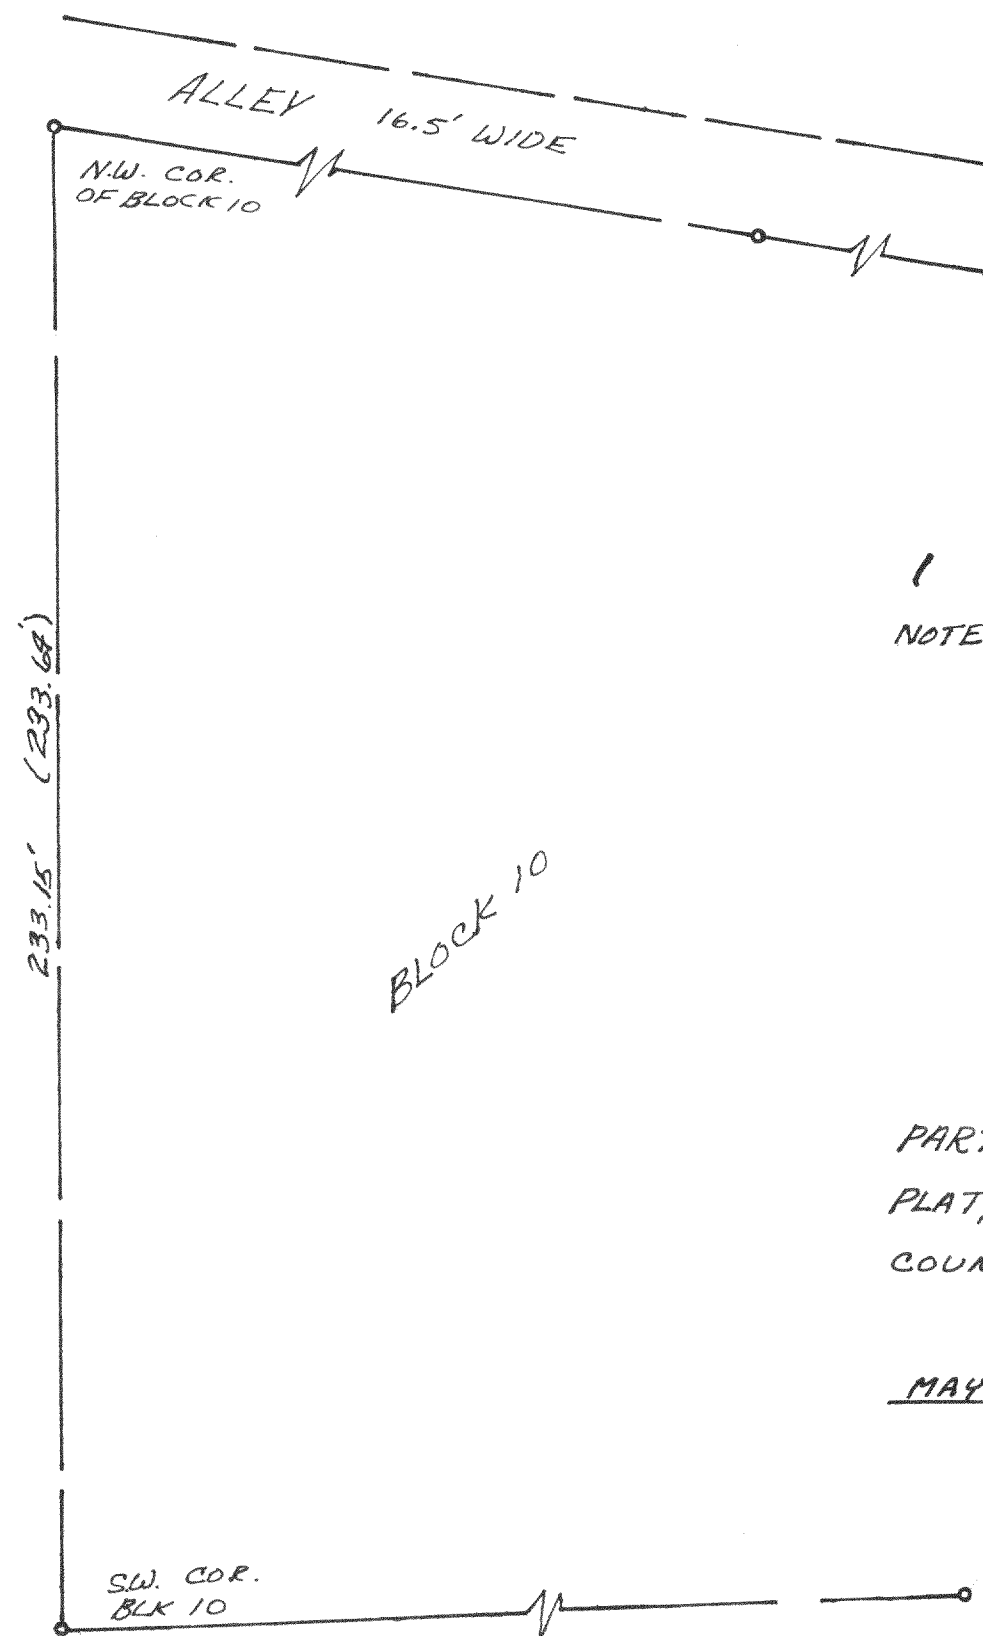


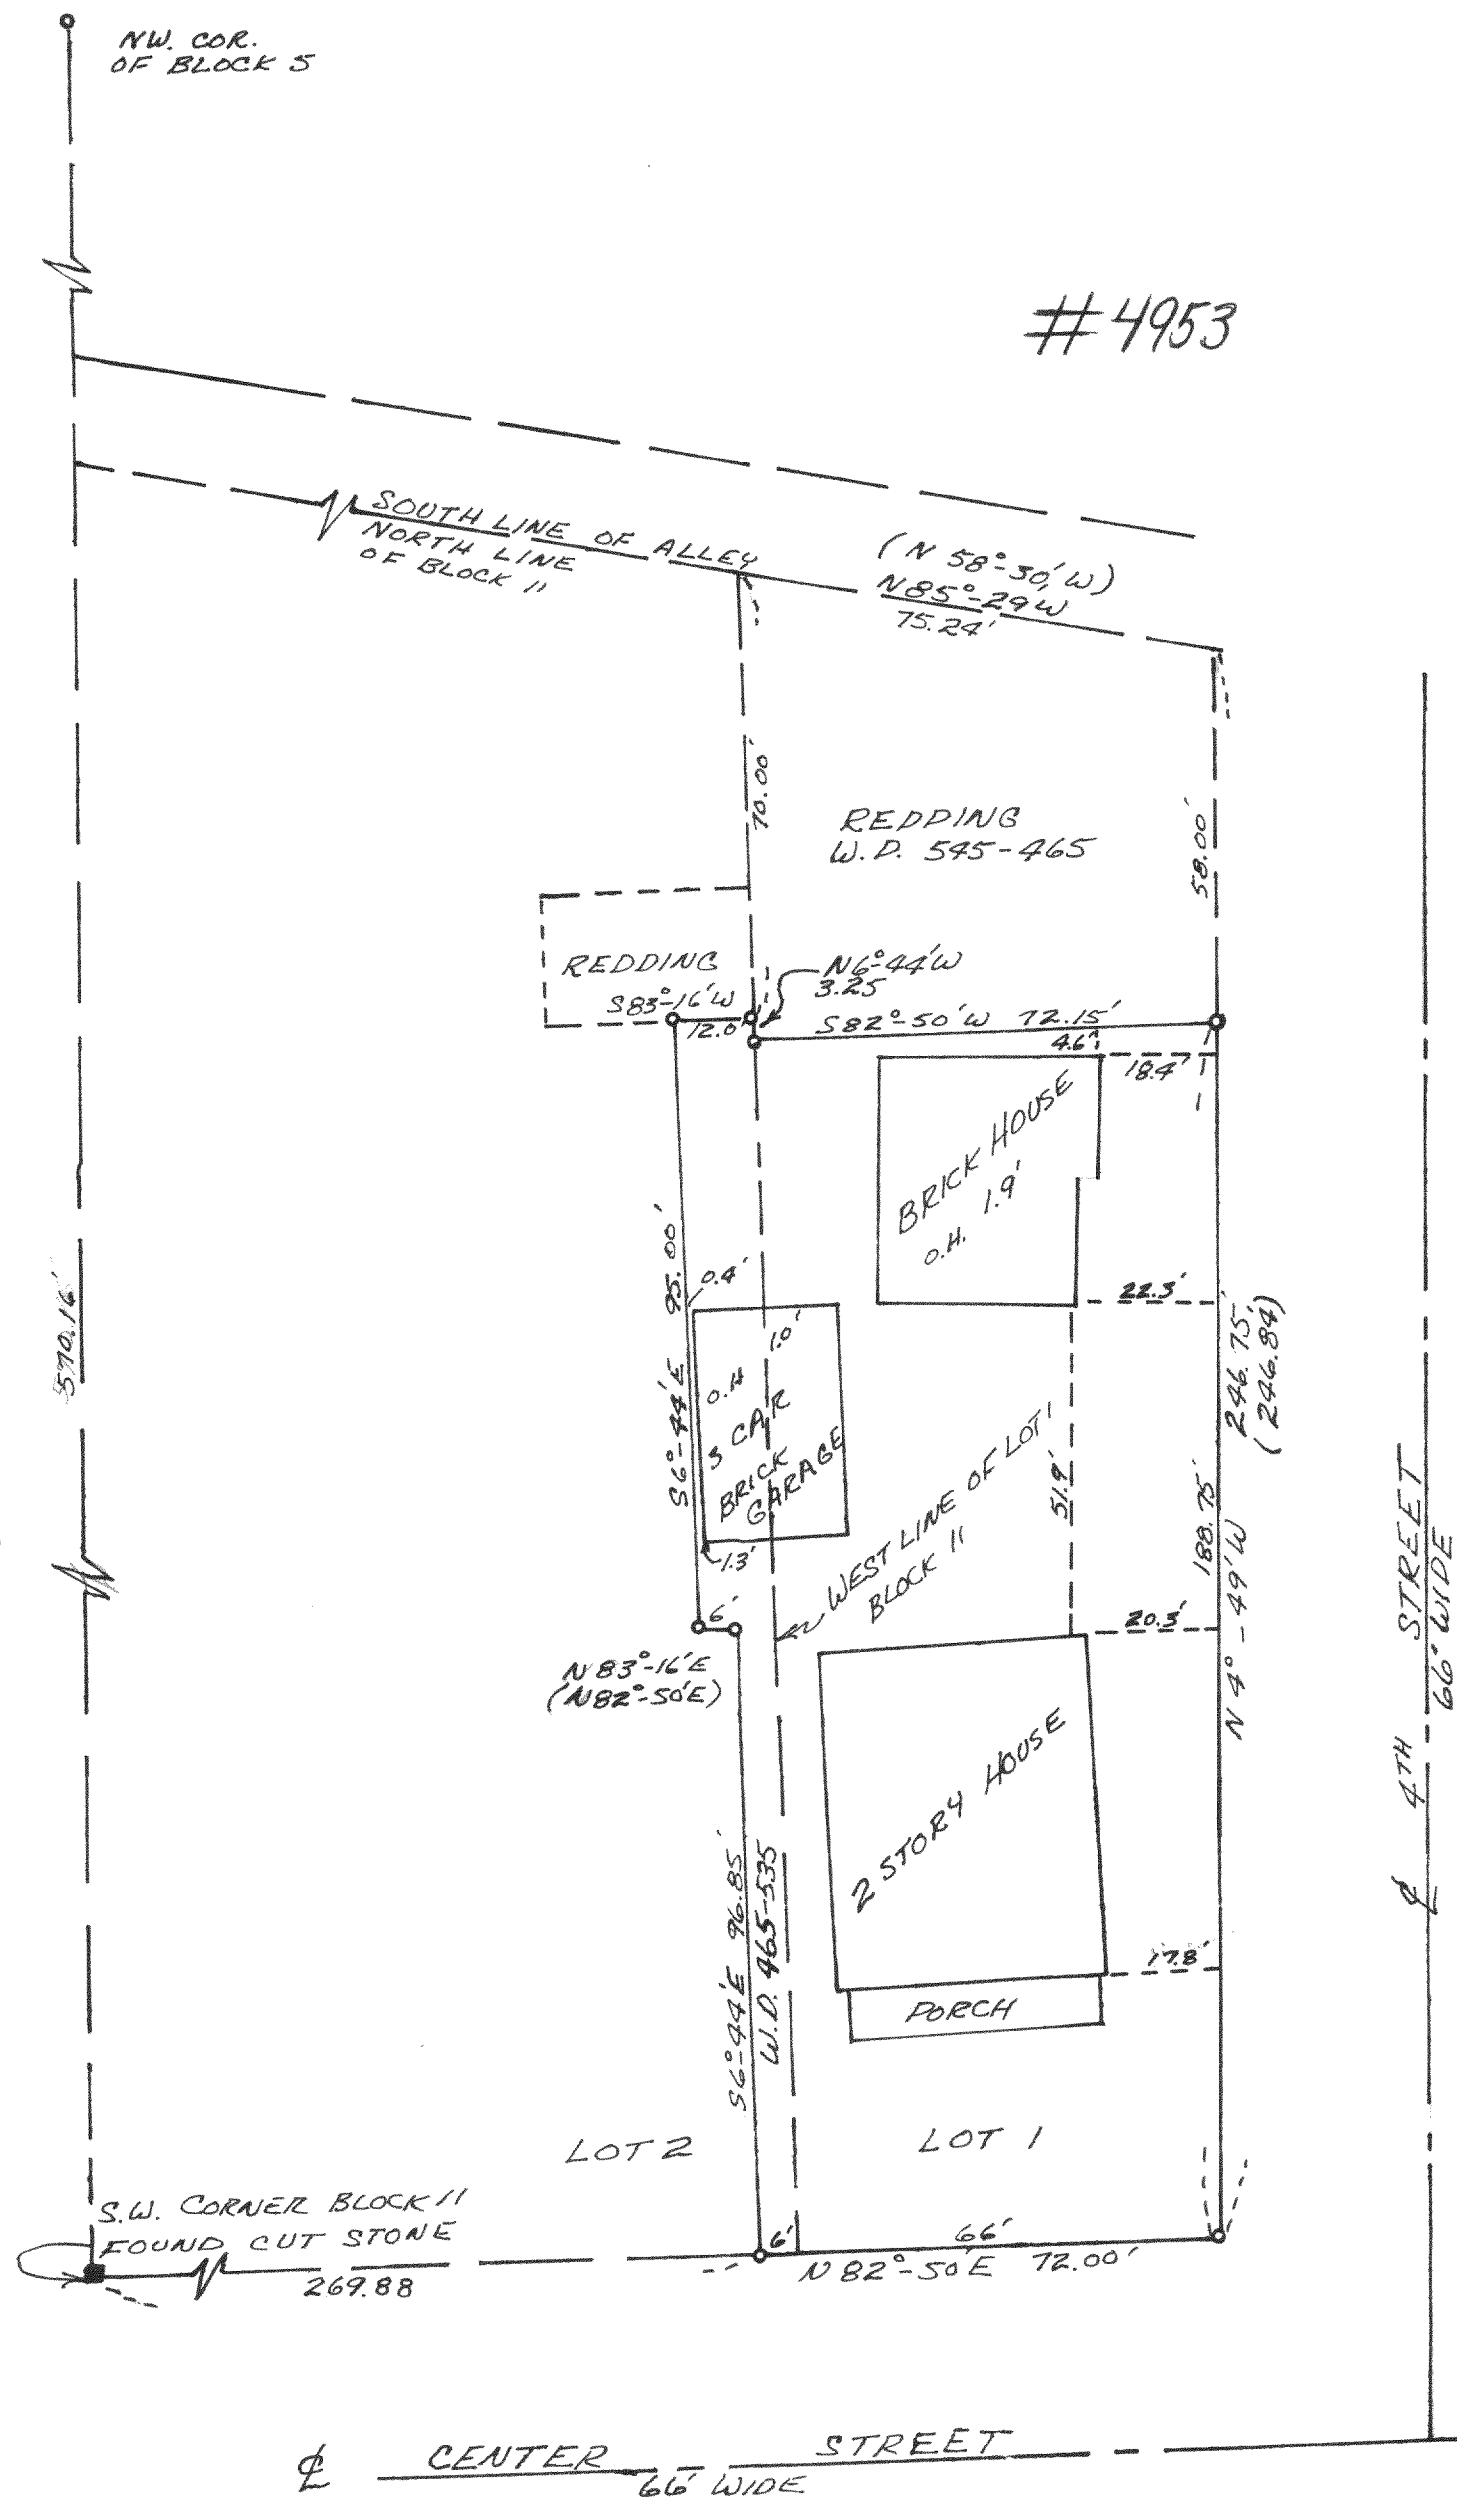

Ø - IRON PIPE FOUND
 ○ - IRON PIPE SET
 () - RECORDED AS
 NOTE - BEARINGS ARE BASED ON THE
 SOUTH LINE OF BLOCK 11, GIVEN
 AS N 82°-50' E

PLAT OF SURVEY
 OF
 PART OF LOTS 1 & 2 OF BLOCK 11, ORIGINAL
 PLAT, CITY OF WHITEWATER, WALWORTH
 COUNTY, WISCONSIN.

MAY 1970

Floyd S. Jensen
 SURVEYOR