



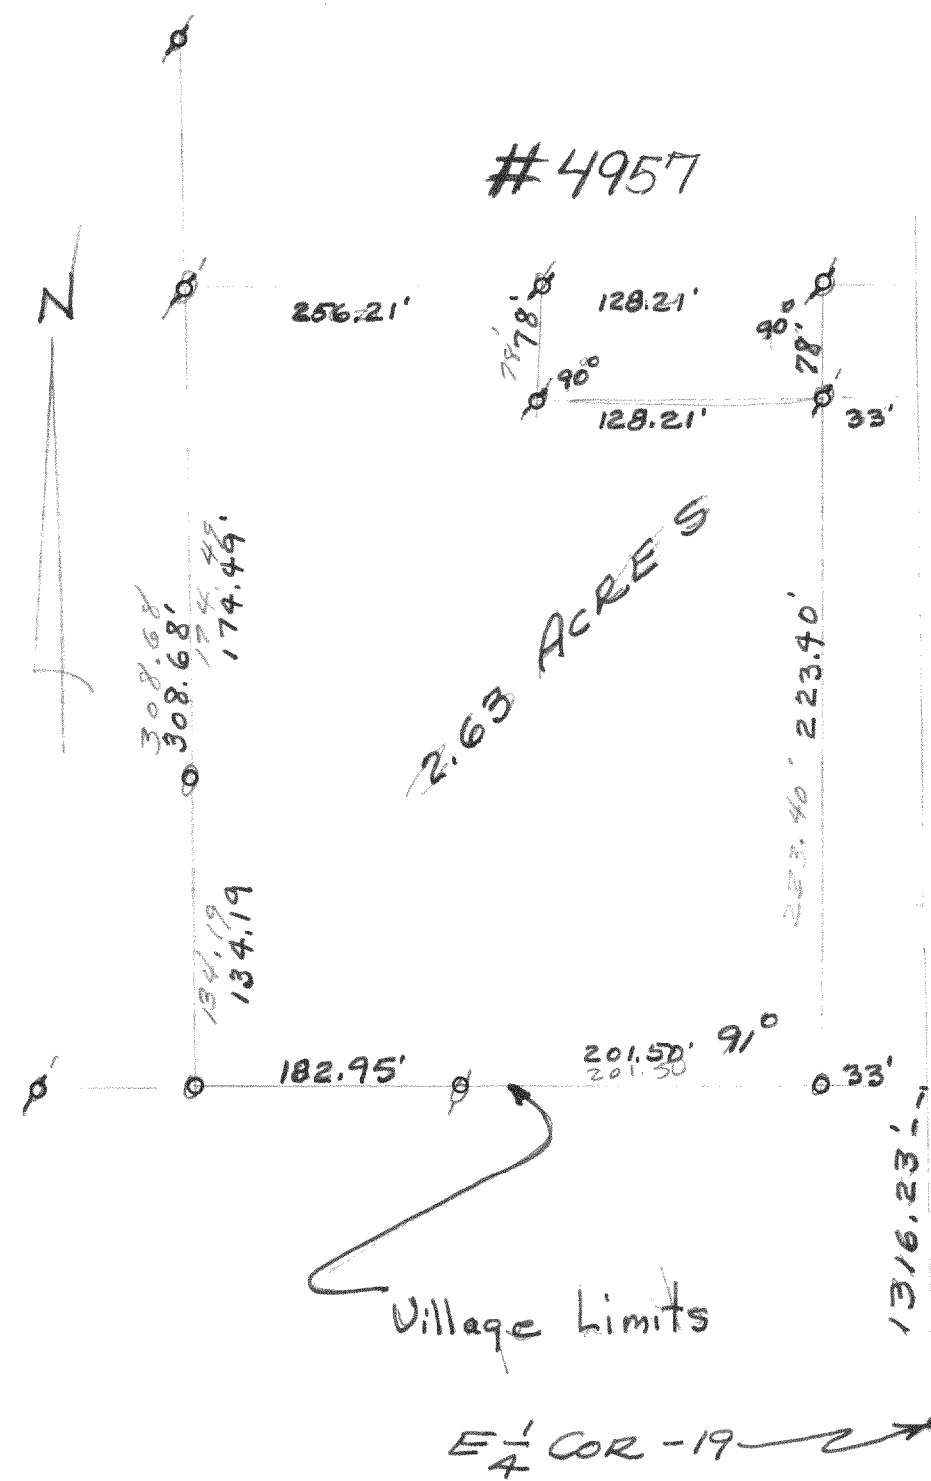


Plat of Survey of
A parcel of Land Located
in the NE 1/4 NE 1/4 Sec. 19, T4N R10E
July 31, 1968

Floyd L. Jensen
Co. Surveyor

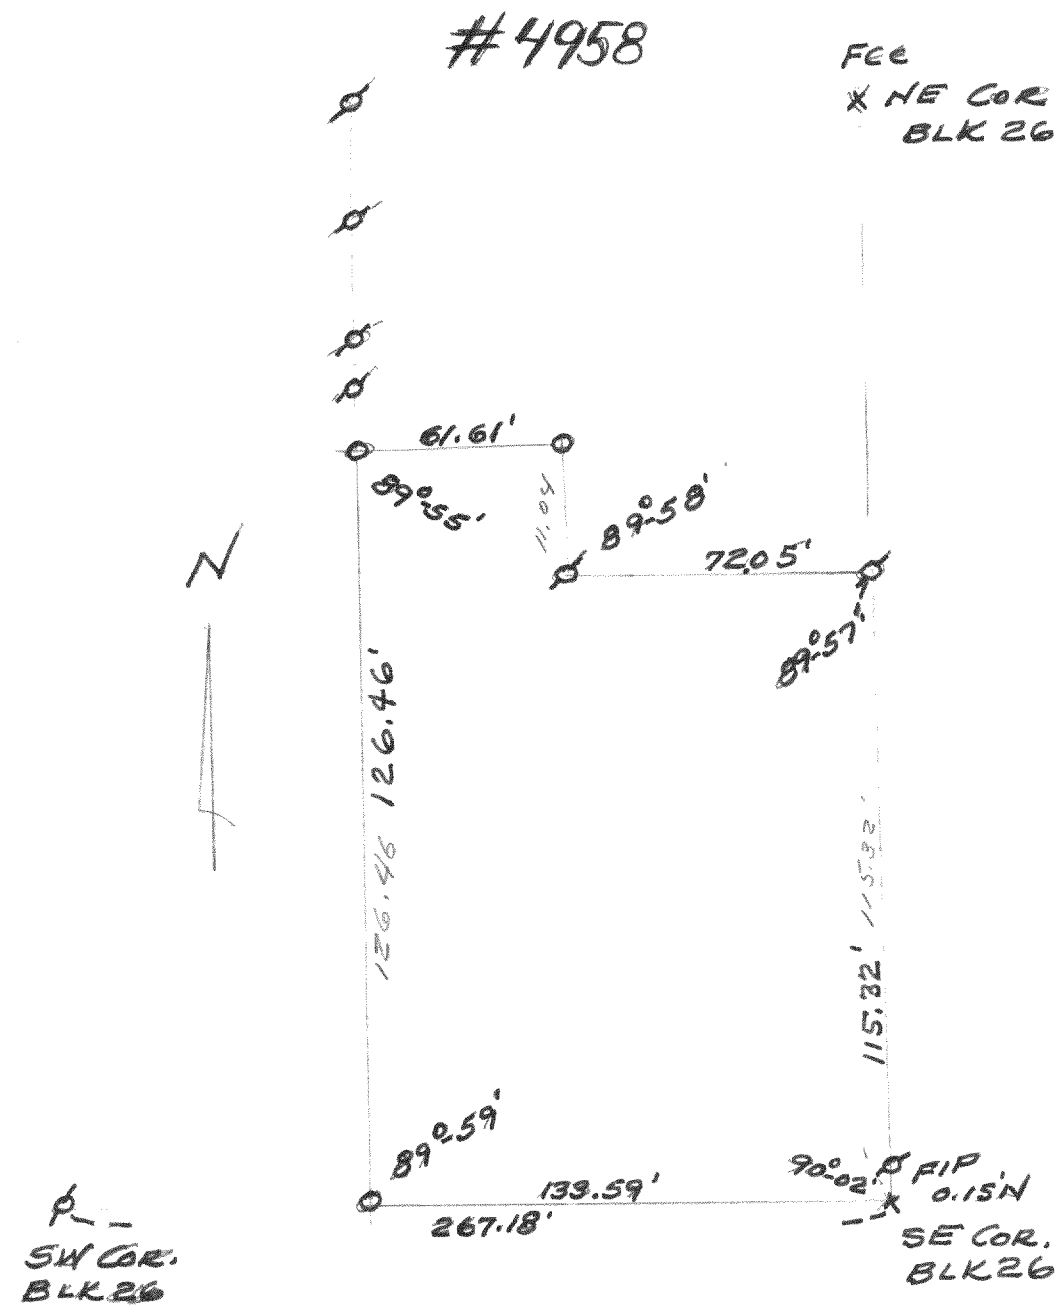

Survey of Lot 10 & Pt. Lot 9
BLK. 26 Orig. PLAT
CITY OF ELKHORN, WIS.
1969

Floyd L. Jensen
Co. Surveyor

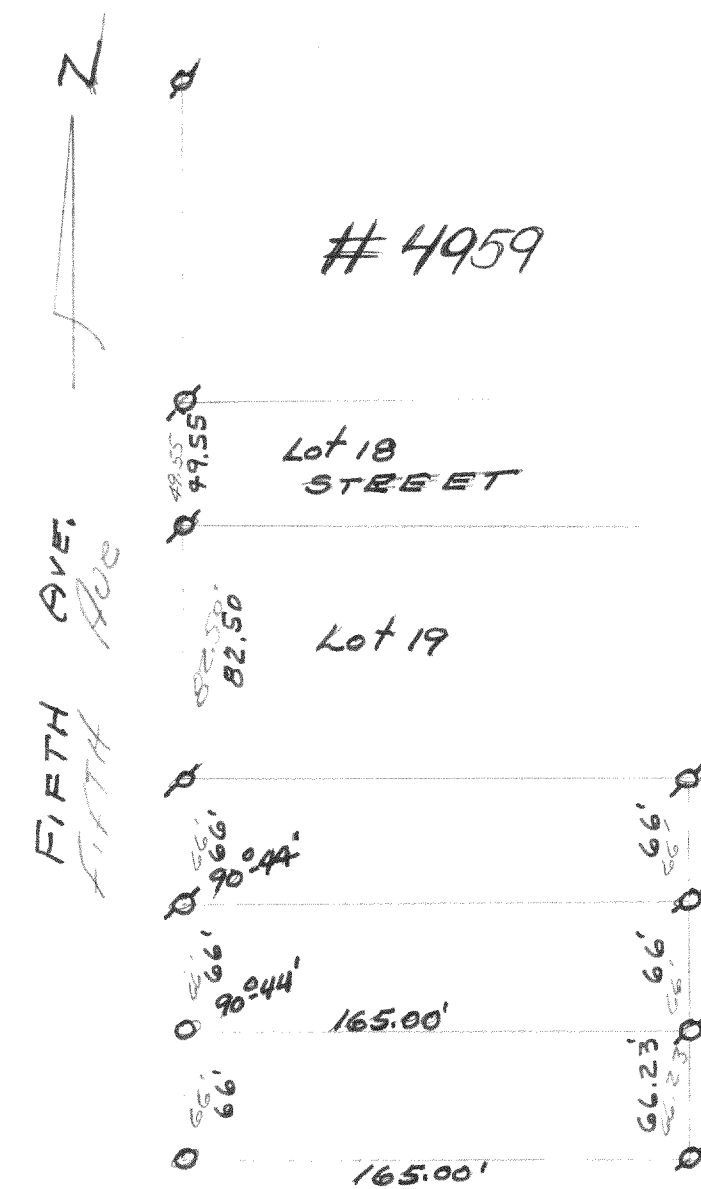

Survey of Lot 26 BLOCK I
E.W. Crumbs Add. to
the Village of Walworth.
Dec. 1969

Floyd L. Jensen
Co. Surveyor