


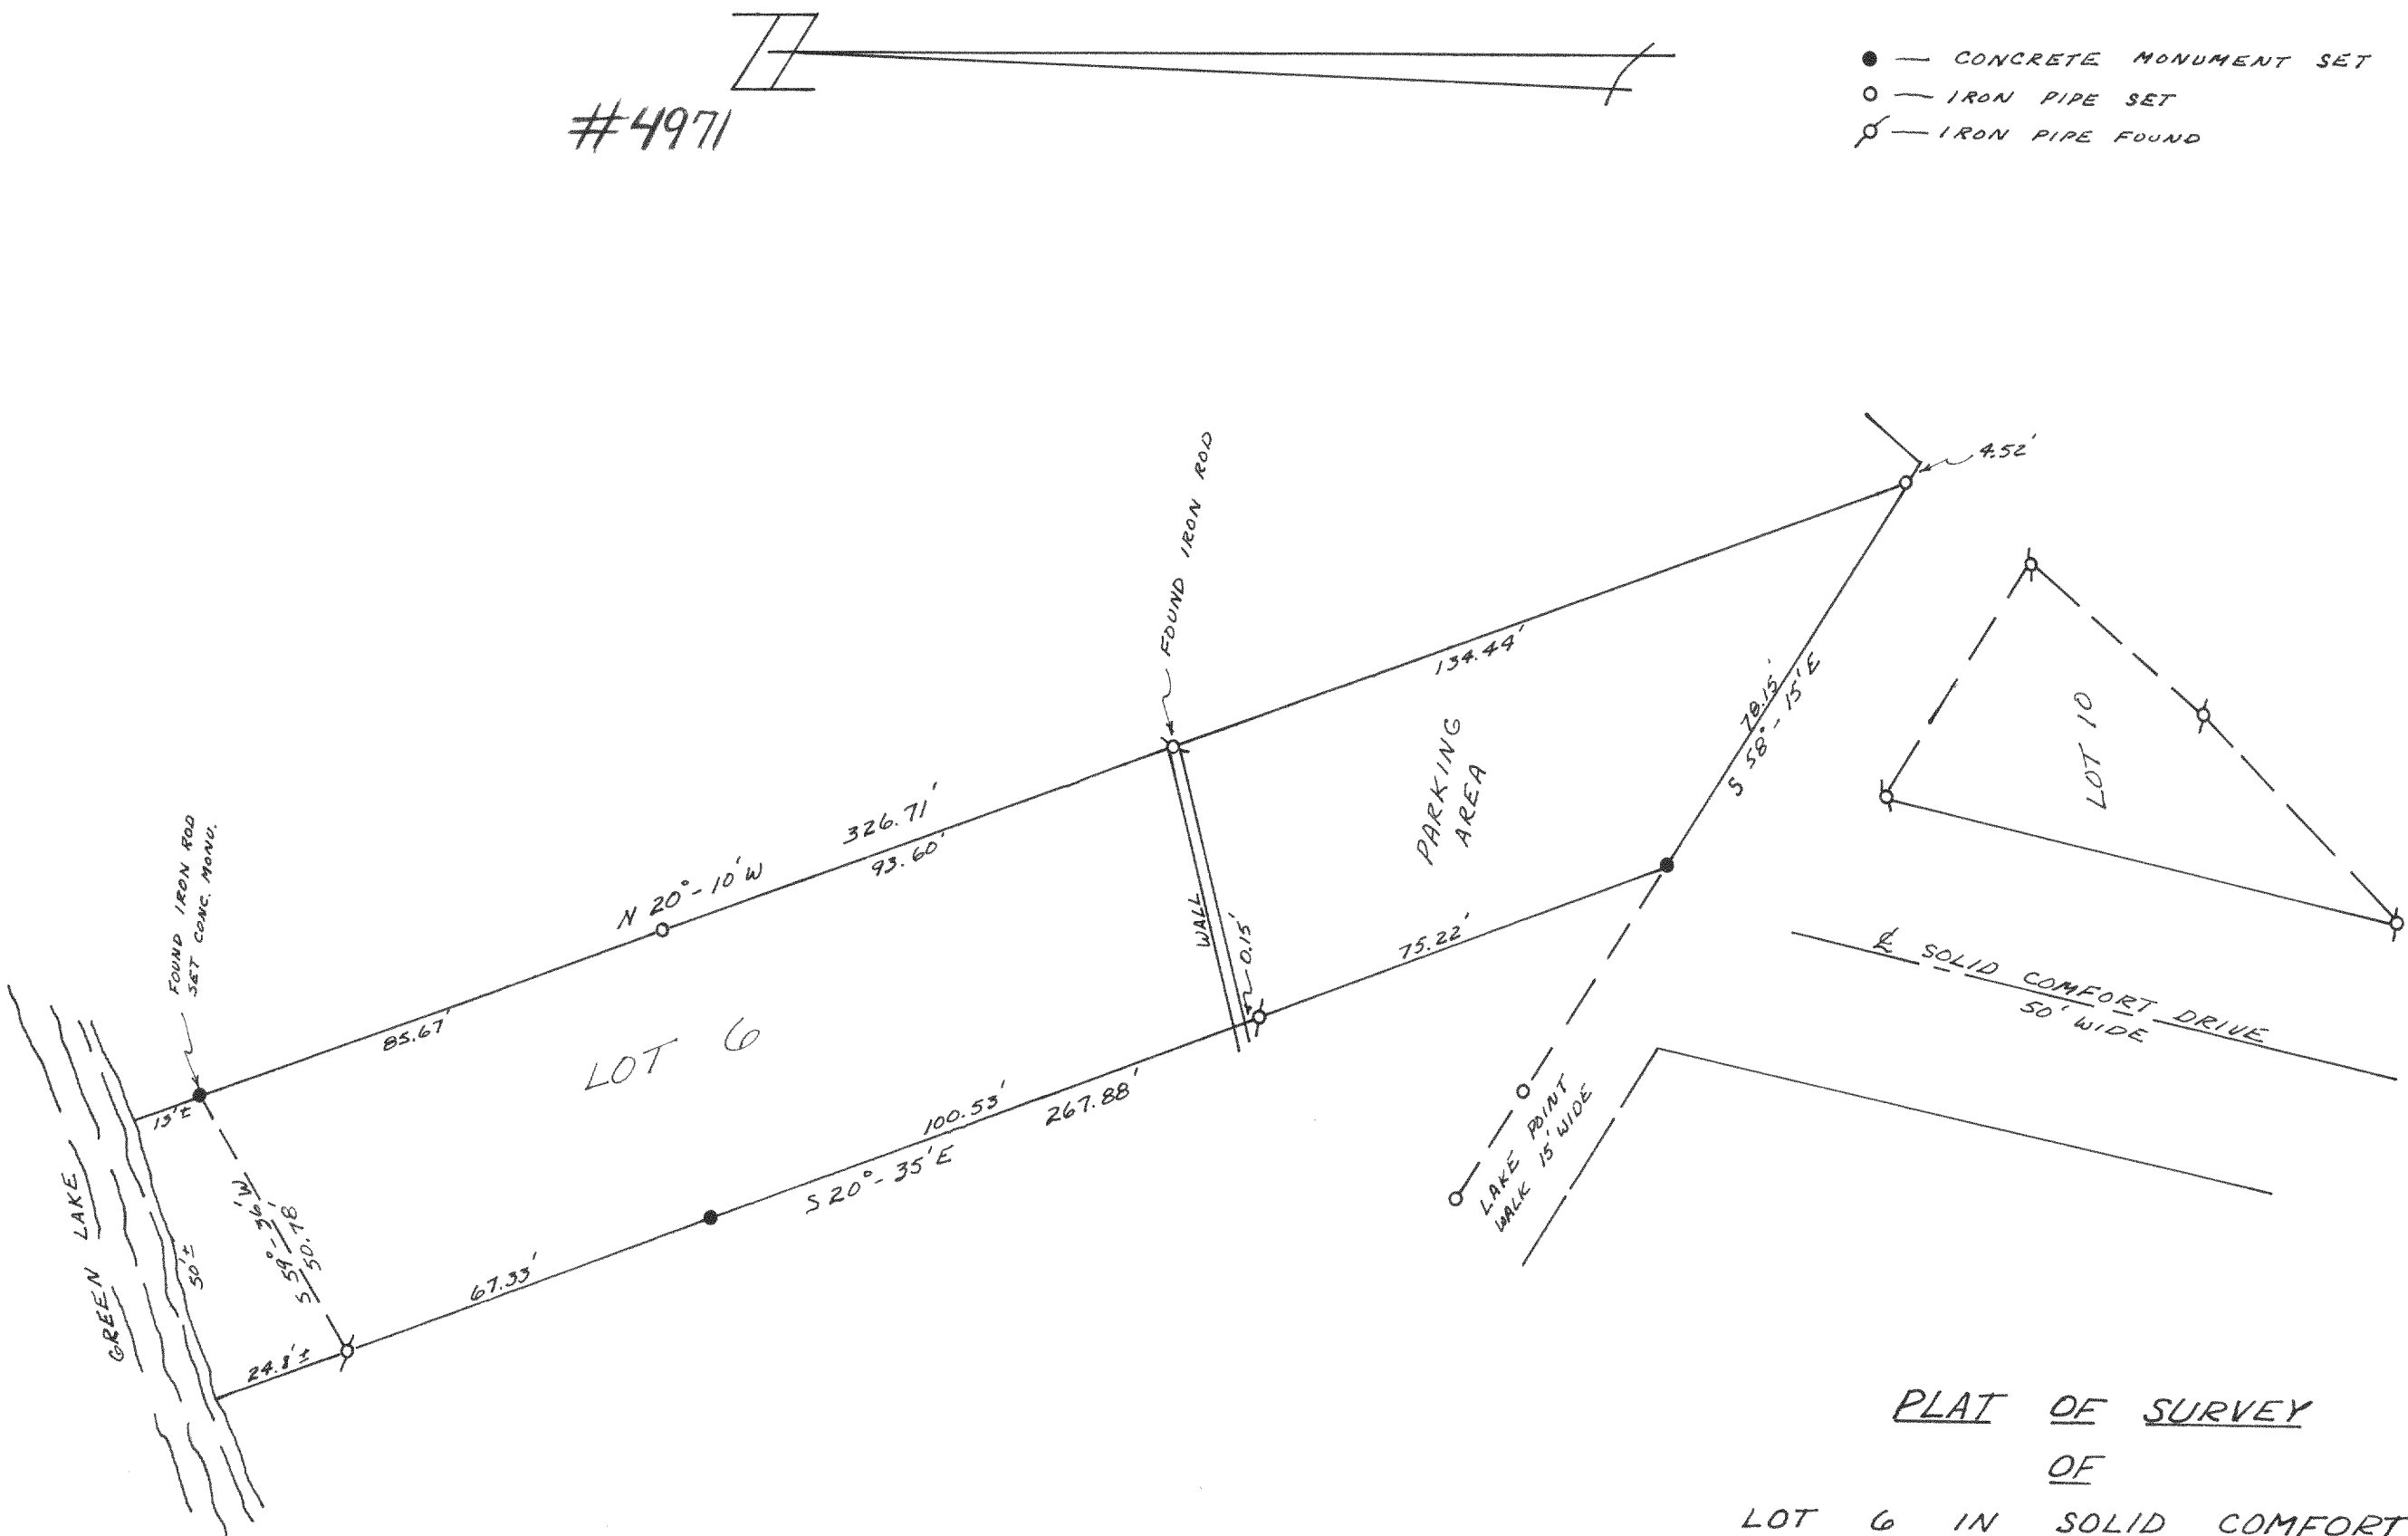

PLAT OF SURVEY
OF
LOT 6 IN SOLID COMFORT SUBDIVISION
LOCATED IN SECTION 25, T4N R16E,
WALWORTH COUNTY, WISCONSIN

MAY 1970

Lloyd R. Jensen
SURVEYOR