
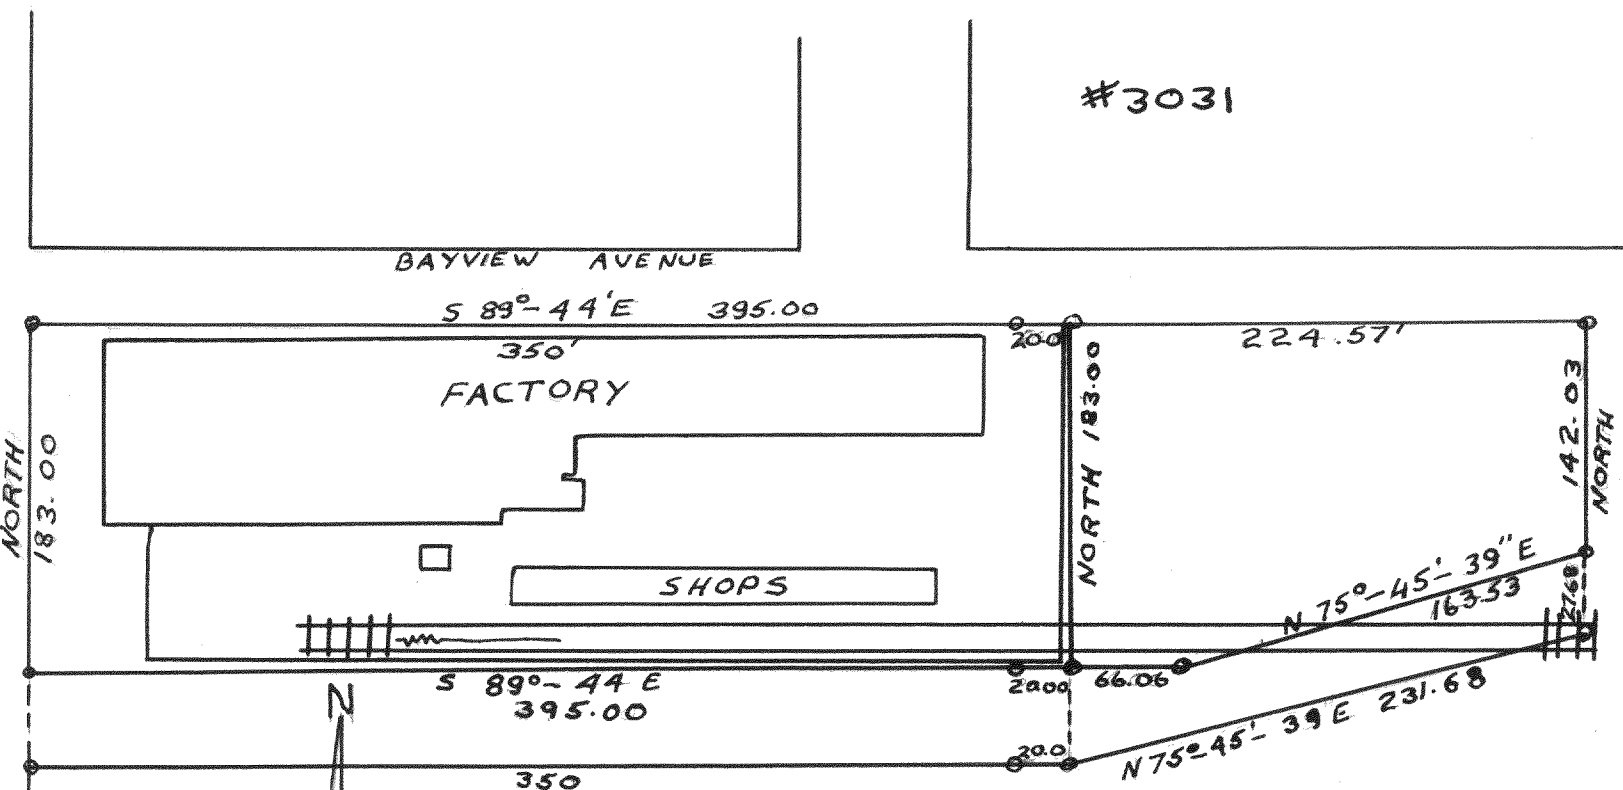


LOT 1 OF LAWNDALE SUBDIVISION AND A
25' FOOT STRIP EAST OF LAWNDALE
LOCATED IN THE SW $\frac{1}{4}$ OF SEC 5, TINRIZE
CITY OF WHITE WATER, WALWORTH CO
WISCONSIN

#3030

LLOYD L. JENSEN
COUNTY SURVEYOR
MARCH, 1955

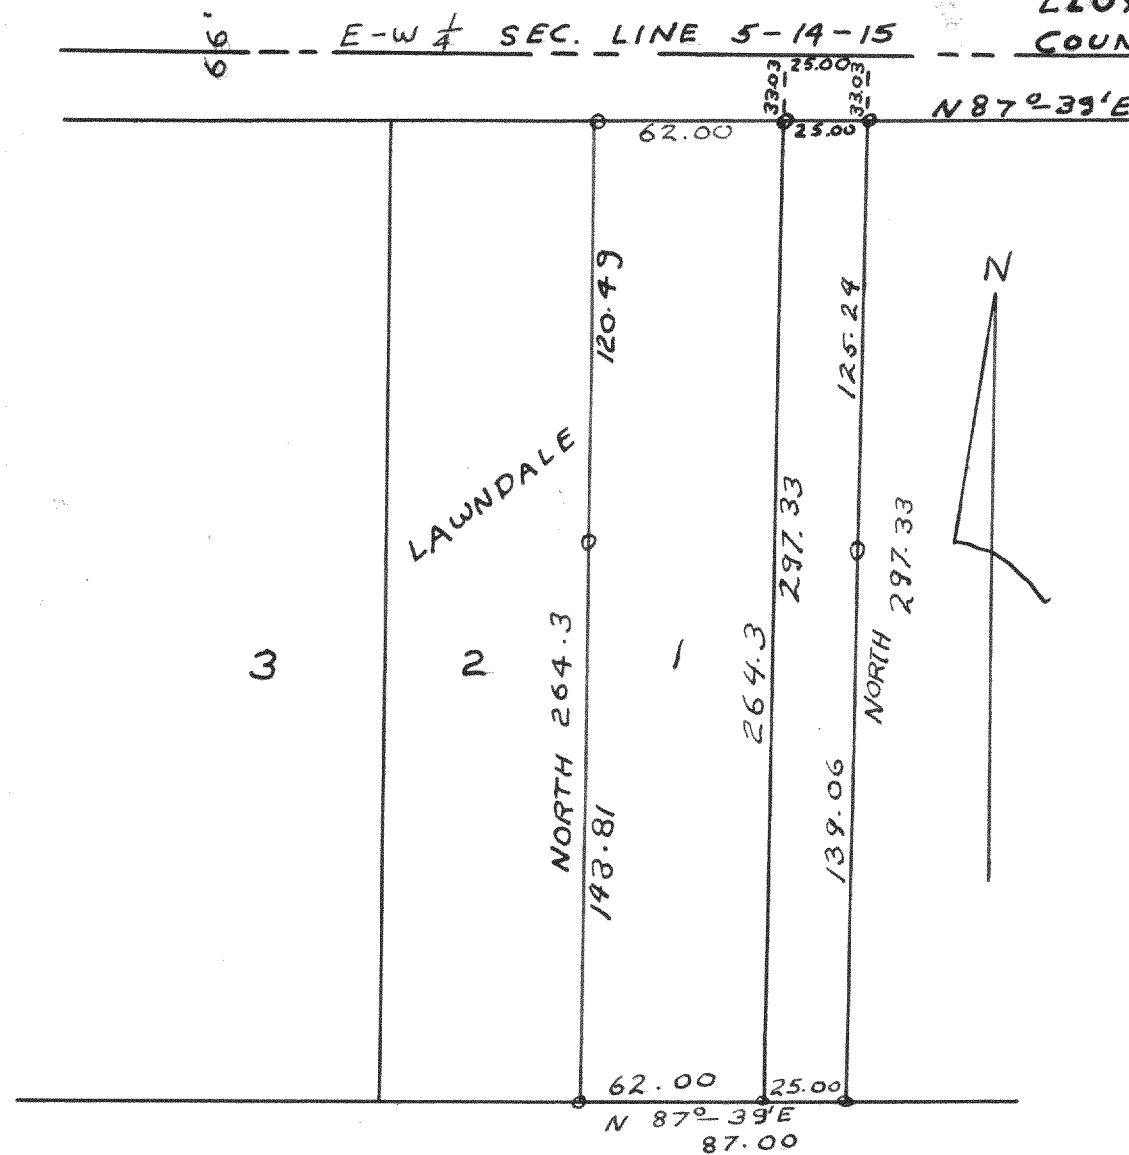

#3031

LAND LOCATED IN THE NW $\frac{1}{4}$ OF SECTION
6, TINRIZE, WALWORTH COUNTY, WISC.
JUNE, 1955 LLOYD L. JENSEN
COUNTY SURVEYOR

MIDDLE $\frac{1}{8}$ TH SEC. COR.
IN THE SE $\frac{1}{4}$ OF SEC. 1, TINRIZE
OF WALWORTH CO., WISC.

#3032

LAND LOCATED IN THE SE $\frac{1}{4}$
OF SECTION 1 AND IN THE NE $\frac{1}{4}$
OF SECTION 12 OF TINRIZE OF
WALWORTH CO., WISCONSIN.
NOV. 1955 LLOYD L. JENSEN
COUNTY SURVEYOR

