



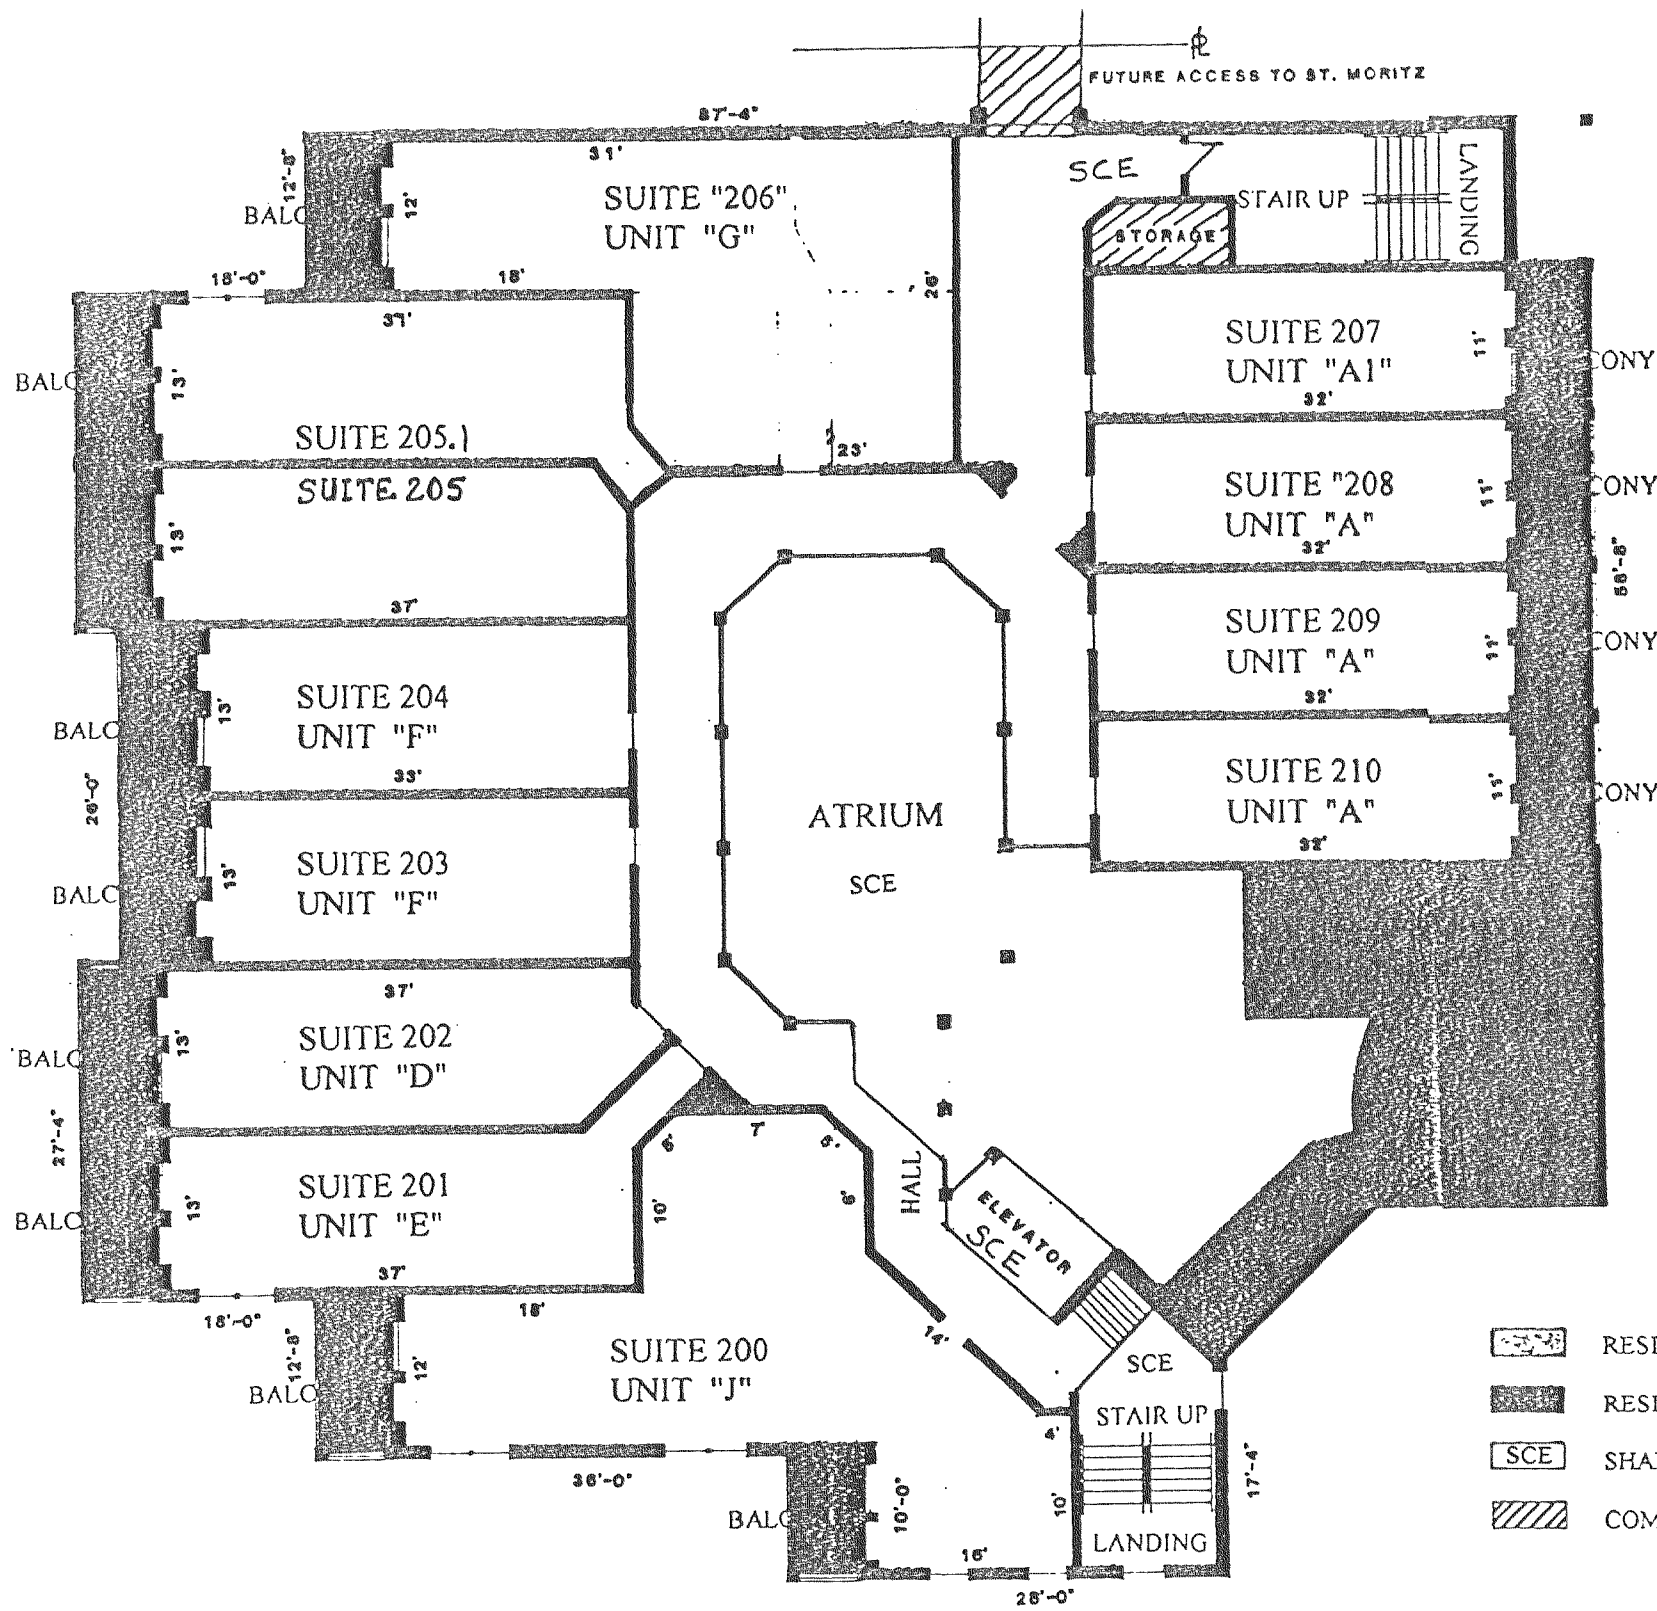 


THE MERIDIEN  
RESIDENTIAL  
CONDOMINIUM  
CITY OF LAKE GENEVA, WALWORTH COUNTY, WISCONSIN

SECOND FLOOR

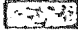

FLOOR PLANS & DIMENSIONS SHOWN ARE PROPOSED AS OF NOVEMBER 14, 1996 AND MAY NOT REFLECT AS-BUILT CONDITIONS.

-  RESIDENTIAL COMMON ELEMENT
-  RESIDENTIAL LIMITED COMMON ELEMENT
-  SHARED COMMON ELEMENTS
-  COMMERCIAL UNIT

REVISIONS :