


SEC. 18 - T 3N R 16E - SUGAR CREEK

SCALE - 1" = 400'

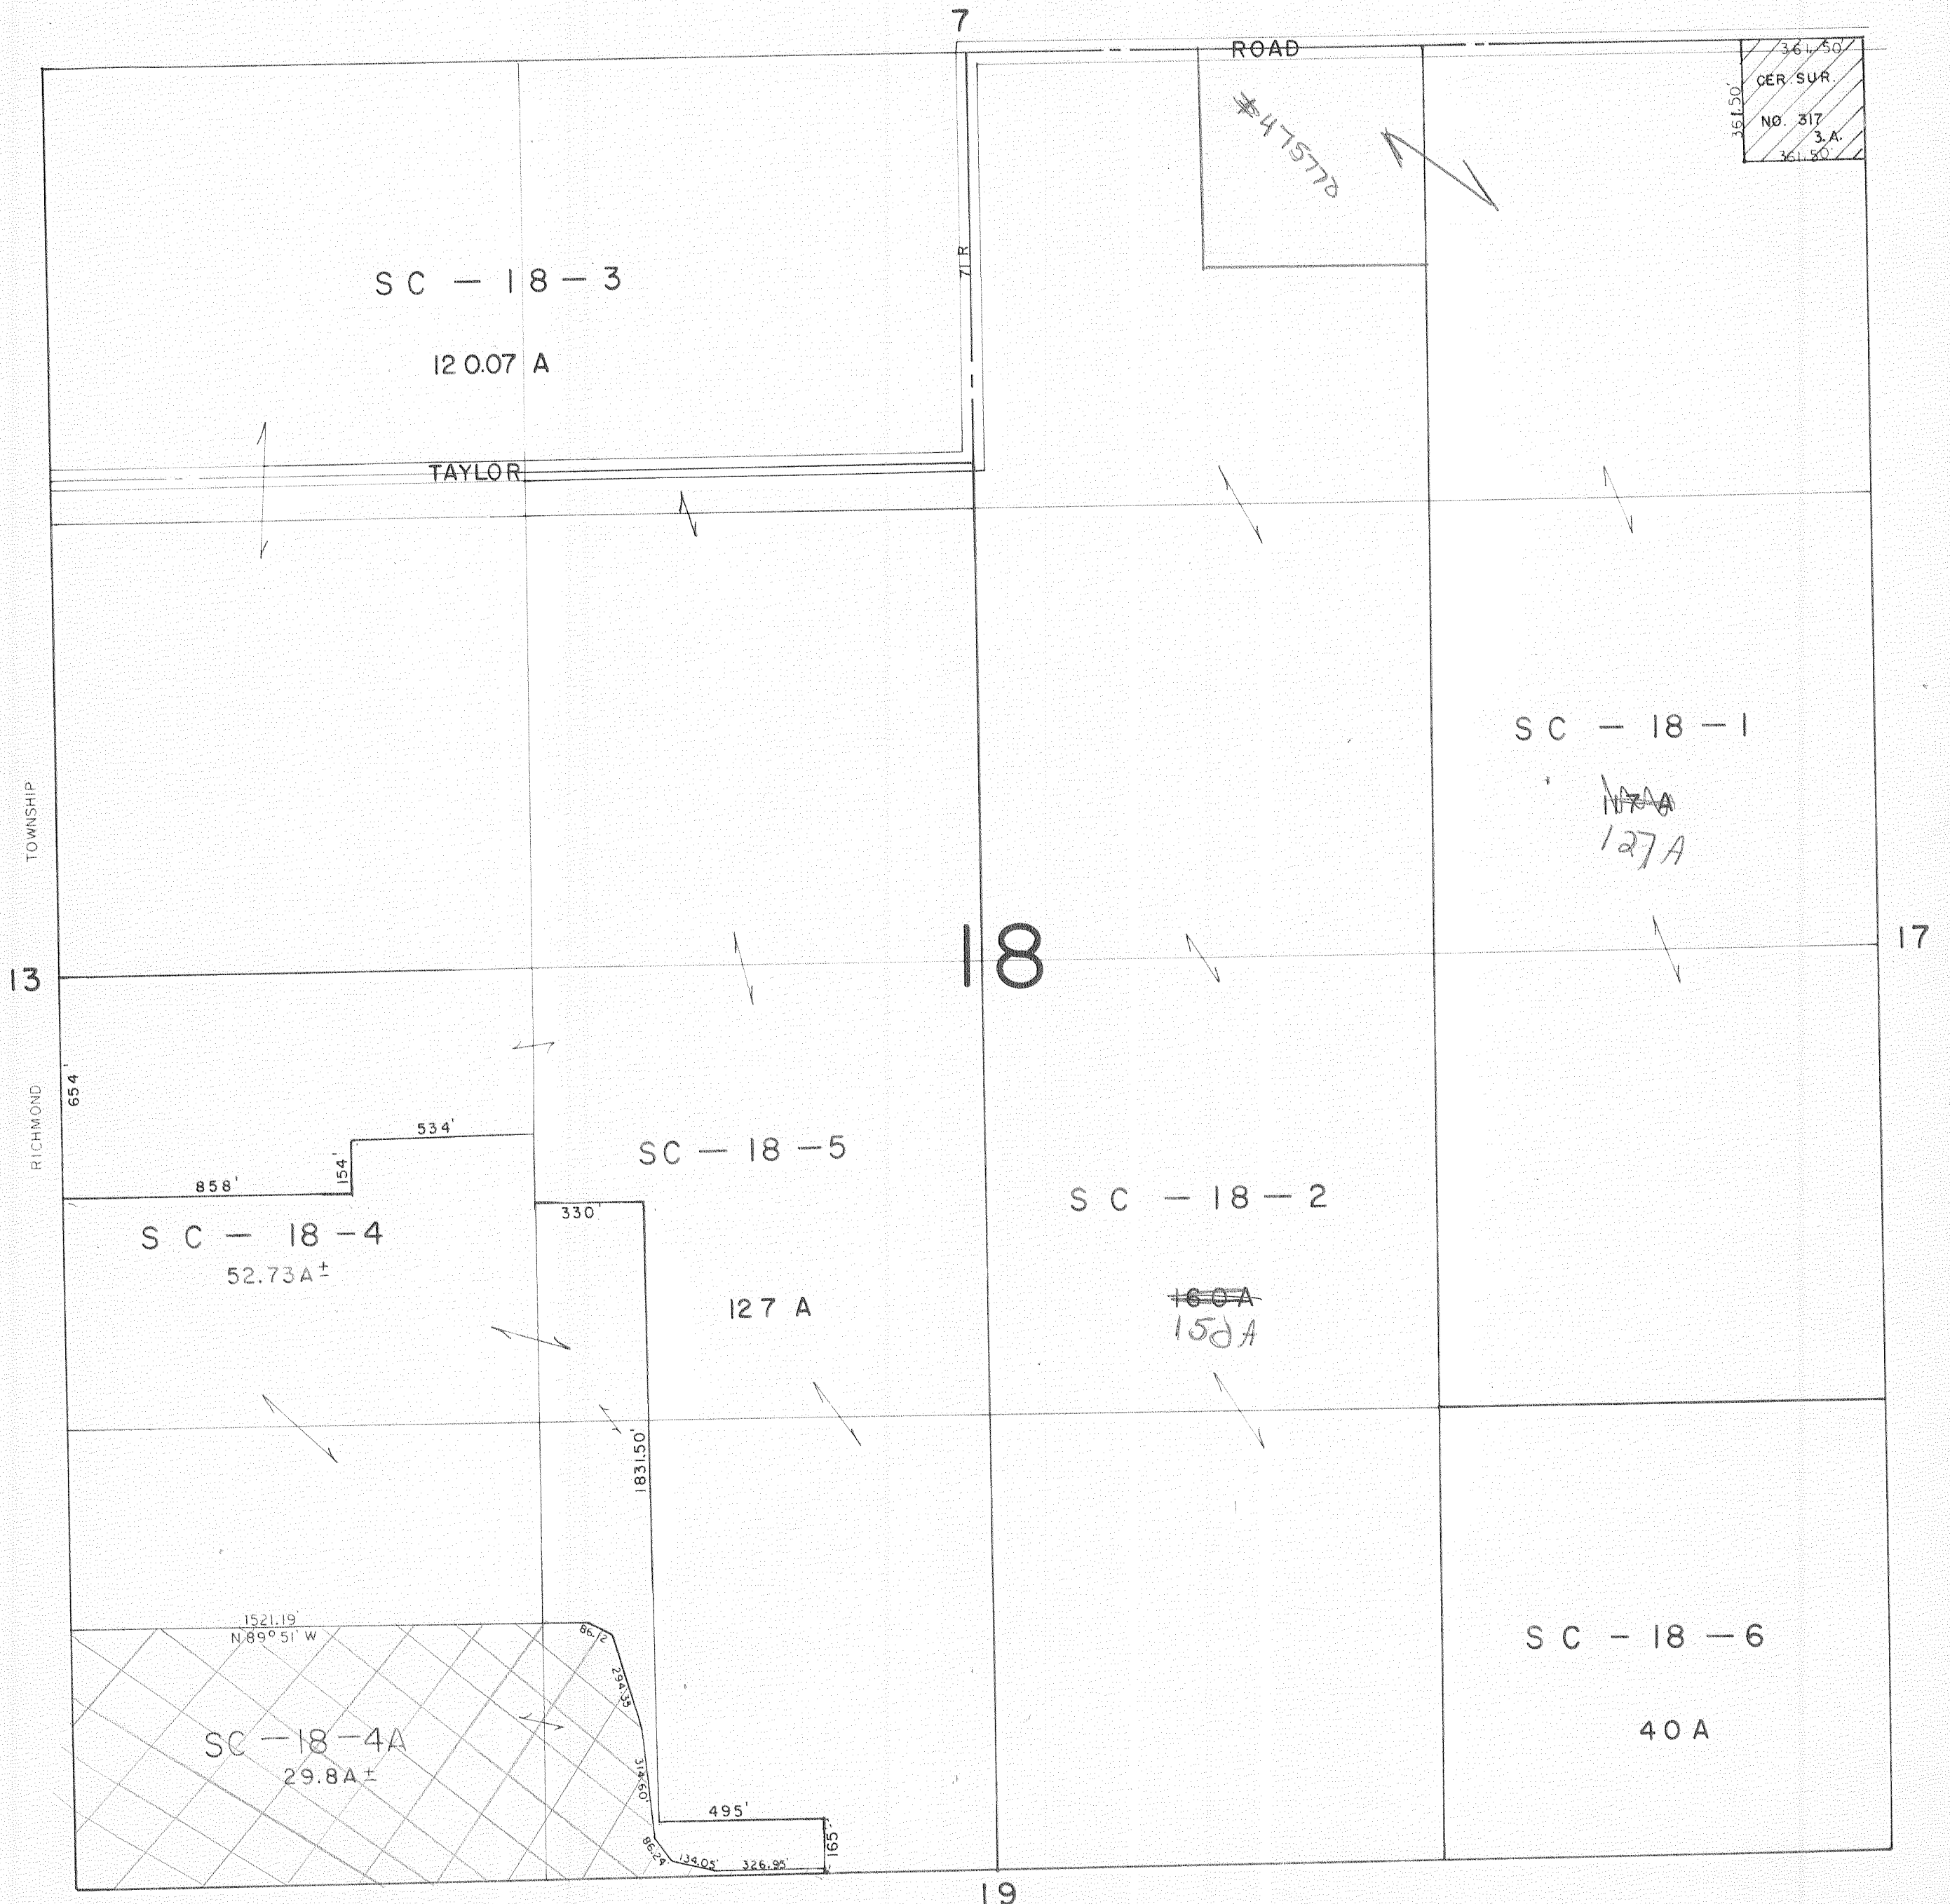

SC - 18 - 3

120.07 A

TAYLOR

ROAD

475770

CER. SUR.
NO. 317
3.A.
361.50'

SC - 18 - 1

~~177A~~
127A

18

17

13

TOWNSHIP

RICHMOND

654'

SC - 18 - 5

SC - 18 - 4

52.73 A±

858'

534'

154'

330'

127 A

SC - 18 - 2

~~160A~~
150A

SC - 18 - 6

40 A

SC - 18 - 4A

29.8 A±

1521.19
N 89° 51' W

1831.50'

495'

134.05' 326.95'

19