


DUNHAM SURVEYING, S.C.
SURVEYING & SUBDIVISION
DELAVER, WISCONSIN 53115

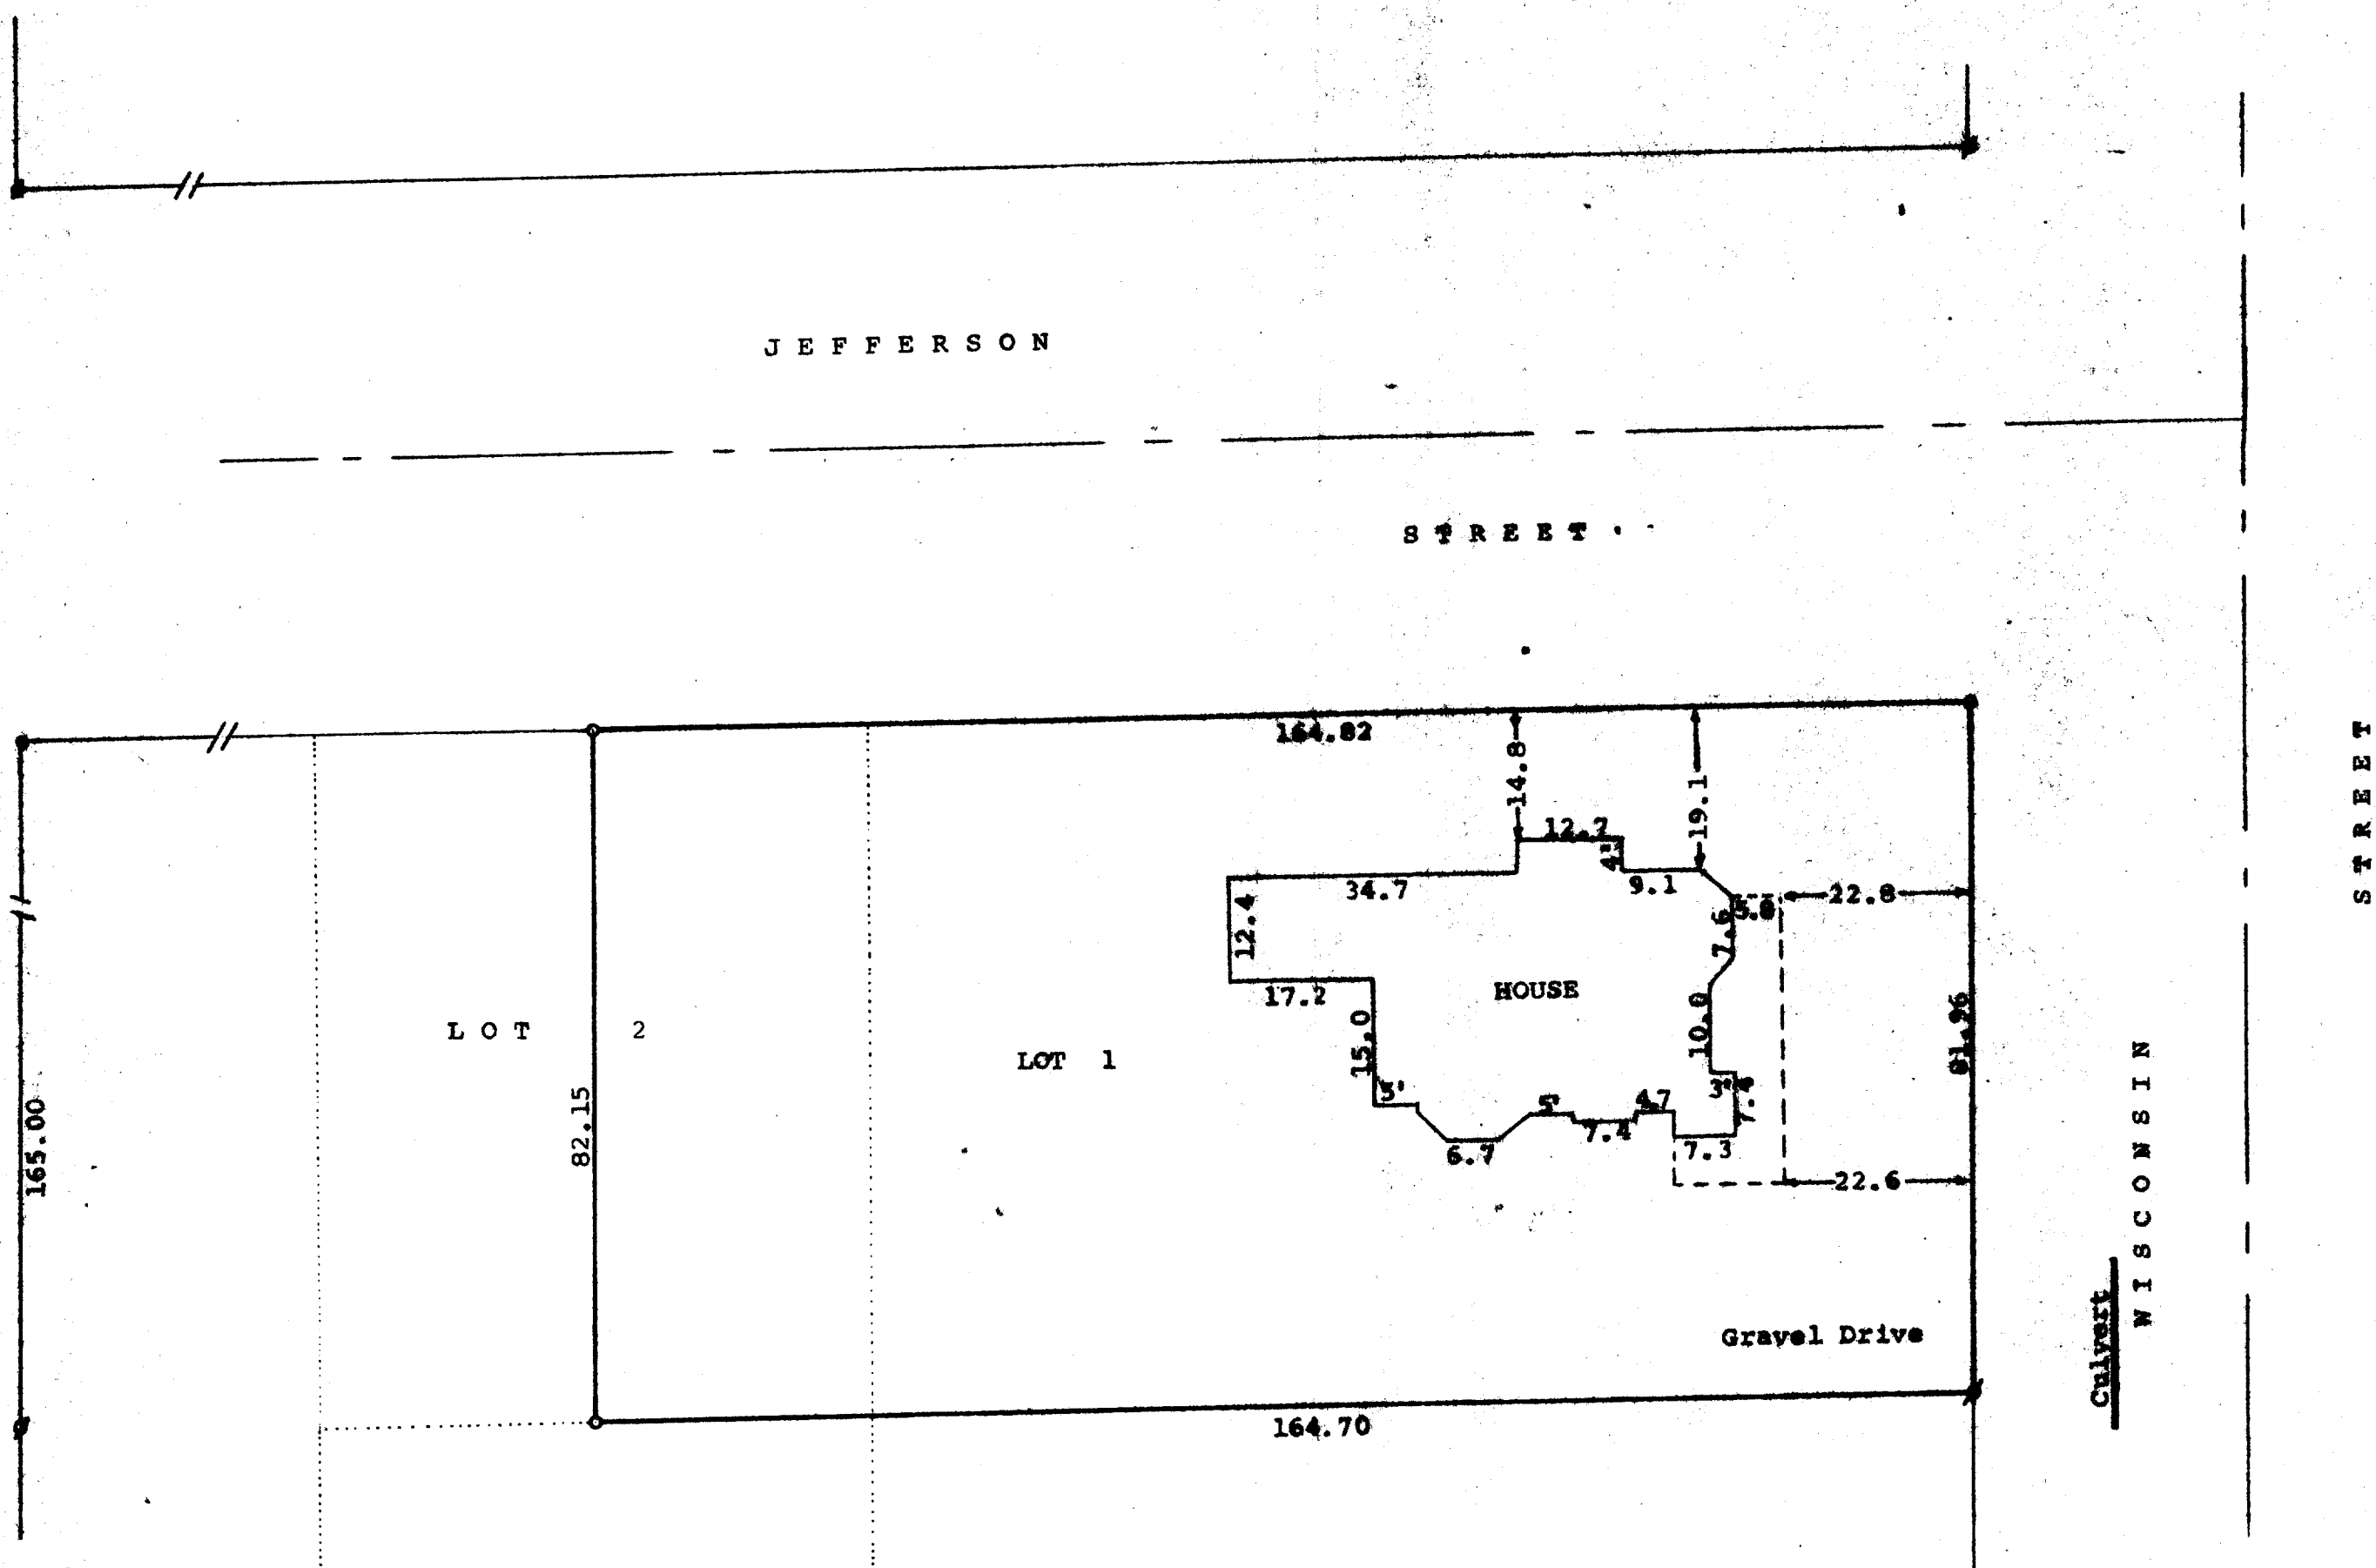

STATE OF WISCONSIN
COUNTY OF WAUKESHA

I, George T. Dunham, Surveyor, certify that I have surveyed the property described as follows:

Lot 1 and the East 1/4 of the North 1/4 of Lot 2, all in Block 18 of Stone and Toppings Addition to the Village of Delavan, Walworth County, Wisconsin.

and that the above map is a true representation thereof and shows the size and location of the property, its exterior boundaries, the location of all visible structures and dimensions of all principal buildings thereon, boundary lines, apparent easements, roadways and visible encroachments, if any.

This survey is made for the use of the present owners of the property, and also those who purchase, mortgage, or guarantee the title thereto within one (1) year from date hereof.
December 28, 1981

George T. Dunham
George T. Dunham, Surveyor

Scale - 1" = 20'
Ø = Iron Pipe Found
○ = Iron Pipe Set

